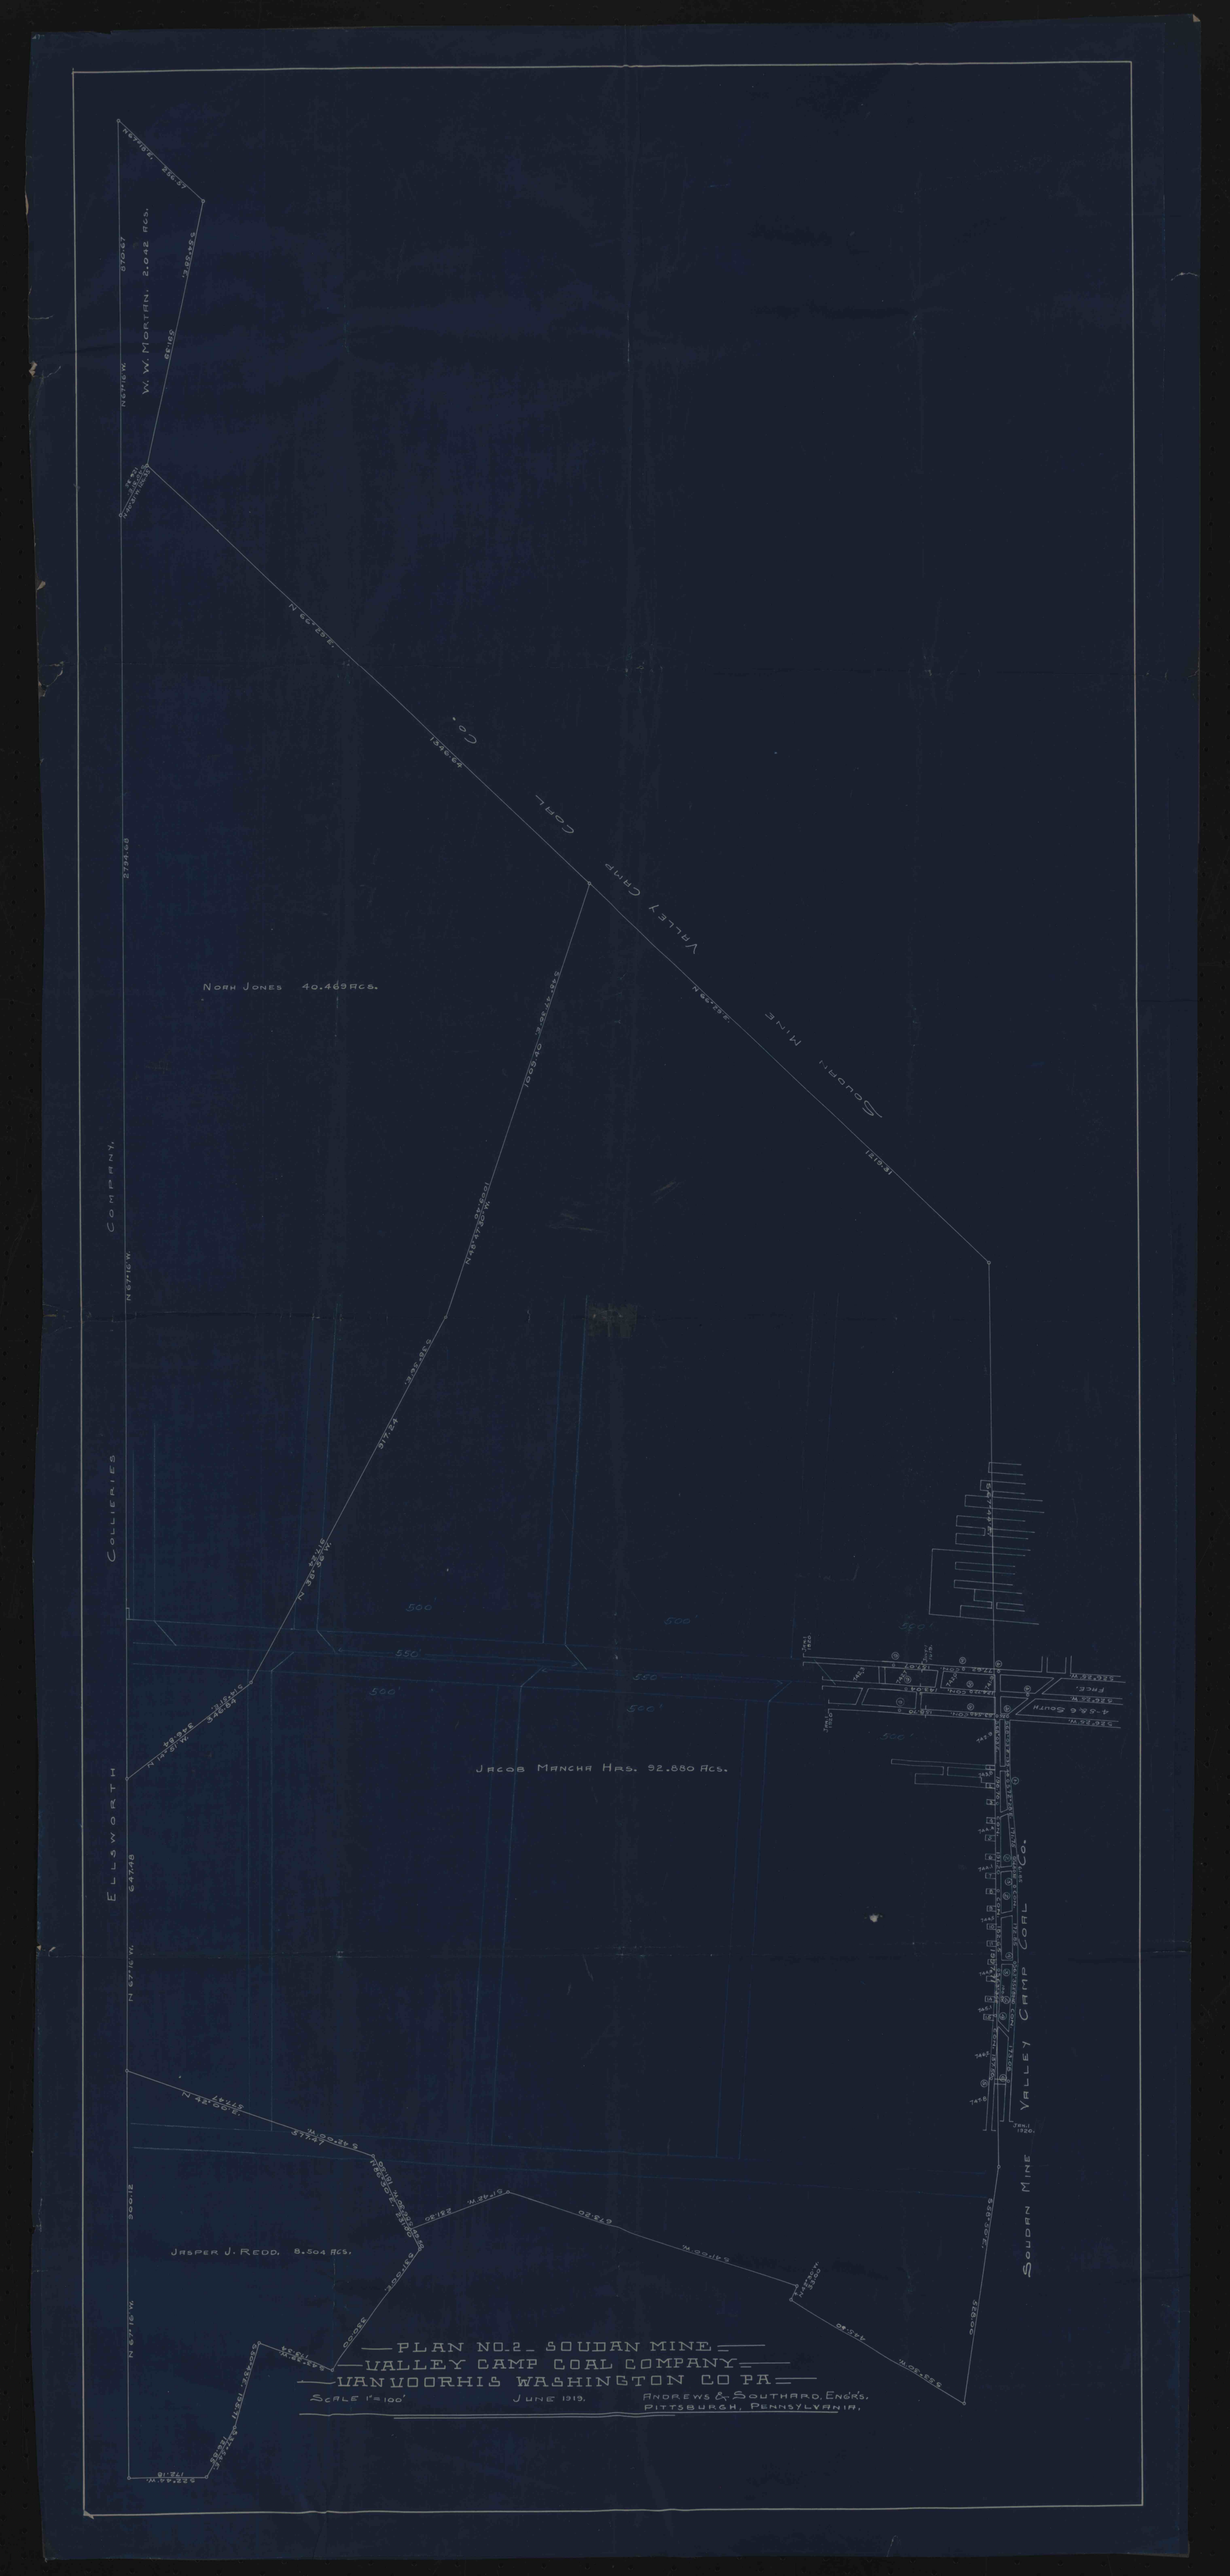
W. W. Morton. 2.042 Acs.
North Jones 40.469 Acs.
Valley Camp Coal Co.
Sudan Mine
Jacob Mancha Hrs. 92.880 Acs.
Jasper J. Redd. 8.504 Acs.
Ellsworth Collieries Company
Sudan Mine Valley Camp Coal Co.
PLAN NO. 2 SUDAN MINE
VALLEY CAMP COAL COMPANY
VANVOORHIS WASHINGTON CO PA
SCALE 1" = 100' JUNE 1919. ANDREWS & SOUTHARD, ENGR'S. PITTSBURGH, PENNSYLVANIA.