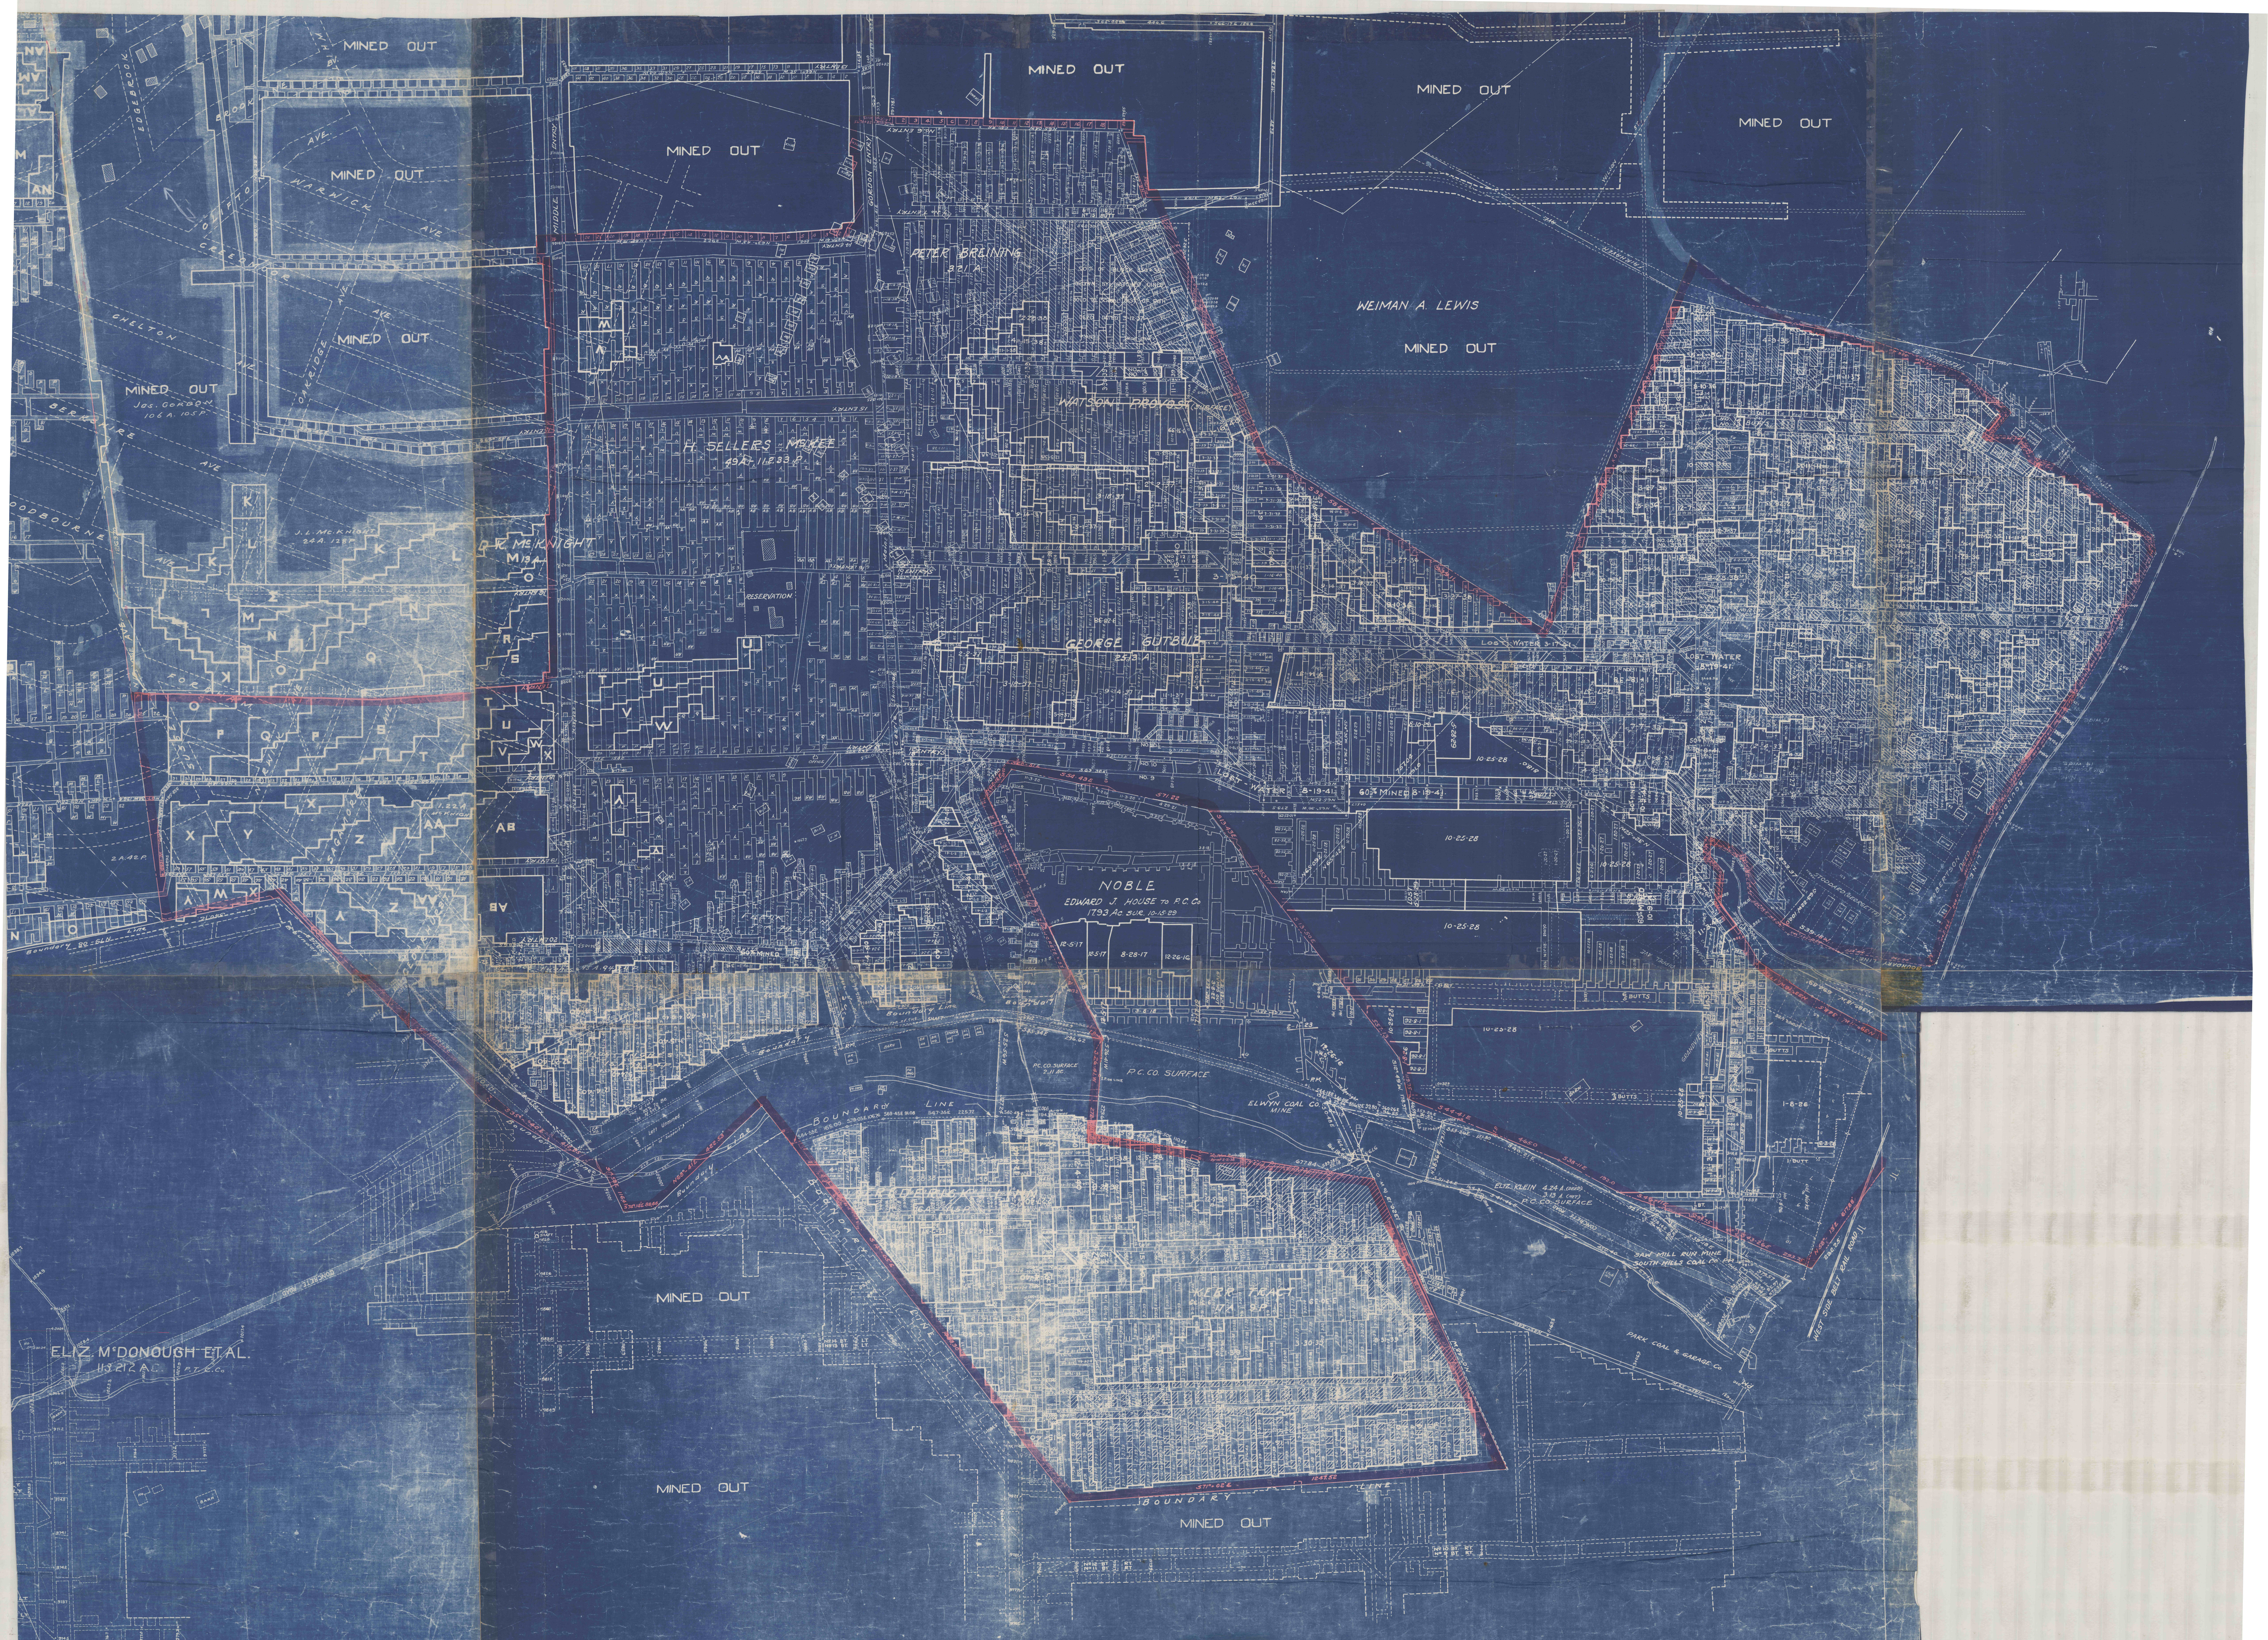
MINED OUT
MINED OUT
MINED OUT
MINED OUT
MINED OUT
MINED OUT
MINED OUT
Jas. GORDON
106 A. 105 P.
EDGEBROOK
BROOKLINE BV.
WARWICK AVE.
CLIFTON AVE.
CREEDMOOR AVE.
CHELTON AVE.
OAKRIDGE AVE.
BERKSHIRE AVE.
WOODBOURNE AVE.
J. L. McKNIGHT
24 A. 128 P.
R. W. McKNIGHT
MIDDLE ENTRY
GORDON ENTRY
PETER BREINING
32 A.
H. SELLERS McKEE
49 A. 11.2.33 P.
RESERVATION
WATSON PROVOST (SURFACE)
GEORGE GUTBUB
25.3 A.
WEIMAN A. LEWIS
MINED OUT
MINED OUT
MINED OUT
LOST WATER 3-17-41
LOST WATER 8-19-41
LOST WATER 8-19-41
60% MINED 8-19-41
NOBLE
EDWARD J. HOUSE to P. C. Co
17.93 Ac. SUR. 10-15-29
12-5-17
12-5-17
8-28-17
12-26-16
10-25-28
10-25-28
10-25-28
10-25-28
1-8-26
BUTTS
BUTTS
BOUNDARY LINE
STODDARD (GEORGETTE) ST.
ROBERTSON
P. C. CO. SURFACE
2.11 AC.
P. C. CO. SURFACE
ELWYN COAL CO. MINE
ELIZ. KLEIN 4.24 A. (DEED)
3.13 A. (NET)
P. C. CO. SURFACE
SAW MILL RUN MINE
SOUTH HILLS COAL CO.
PARK COAL & GARAGE CO.
WEST SIDE BELT RAIL ROAD
KERR TRACT
Boundary Line
BOUNDARY LINE
CONCRETE ROAD
MINED OUT
MINED OUT
MINED OUT
ELIZ. McDONOUGH ET AL.
113.21.2 AC.
No 10 BT. RT.
No 9 BT. RT.

PITTSBURGH COAL COMPANY
PLAN SHOWING

SOUTH HILLS MINE

SITUATE IN

CITY OF PITTSBURGH AND BALDWIN TOWNSHIP
ALLEGHENY COUNTY, PA.

0 100 200 300 400 500
SCALE IN FEET

I hereby certify this is a true and correct copy of the mine workings as of Nov. 15, 1941.

F. S. Follansbee chief Engineer.
F. S. FOLLANSBEE.