


STERN COAL CO.

MINED OUT AREA

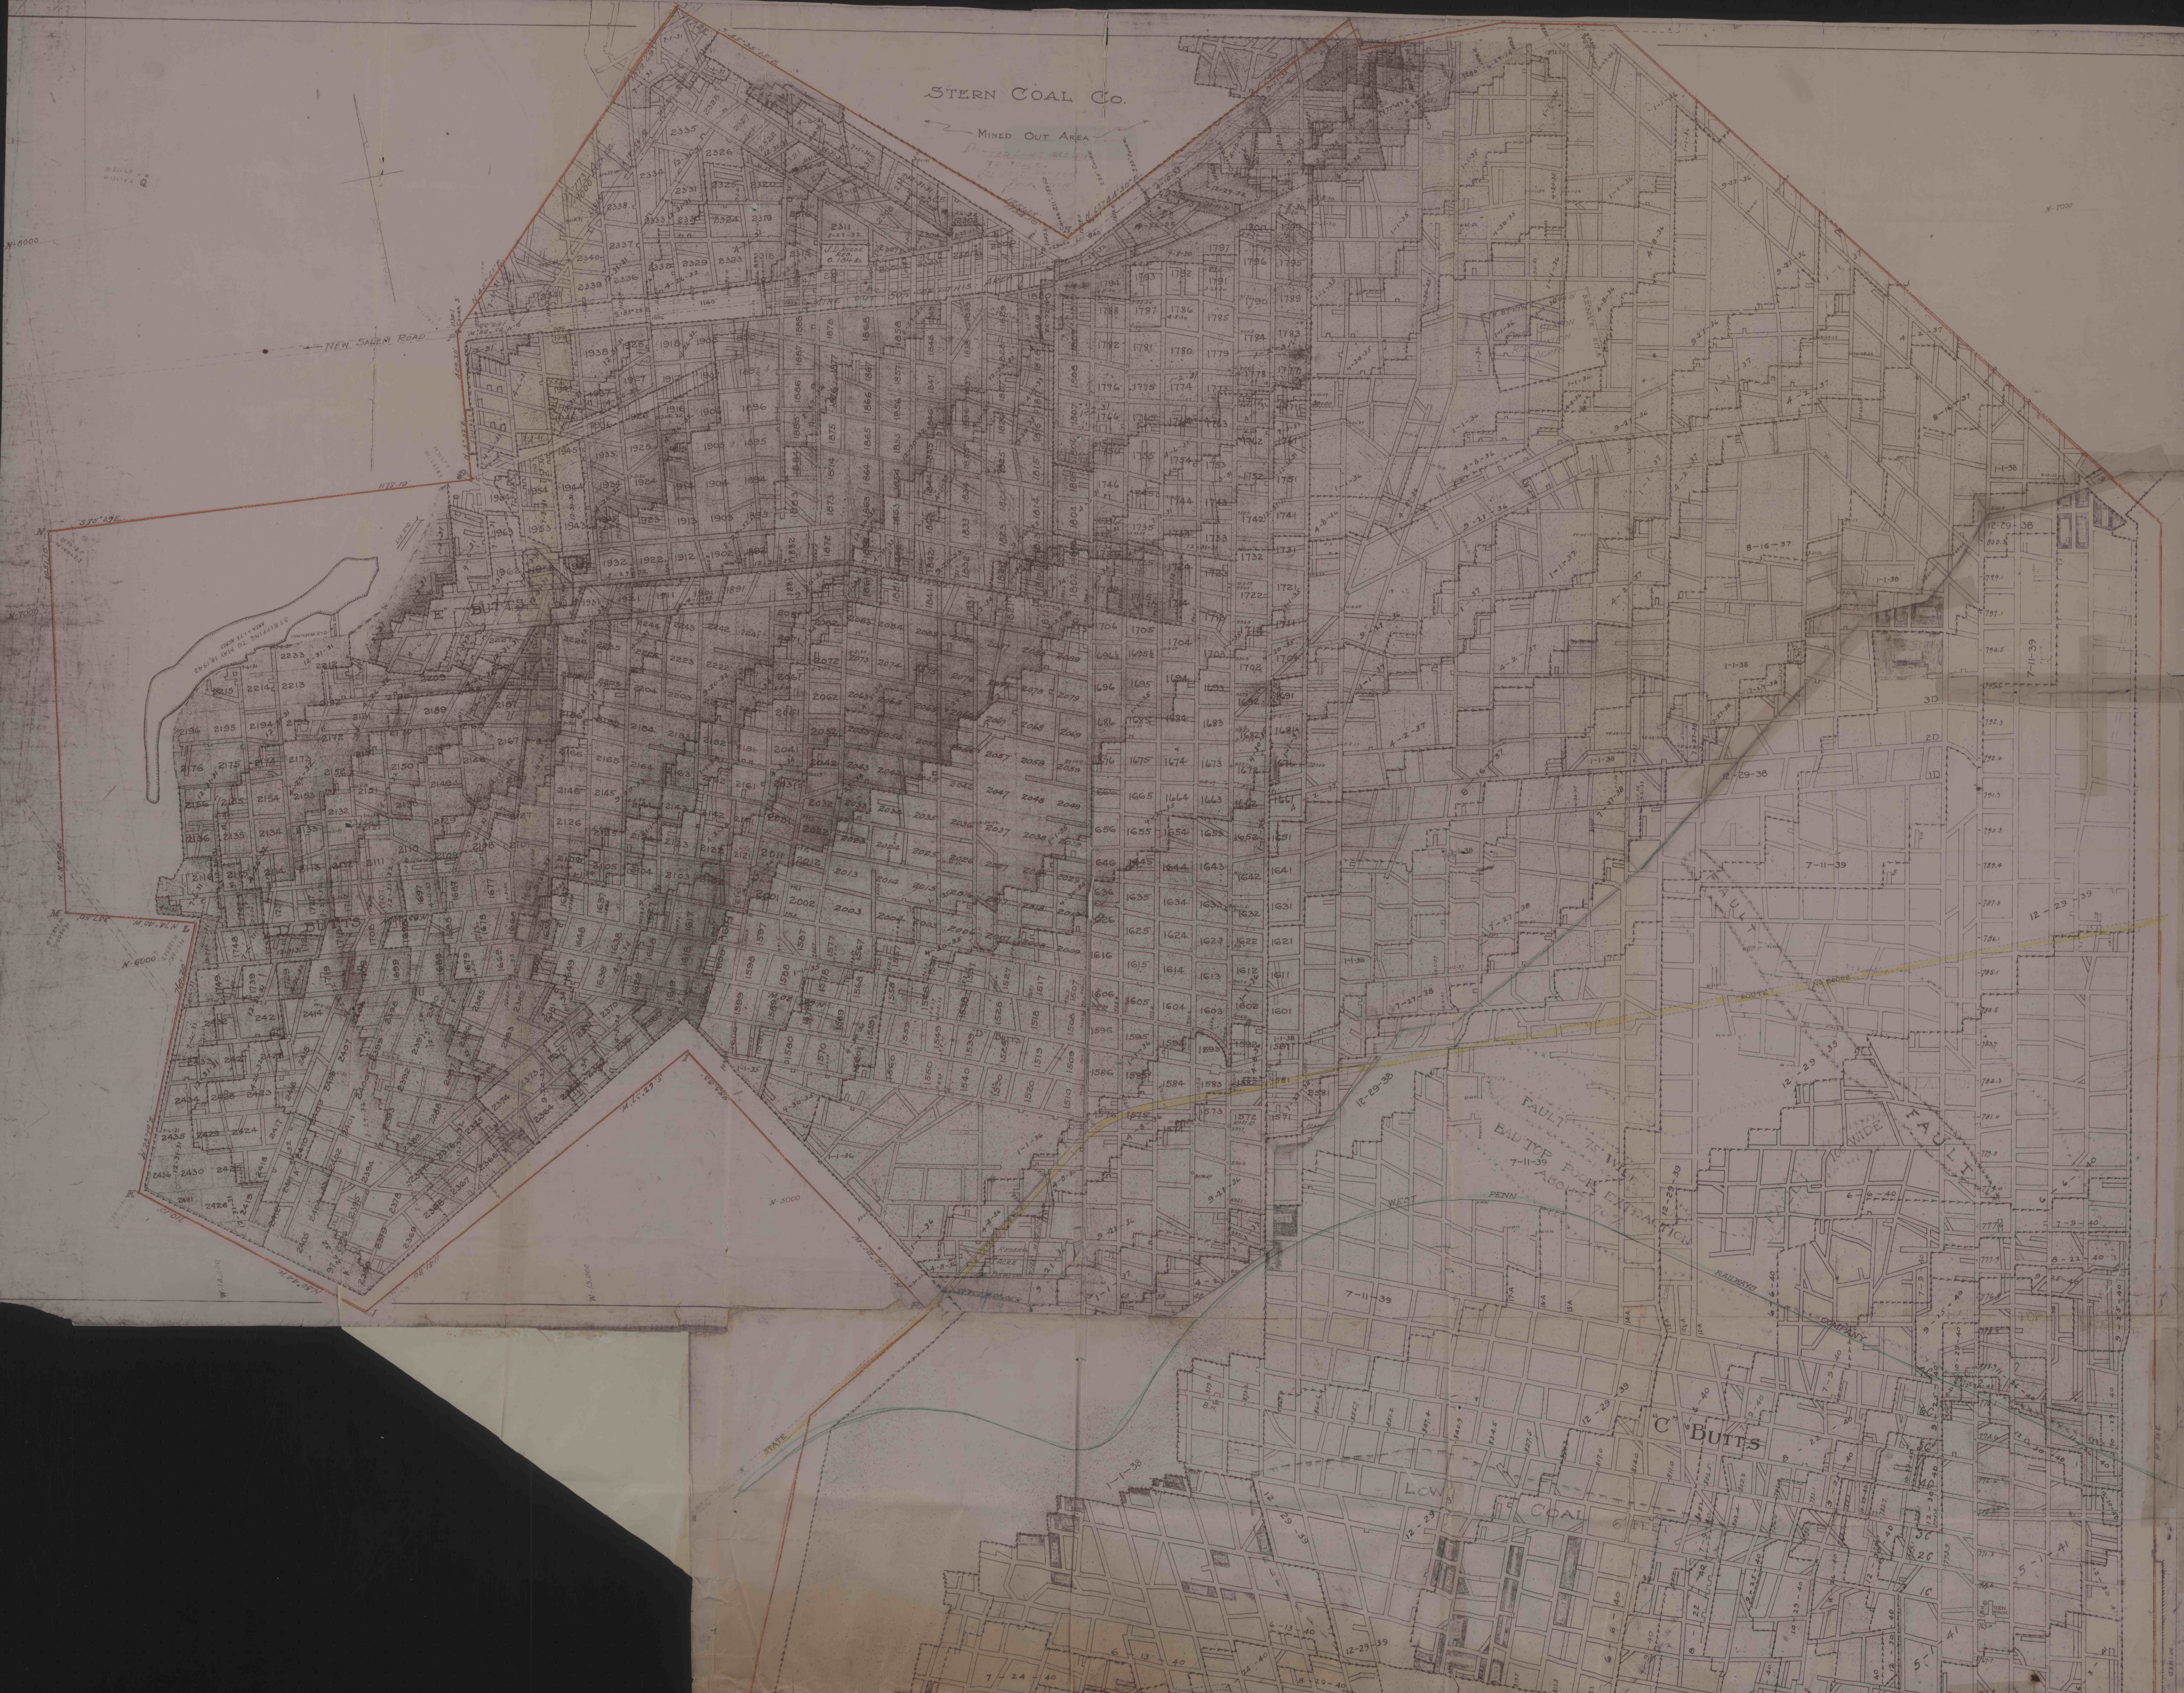

N-6000

375-295

N-7000

M-6000

N-5000

N-7000

C Butts

LOW COAL

FAULT

BAD TOE PICK EXTRACTION

7-11-39

PENN

7-11-39

7-11-39

