


EAST END OF  
SOUTH UNION MINE  
SCALE: 1"=100'

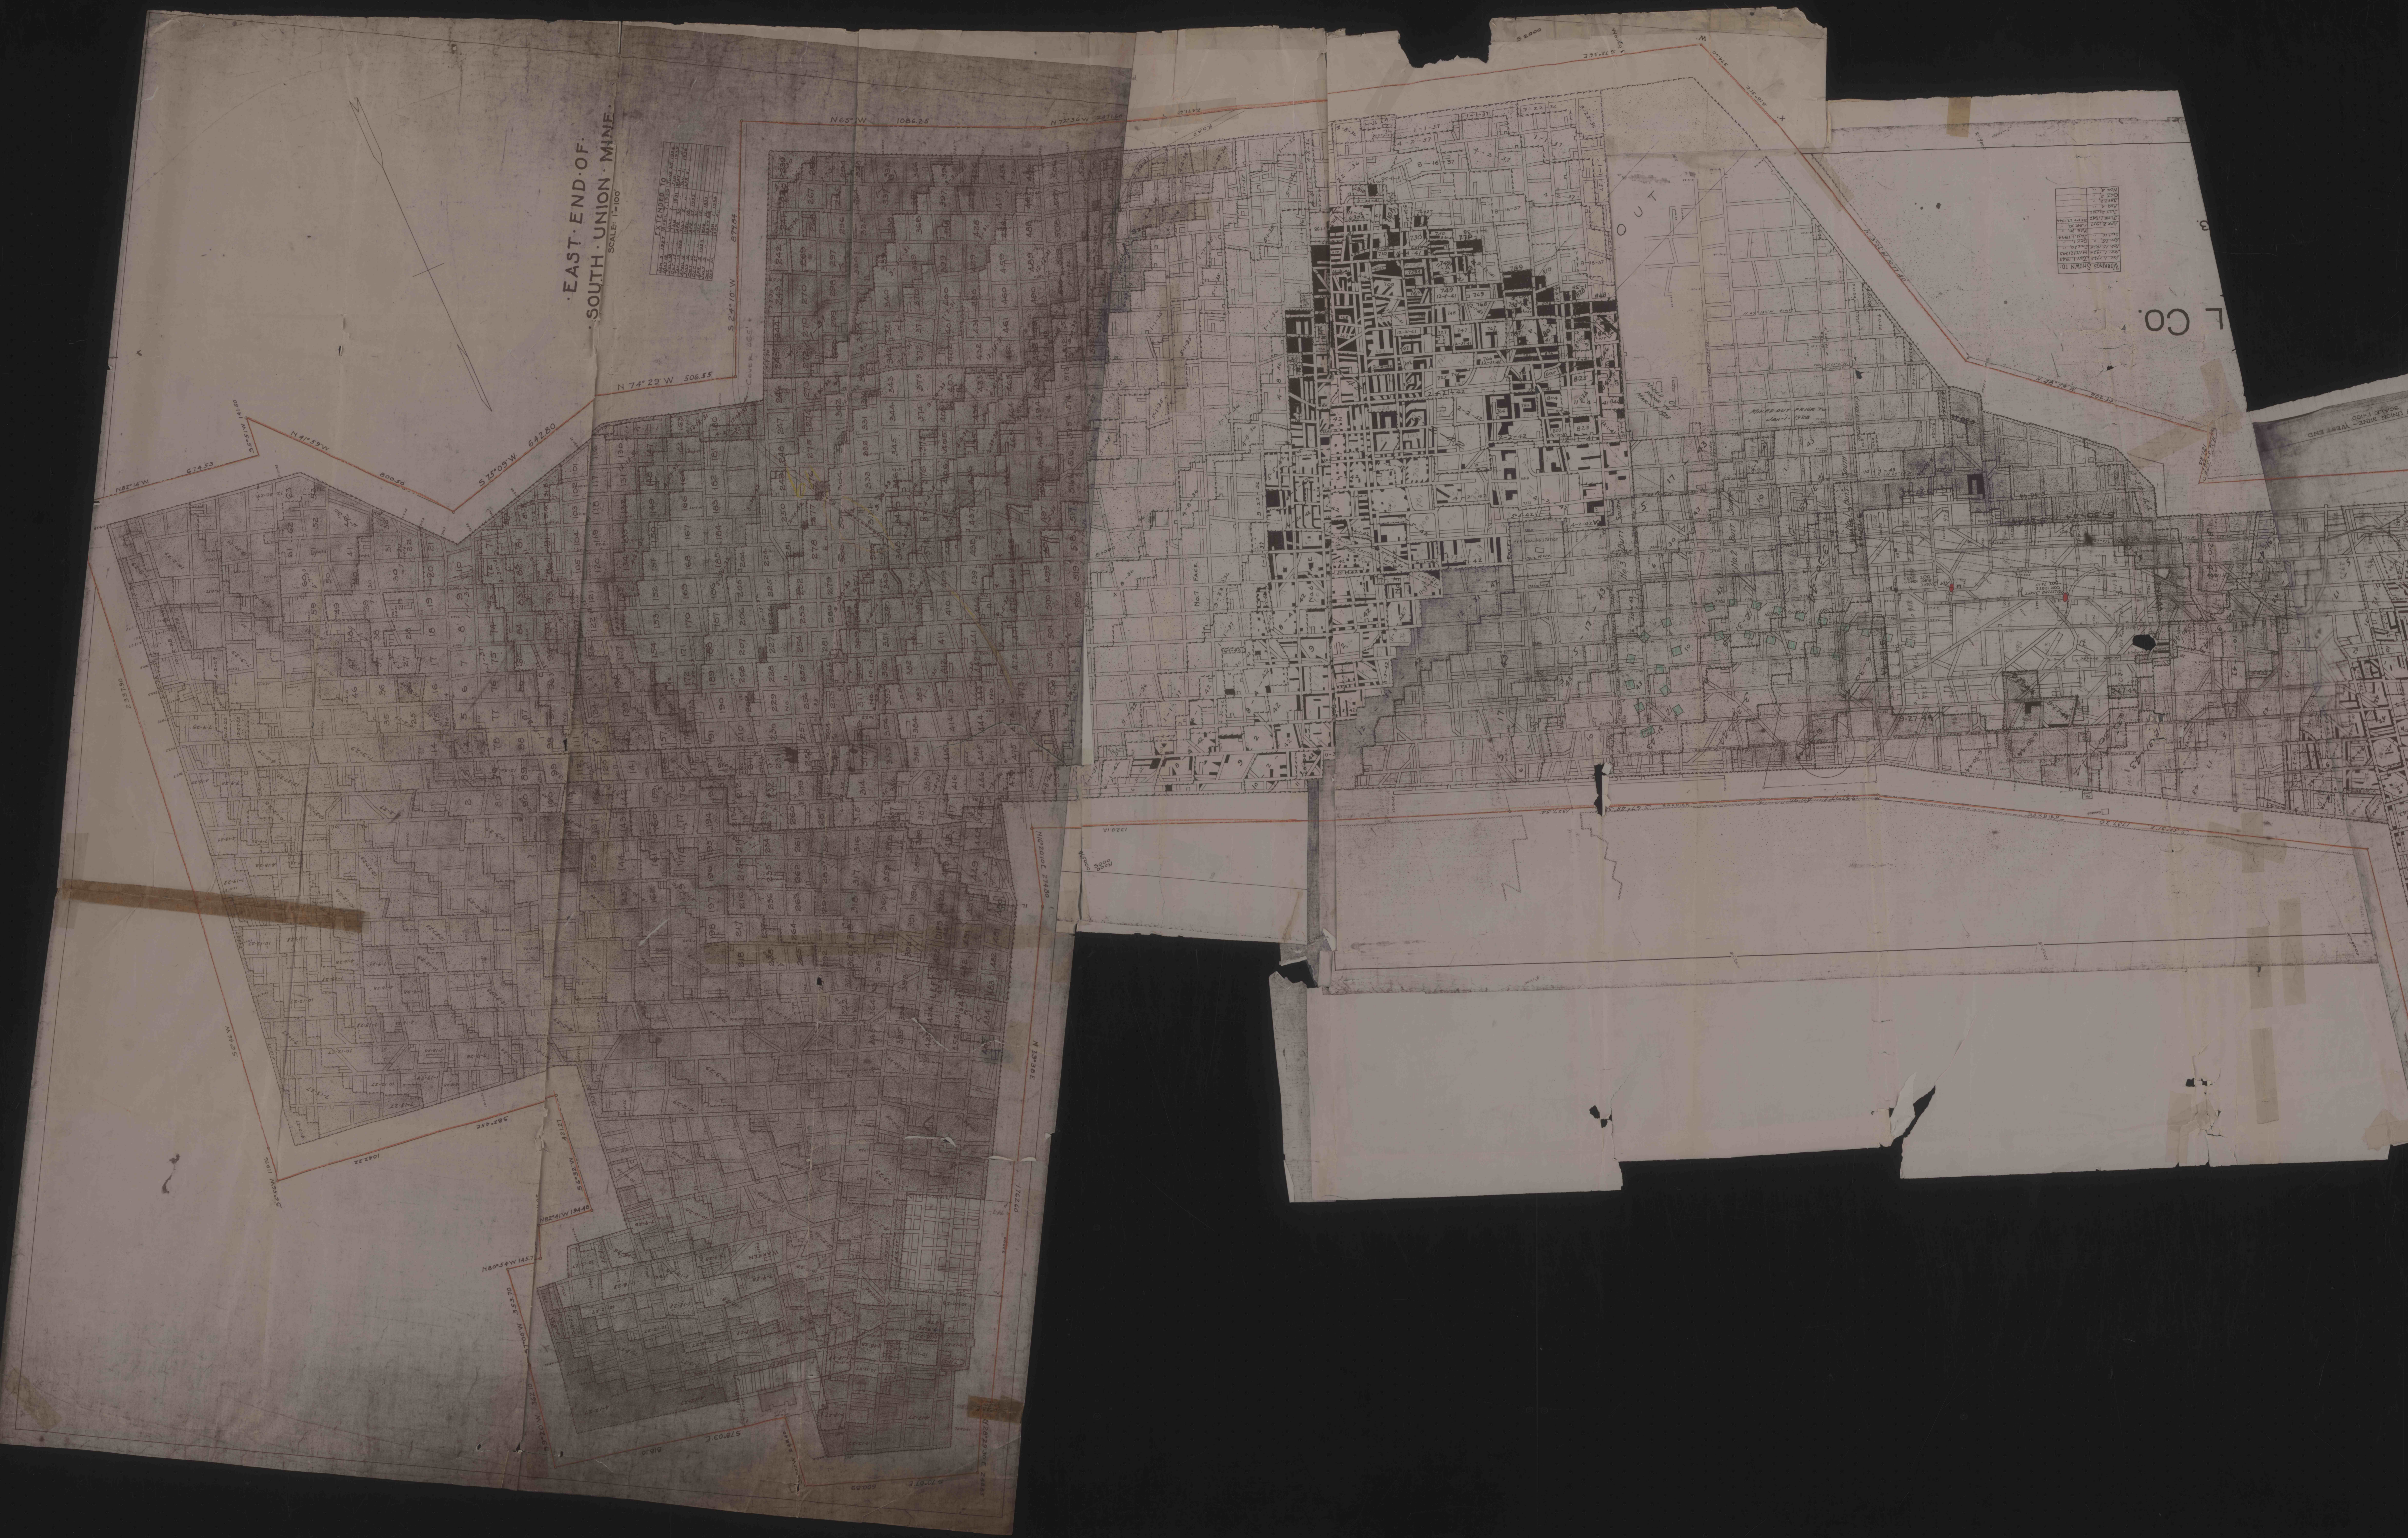

L. CO.