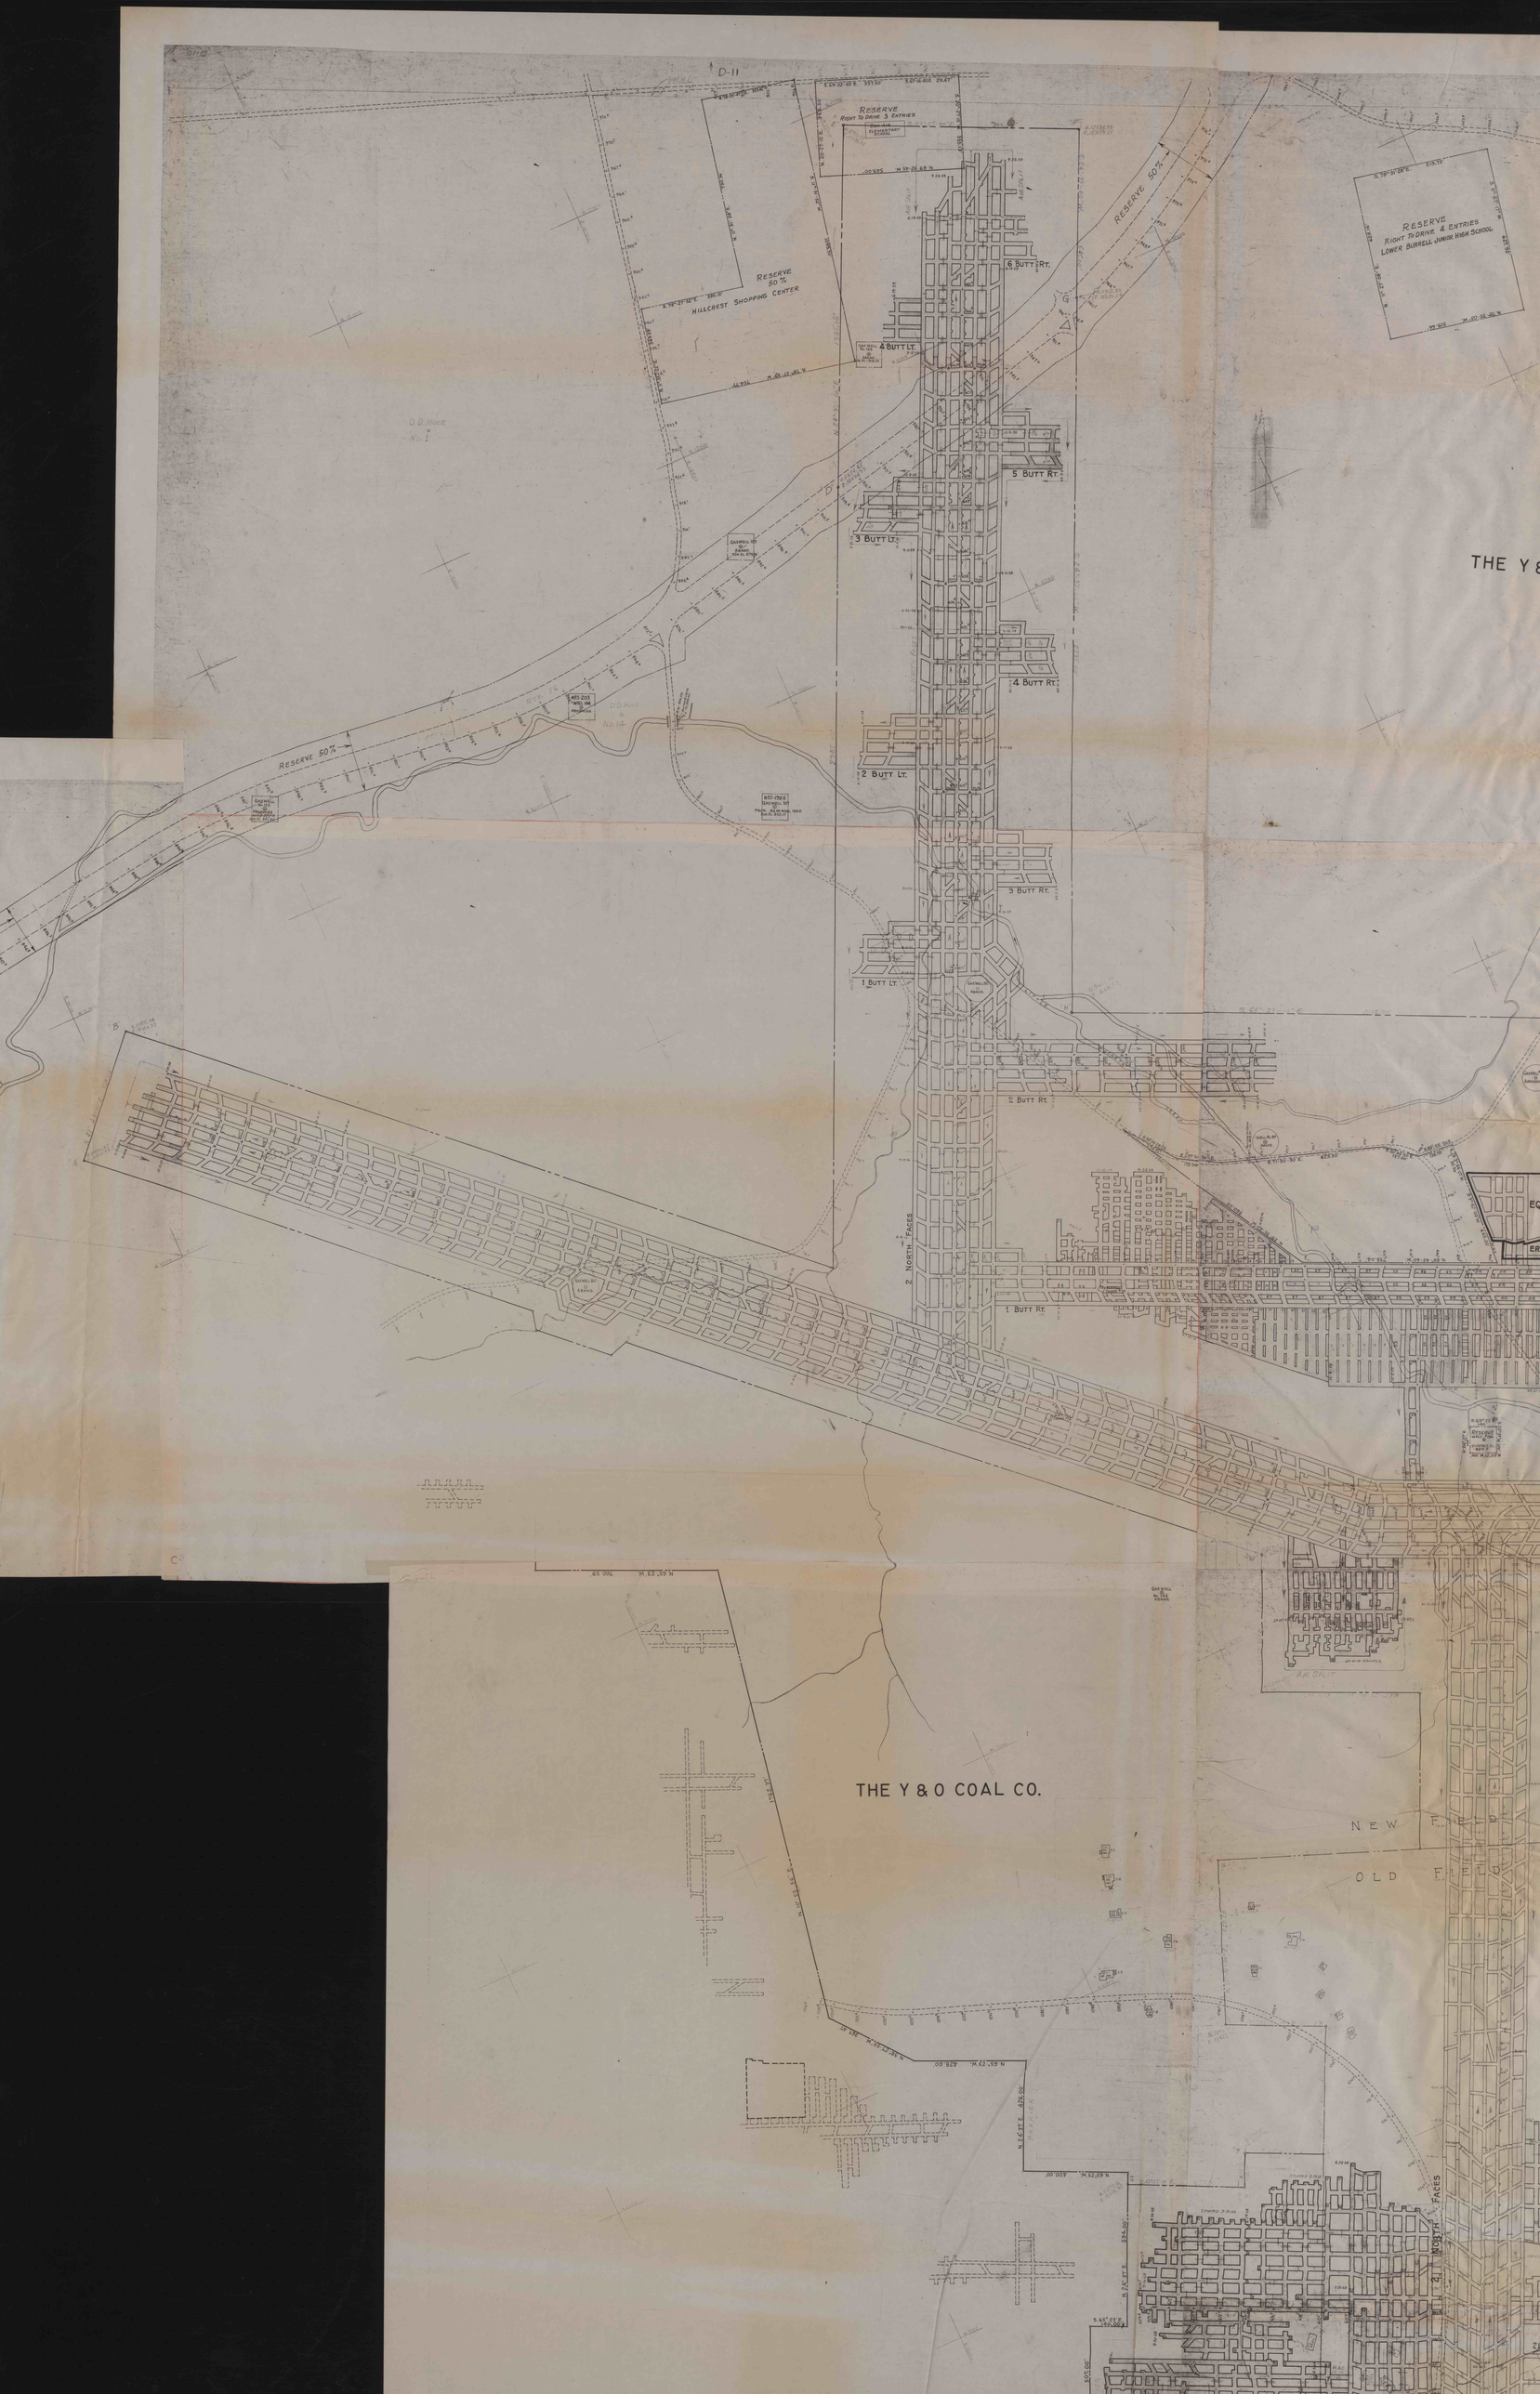

D-11
RESERVE
RIGHT TO DRIVE 3 ENTRIES
RESERVE 50%
HILLCREST SHOPPING CENTER
RESERVE 50%
RESERVE
RIGHT TO DRIVE 4 ENTRIES
LOWER BURRELL JUNIOR HIGH SCHOOL
6 BUTT RT.
4 BUTT LT.
5 BUTT RT.
3 BUTT LT.
4 BUTT RT.
2 BUTT LT.
3 BUTT RT.
1 BUTT LT.
2 BUTT RT.
1 BUTT RT.
2 NORTH FACES
THE Y &
THE Y & O COAL CO.
NEW FIELD
OLD FIELD
NORTH FACES