MATCH L-3

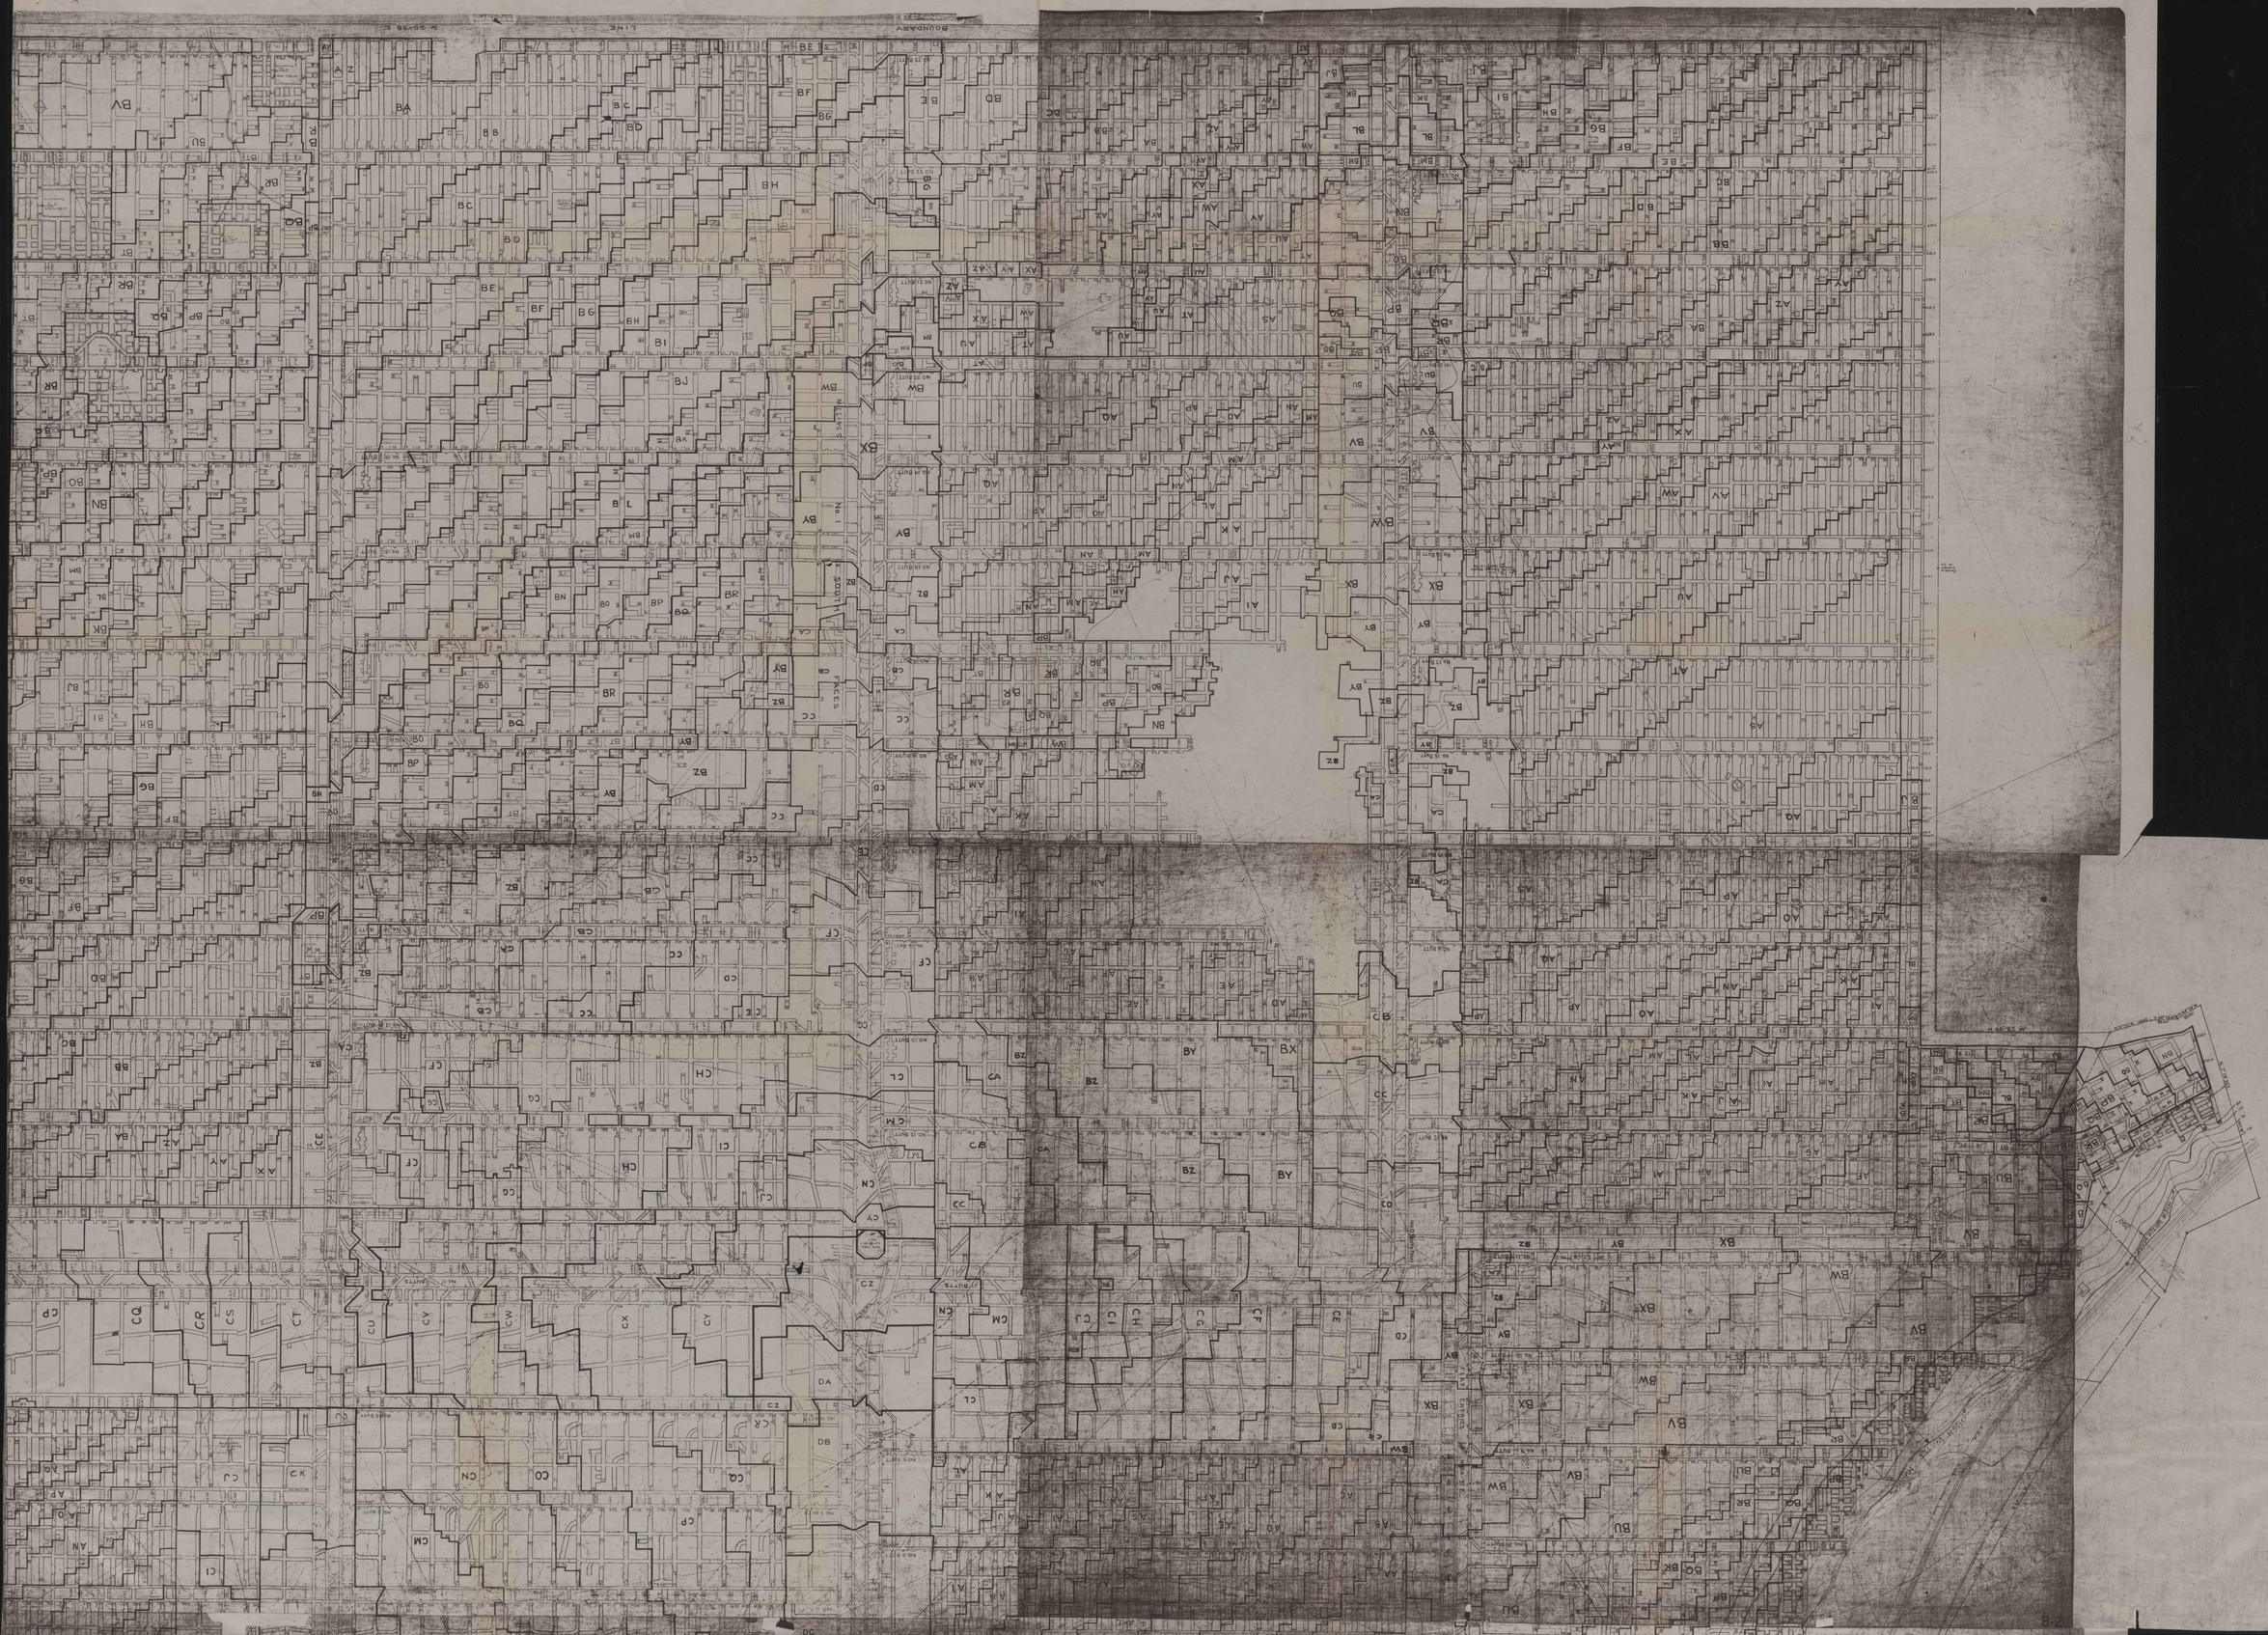
BOUNDARY LINE
No 1 SOUTH FACES
No 2 SOUTH FACES
No 3 SOUTH FACES
No 4 SOUTH FACES
No 5 SOUTH FACES
No 6 SOUTH FACES
No 7 SOUTH FACES
No 8 SOUTH FACES
No 9 SOUTH FACES
No 10 SOUTH FACES
No