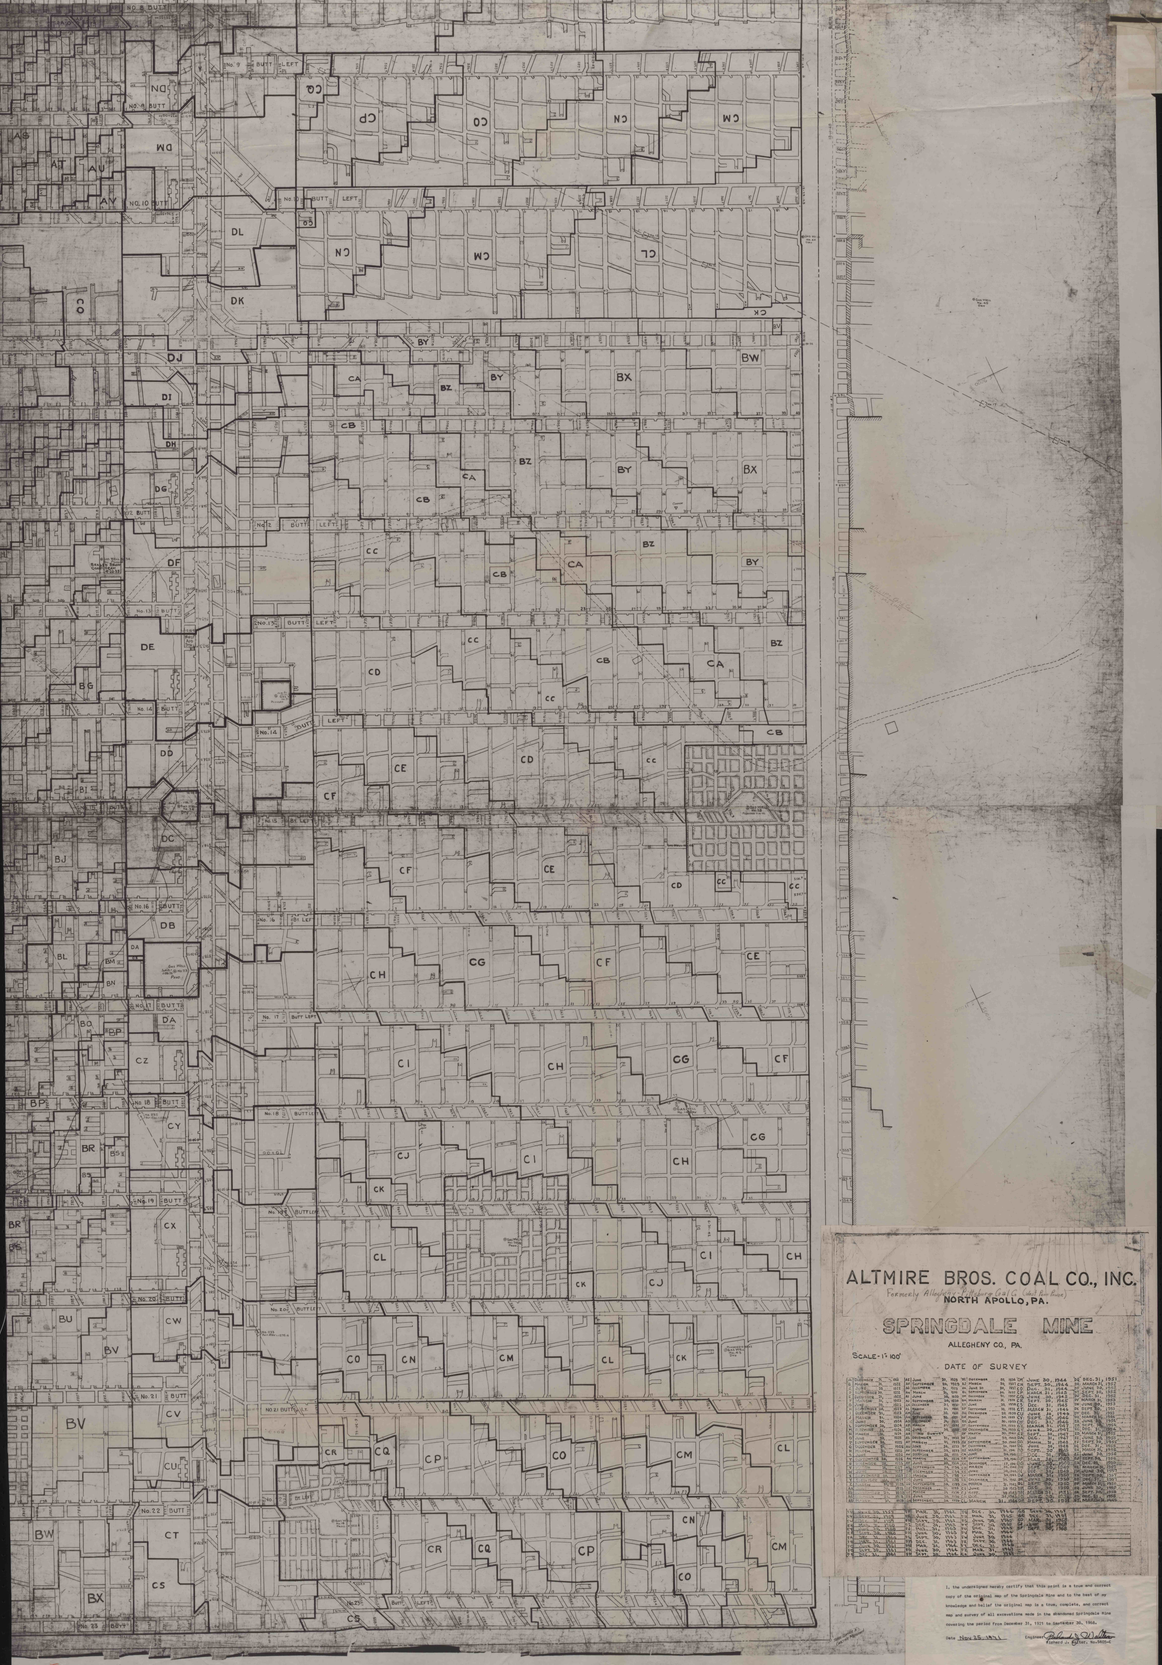

ALTMIRE BROS. COAL CO., INC.
NORTH APOLLO, PA.
SPRINGDALE MINE
ALLEGHENY CO., PA.
SCALE-1"=100'
DATE OF SURVEY