


A L L E G H E N Y R I V E R

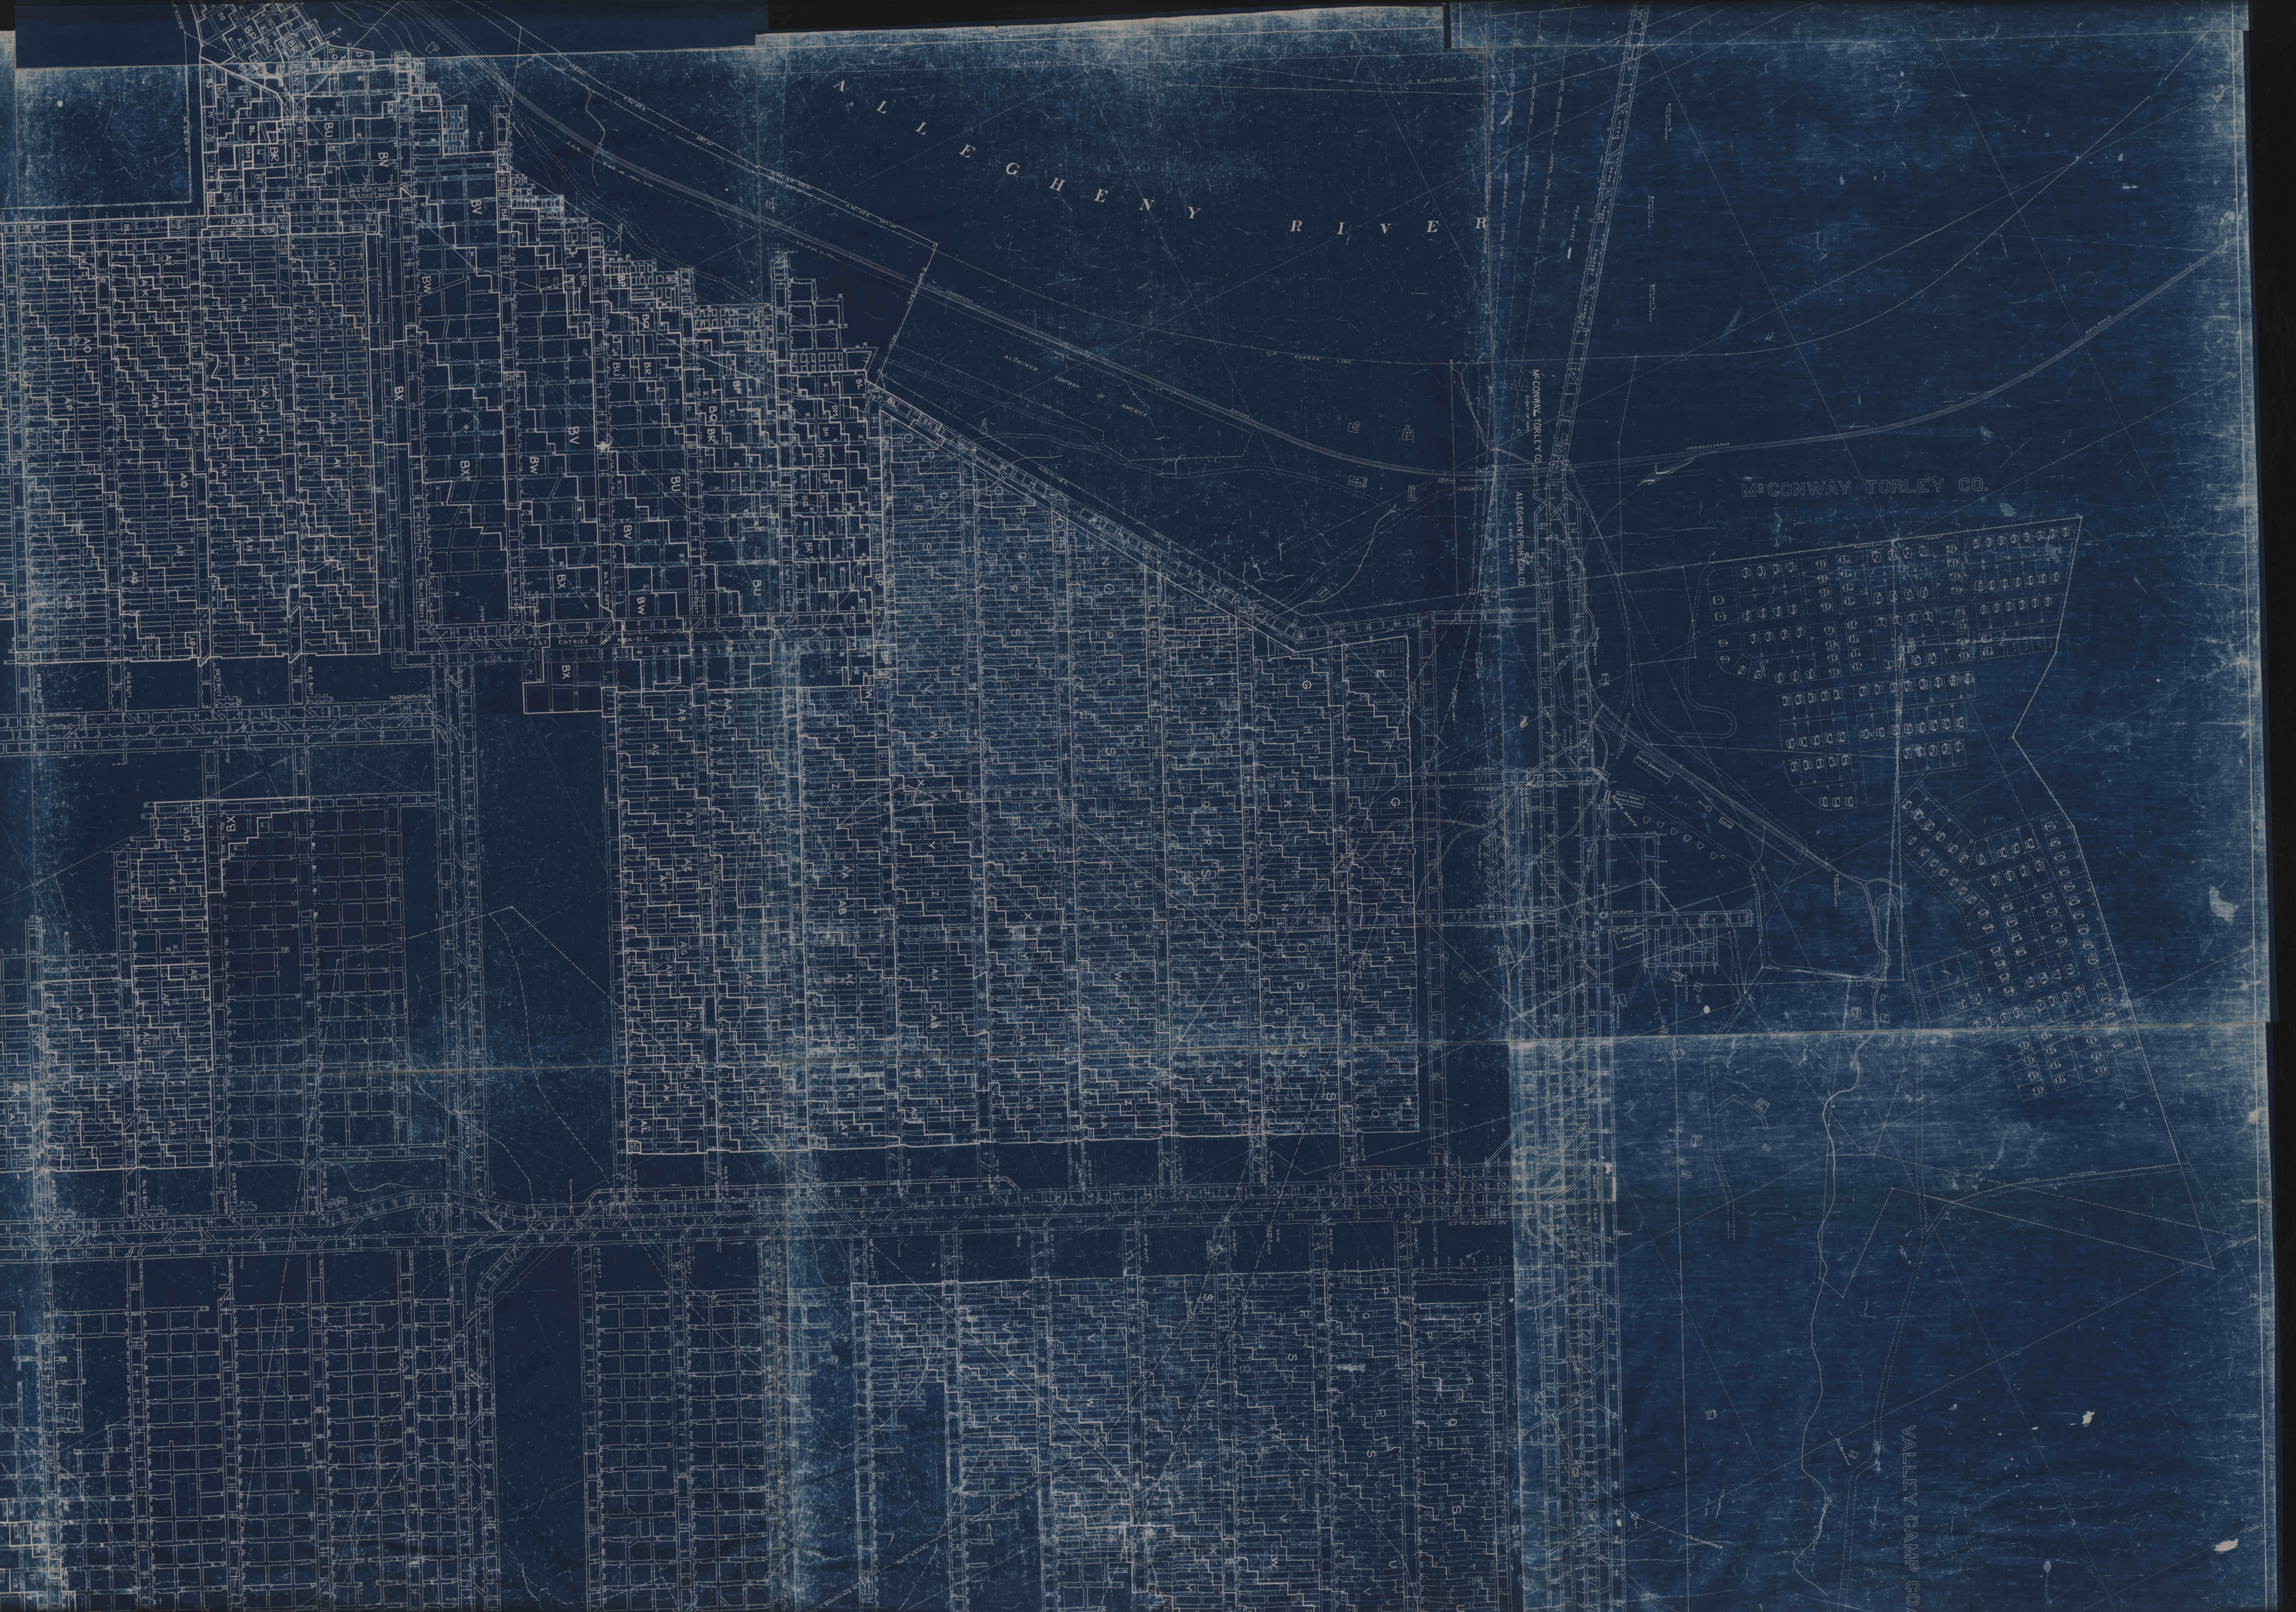

McGONWAY TORLEY CO.

McGONWAY TORLEY CO.

ALLEGHENY PORTLAND CO.

VALLEY CAMP CO.