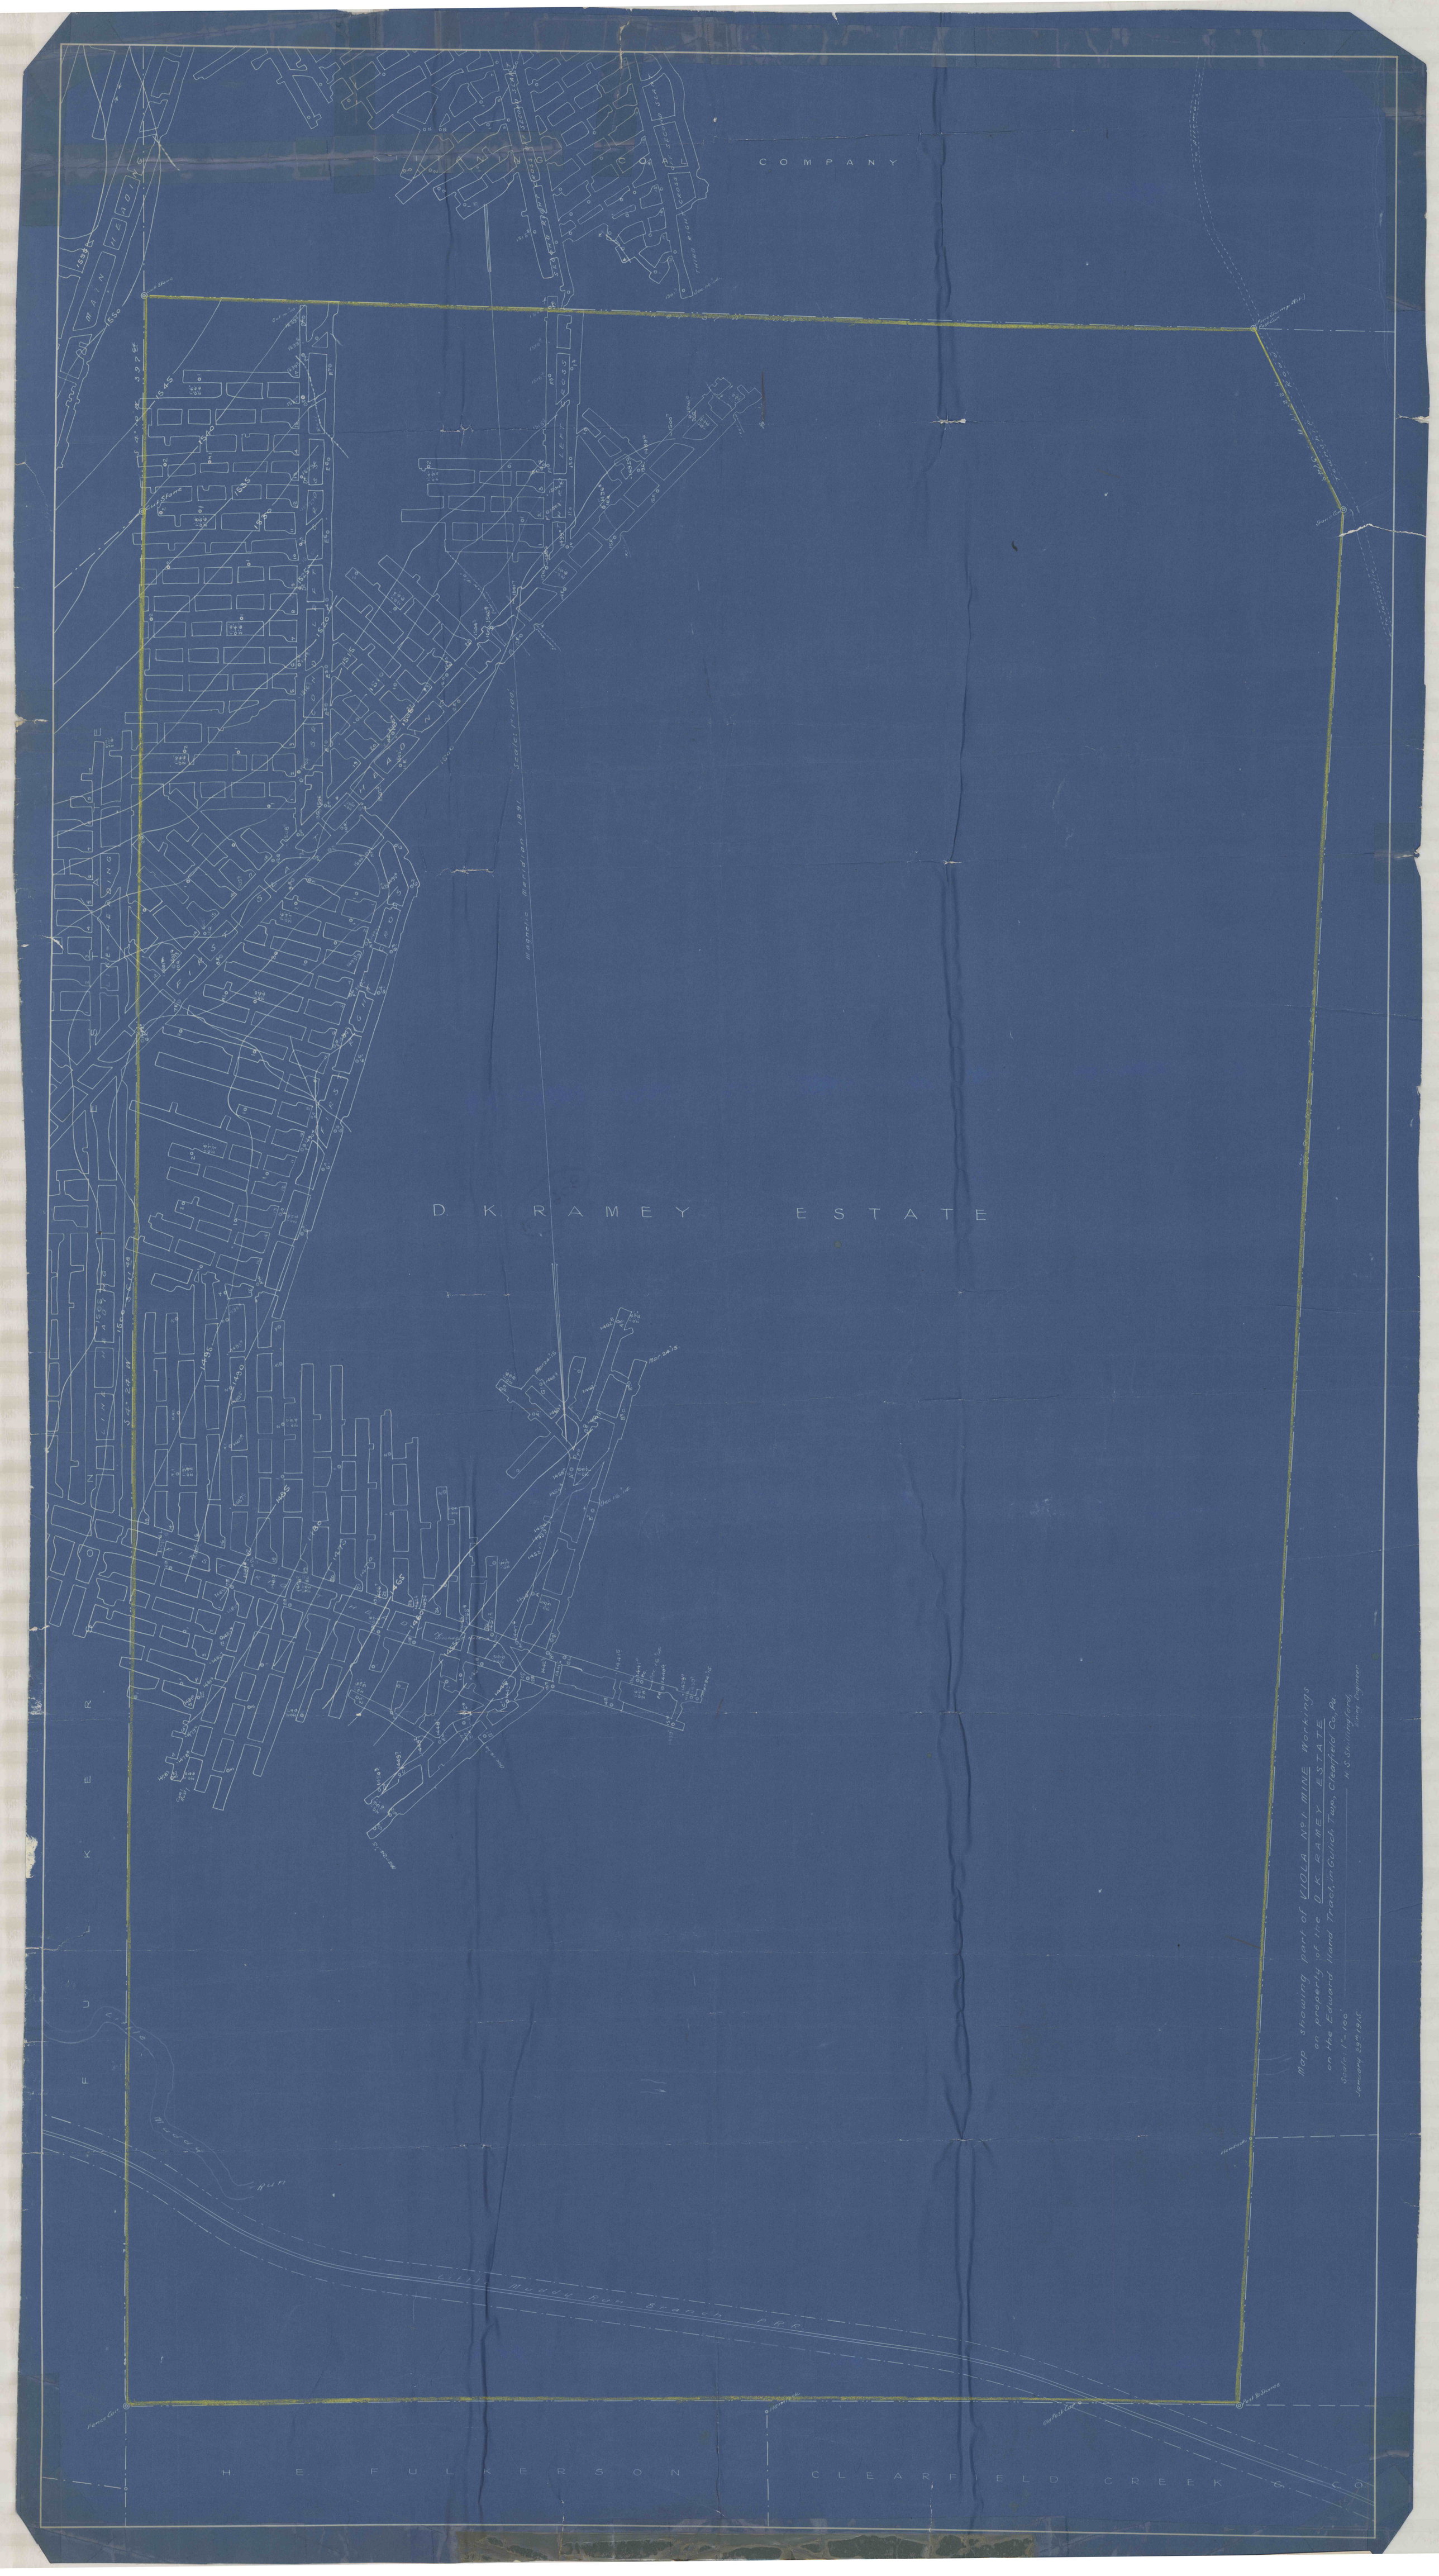
KITTANNING COAL COMPANY
D. K. RAMEY ESTATE
H. E. FULKERSON
CLEARFIELD CREEK & CO.
Little Muddy Run Branch PRR
Muddy Run
Magnetic Meridian 1891 Scale: 1" = 100'
Map showing part of VIOLA No. 1 MINE Workings
on property of the D. K. RAMEY ESTATE
on the Edward Hand Tract, in Gulich Twp., Clearfield Co., Pa.
Scale: 1" = 100'
January 29th 1915.
H. S. Shillingford,
Mining Engineer.