



W. H. SNYDER
35.24 AC.

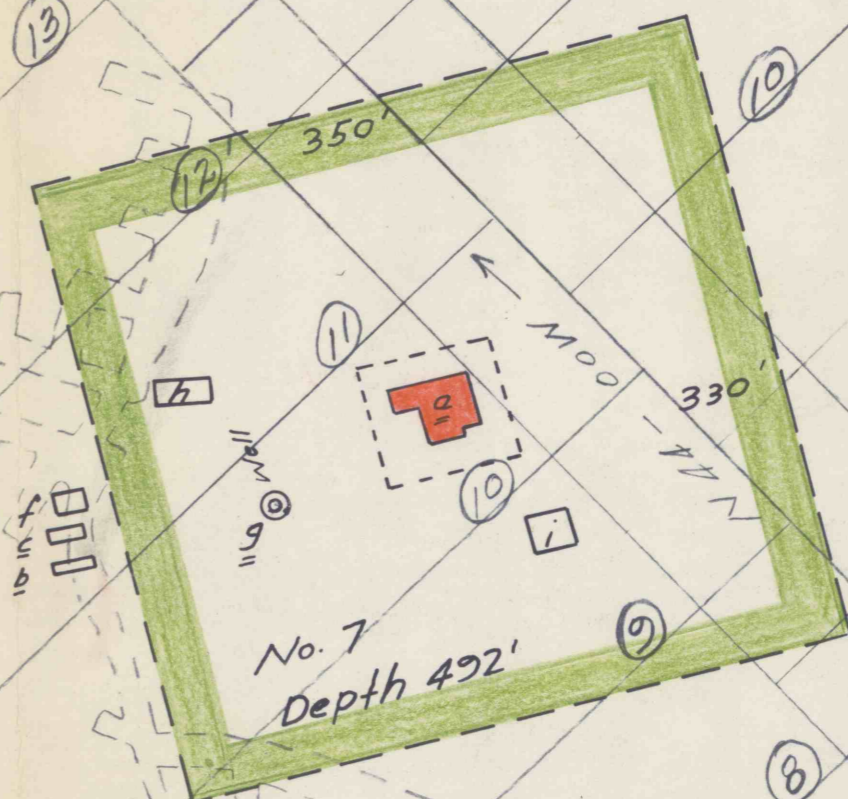

A. GAMBLE
18.17 AC.

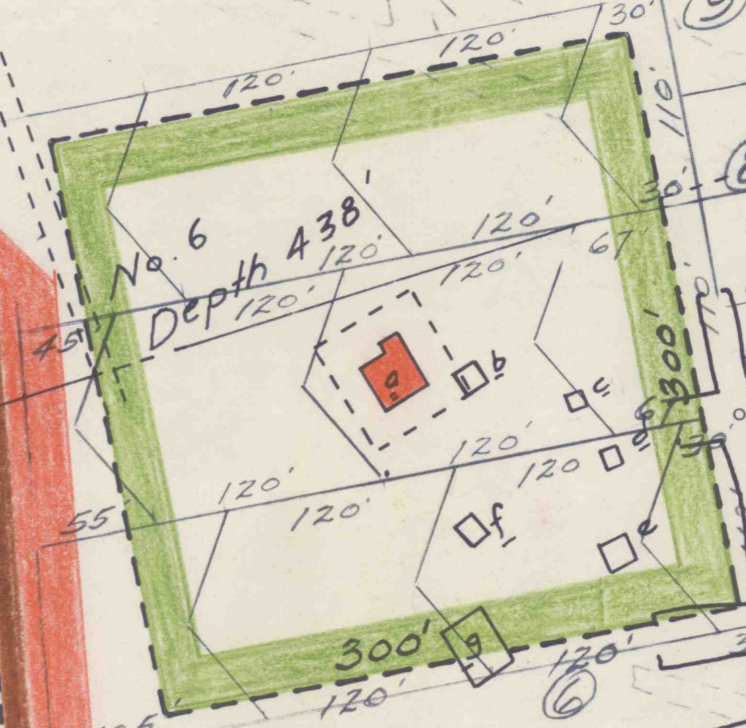

J. K. DODSON
58.66 AC.

SHEET NO. 8

W. H. Snyder