




LEGEND

| | | |
|-----------------------|------------------|--|
| Contemplated Mining | 9-1-67 to 3-1-68 | |
| Support Area | 3-1-68 to 9-1-68 | |
| Protected Structures | | |
| Mining Completed Area | | |
| Boundary Line | | |

CRICHTON COAL & COKE CO.
 VIRGINIA NO. 20 MINE
 BRUSH VALLEY & CENTER TWPS.
 INDIANA COUNTY, PA.
 SCALE 1"=100' SURVEY DATE 6-31-67
 2-15-68

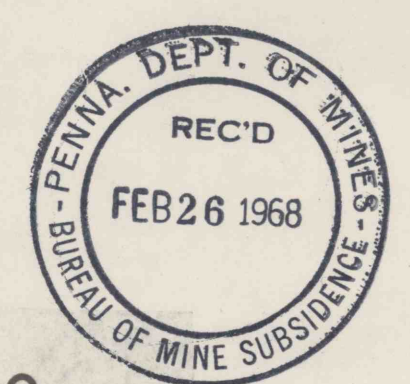

Edward J. Ledda