




D. L. SNYDER  
54.14 AC.

W. H. SNYDER  
20.0 AC.


D. C. SNYDER  
69.82 AC.

SAMUEL McDONALD HRS.  
332.59 AC.

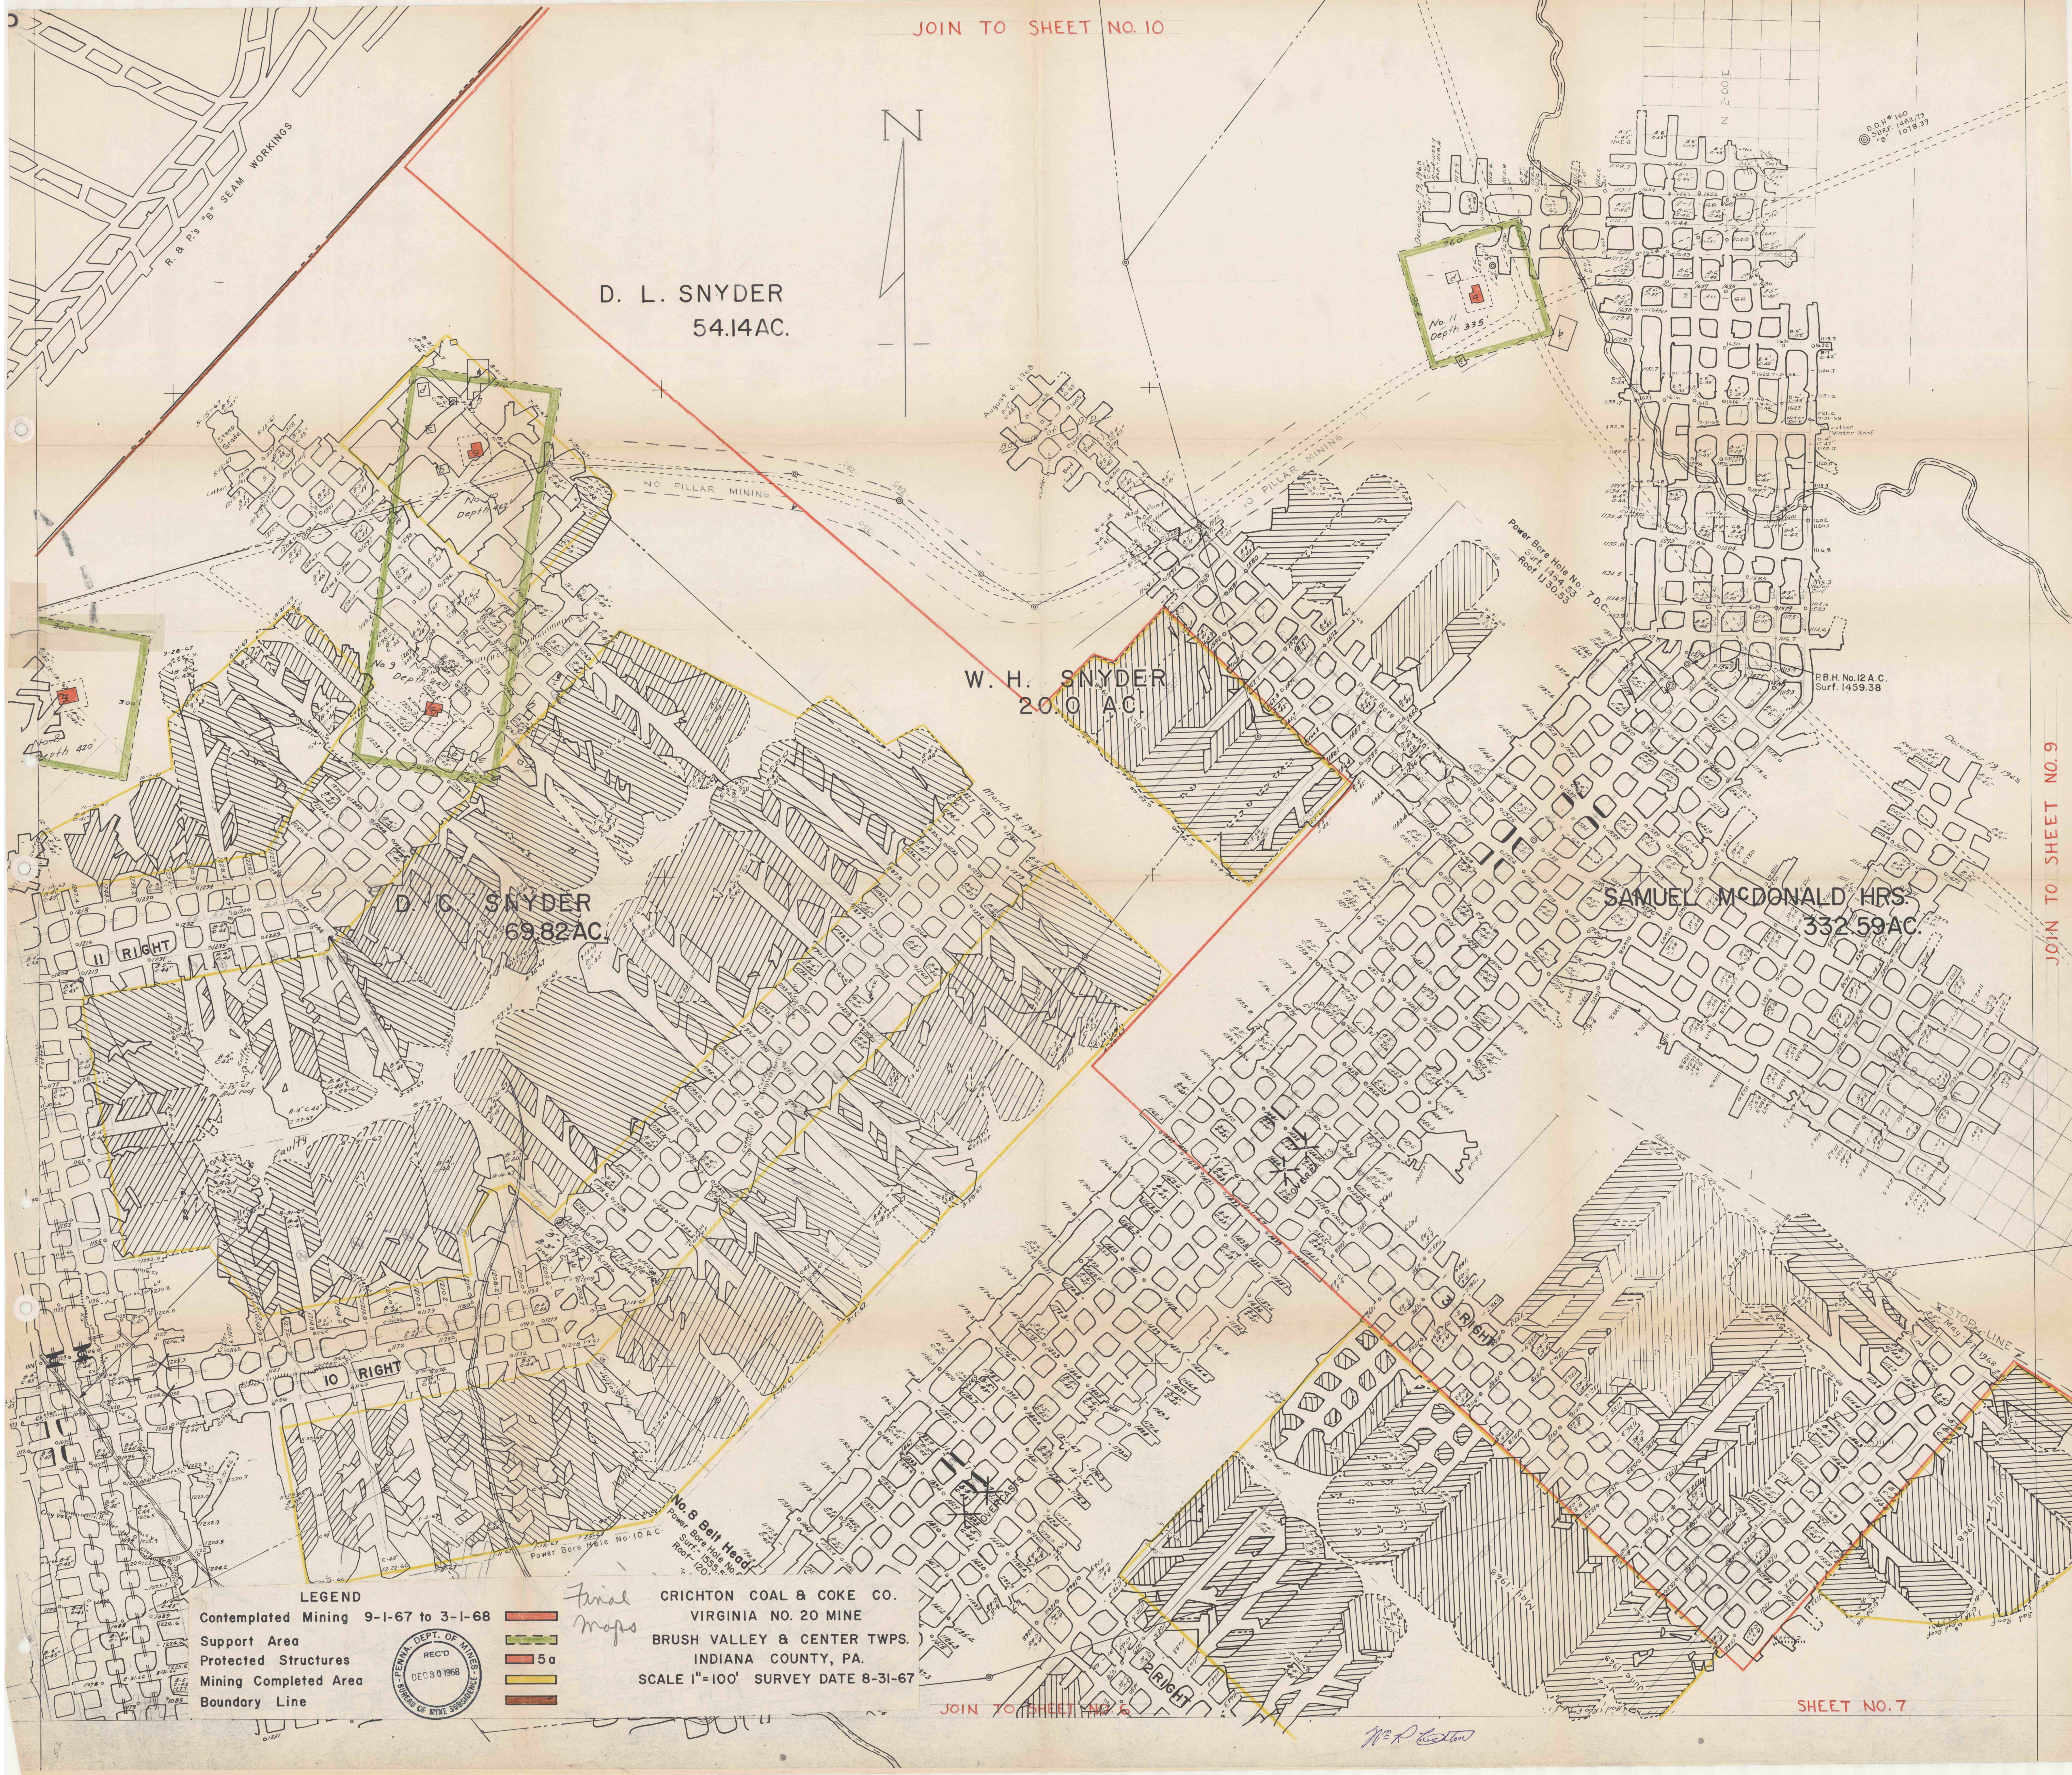

**LEGEND**

- Contemplated Mining 9-1-67 to 3-1-68
- Support Area
- Protected Structures
- Mining Completed Area
- Boundary Line

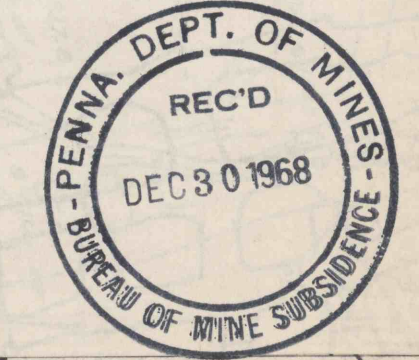

*Final maps*

CRICHTON COAL & COKE CO.  
VIRGINIA NO. 20 MINE  
BRUSH VALLEY & CENTER TWPS.  
INDIANA COUNTY, PA.  
SCALE 1"=100' SURVEY DATE 8-31-67

*W. R. ...*