


D. L. SNYDER
54.14 AC.

W. H. SNYDER
20.0 AC.

D. C. SNYDER
69.82 AC.

SAMUEL McDONALD HRS.
332.59 AC.

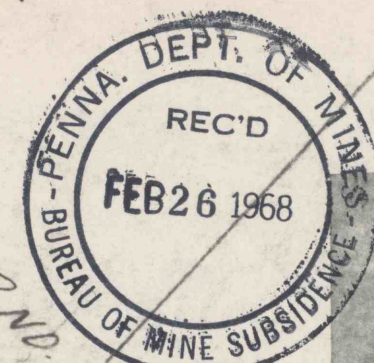

LEGEND

Contemplated Mining	9-1-67 to 3-1-68	
Support Area	3-1-68 to 9-1-68	
Protected Structures	5a	
Mining Completed Area		
Boundary Line		

CRICHTON COAL & COKE CO.
VIRGINIA NO. 20 MINE
BRUSH VALLEY & CENTER TWPS.
INDIANA COUNTY, PA.
SCALE 1"=100' SURVEY DATE 8-31-67
2-15-68

Edward J. Petillo