



E. E. FISCUS

E. E. FISCUS

V. C. RUPP

CHARLES V. RUPP




M. L. JORDAN

YOUNT

W. T. FLANDERS

RUSSELL J. RUPP
25.60 AC.

MINING NOT TO EXCEED 50% OF SEAM
60' Rad. RES. NO. MINING

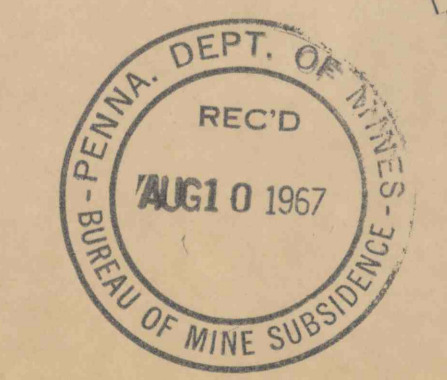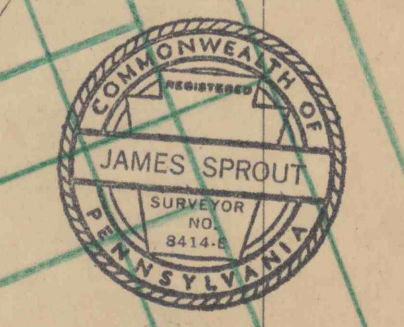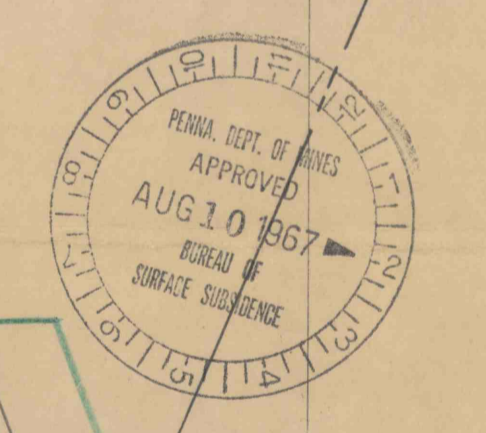

James Spruit

ALLEGHENY RIVER MINING COMPANY

1/67 to 1/68

3 3