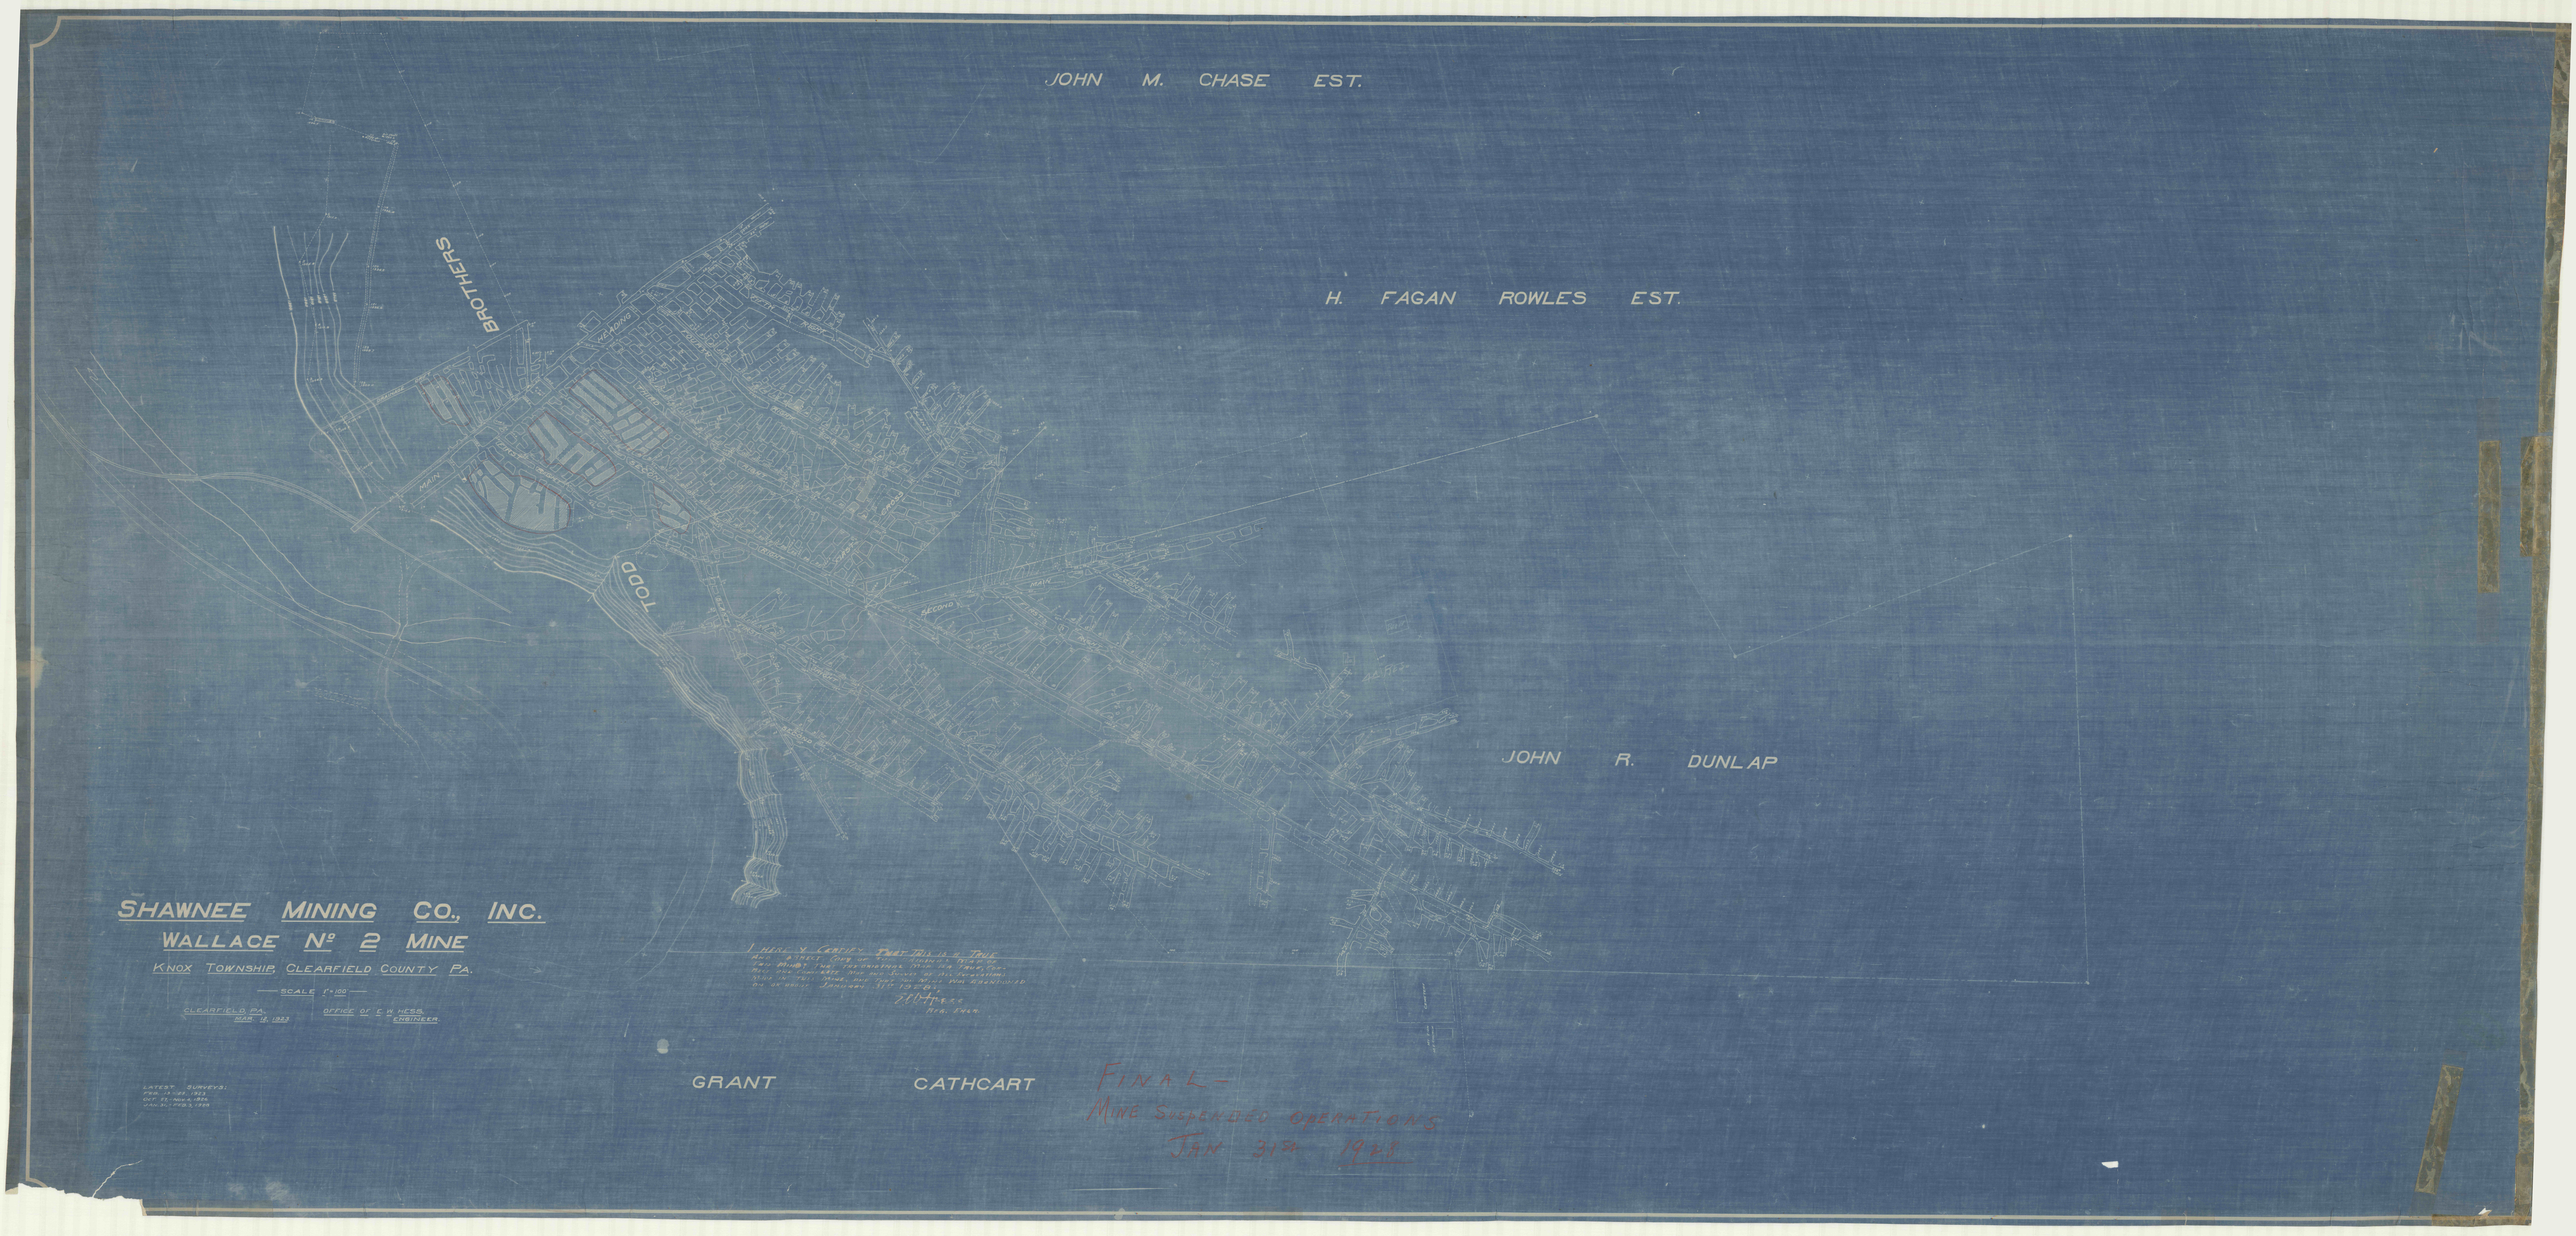
JOHN M. CHASE EST.
H. FAGAN ROWLES EST.
JOHN R. DUNLAP
GRANT
CATHCART
BROTHERS
TODD
MAIN
SECOND
THIRD
FOURTH
FIFTH
SHAWNEE MINING CO., INC.
WALLACE Nº 2 MINE
KNOX TOWNSHIP, CLEARFIELD COUNTY, PA.
SCALE 1"=100'
CLEARFIELD, PA.
MAR 14, 1933
OFFICE OF E. W. HESS
ENGINEER
LATEST SURVEYS:
FEB. 17-1931, 1933
OCT. 31, 1928, 1930
JAN. 31, 1928, 1928
I HEREBY CERTIFY THAT THIS IS A TRUE
AND CORRECT COPY OF THE ORIGINAL TRACING OF A SURVEY
MADE UNDER MY DIRECTION AND THAT ALL DETAILS
SHOWN THEREON WERE SURVEYED BY ME OR UNDER MY SUPERVISION
BY OR DURING JANUARY, 1931 TO OCT. 1931
E. W. HESS
REG. ENGR.
FINAL—
MINE SUSPENDED OPERATIONS
JAN 31st 1928