


SHANNON COAL COAL

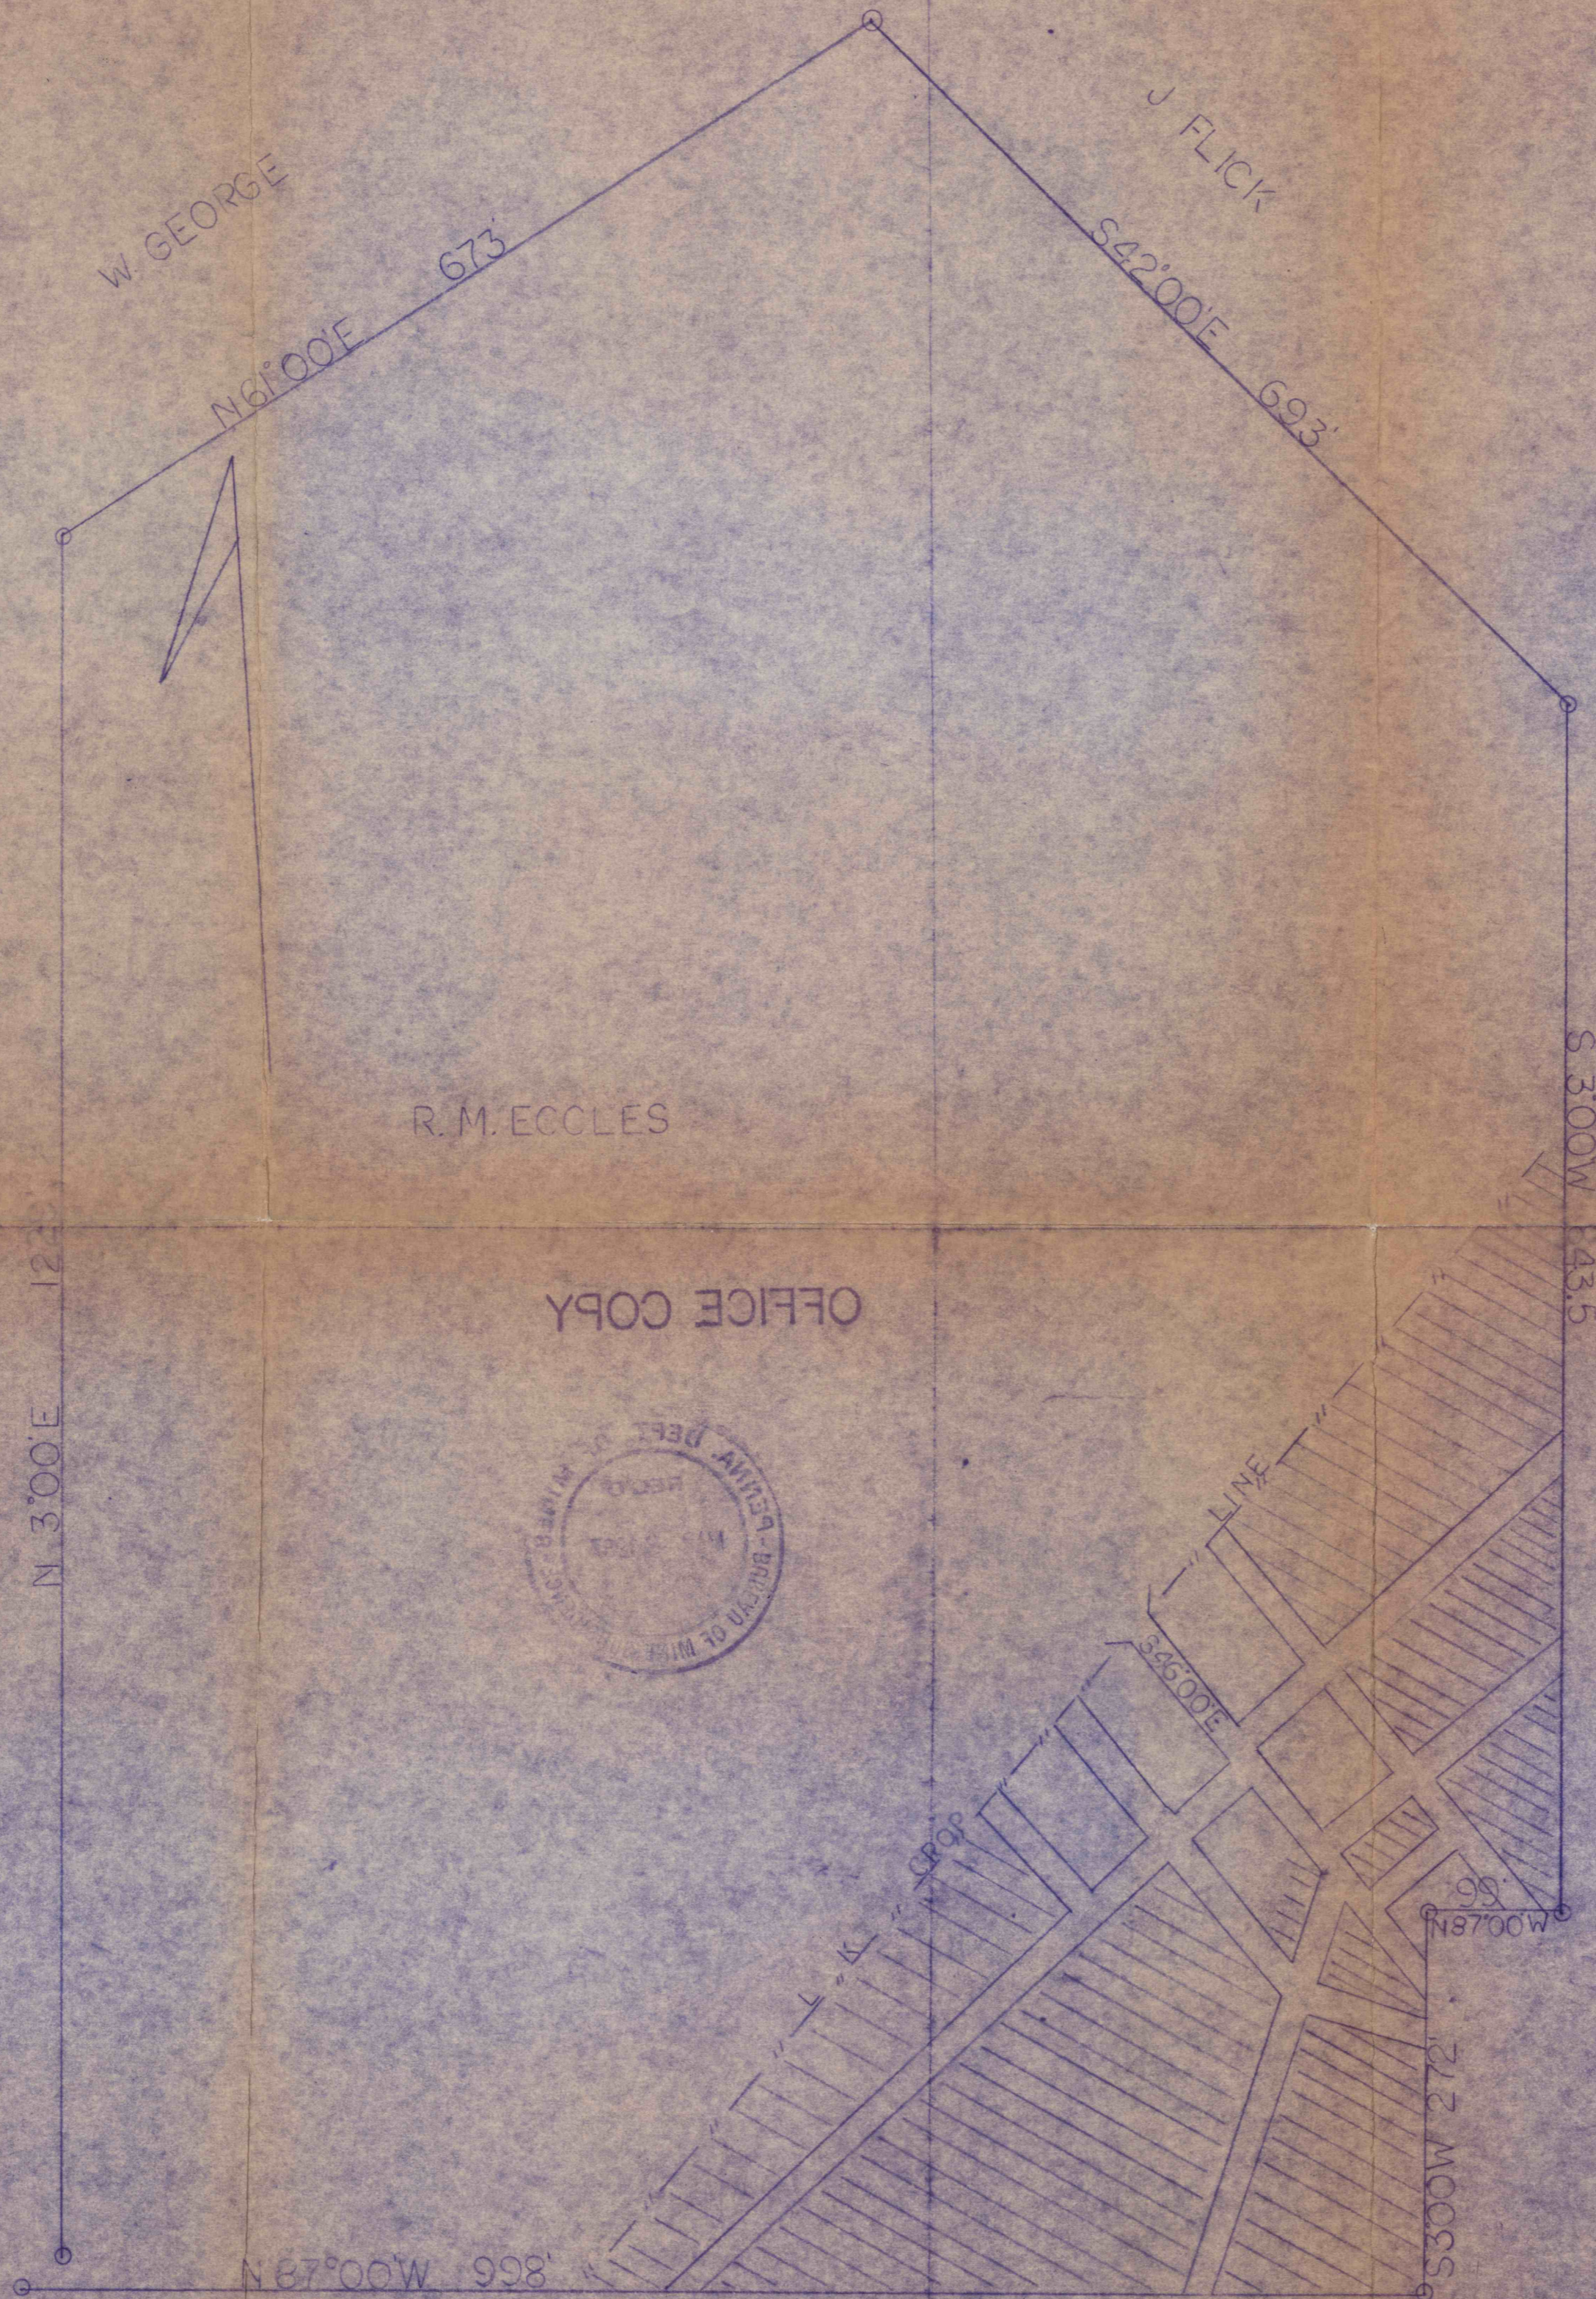

W. GEORGE

J. FLICK

N 61°00'E 673'

S 42°00'E 693'

R. M. ECCLES

J. FLICK

OFFICE COPY

N 3°00'E 122'

S 31°00'W 143.5'



CROP LINE

S 46°00'E

N 87°00'W 998'

S 30°00'W 272'

JAMES AQUILINA

WALTERS MINES
 MADISON TWP CLARION CO. PA.
 SCALE 1"=100'
 BY PAUL DIVINS RS. FEB 22 1967
 DENOTES WORKED OUT AREA

