


Note—
 Workings of Warmick Coal Co. are
 Traced From Their Blue Print Received Nov. 28, 1921.
 March, 23, 1922.
 February, 19, 1923.
 " 12, 1924.
 " 12, 1925 (M).
 July, 1, 1932.

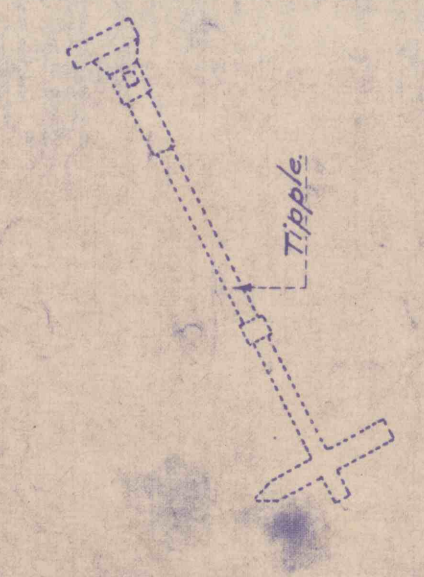

M
 O
 1