


2

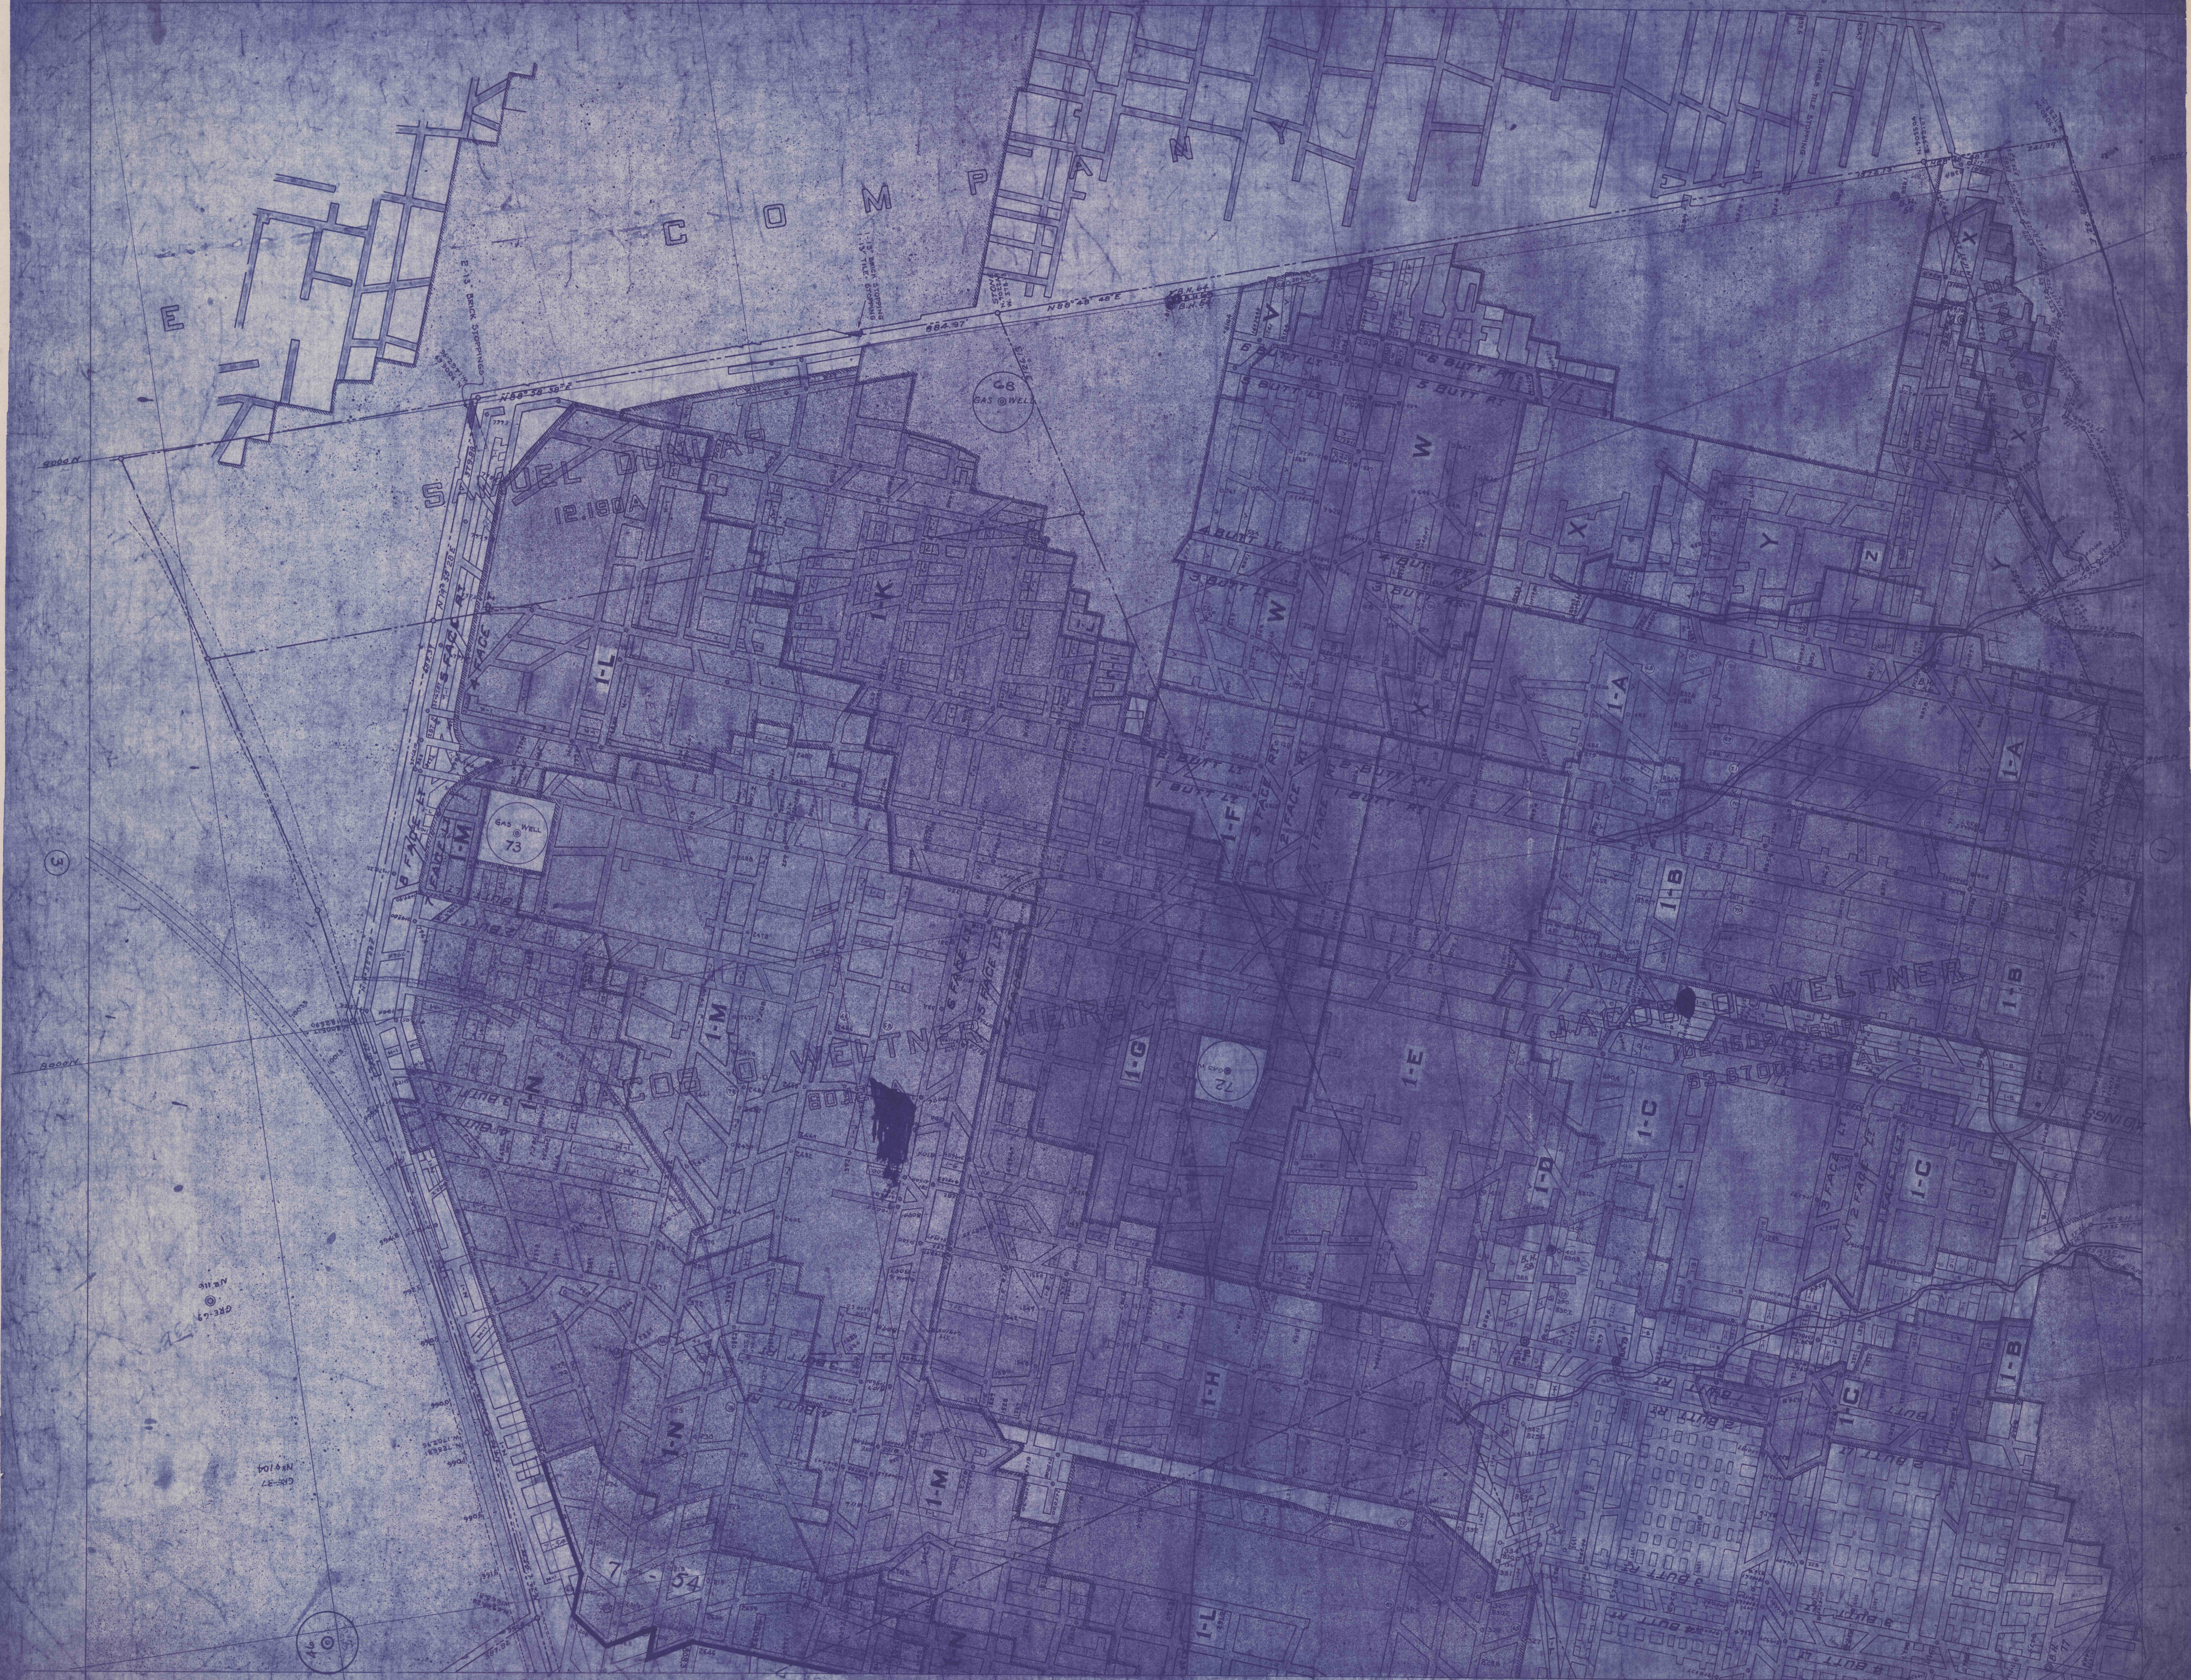

3
GRE-9
No. 116
No. 104
CR-27

