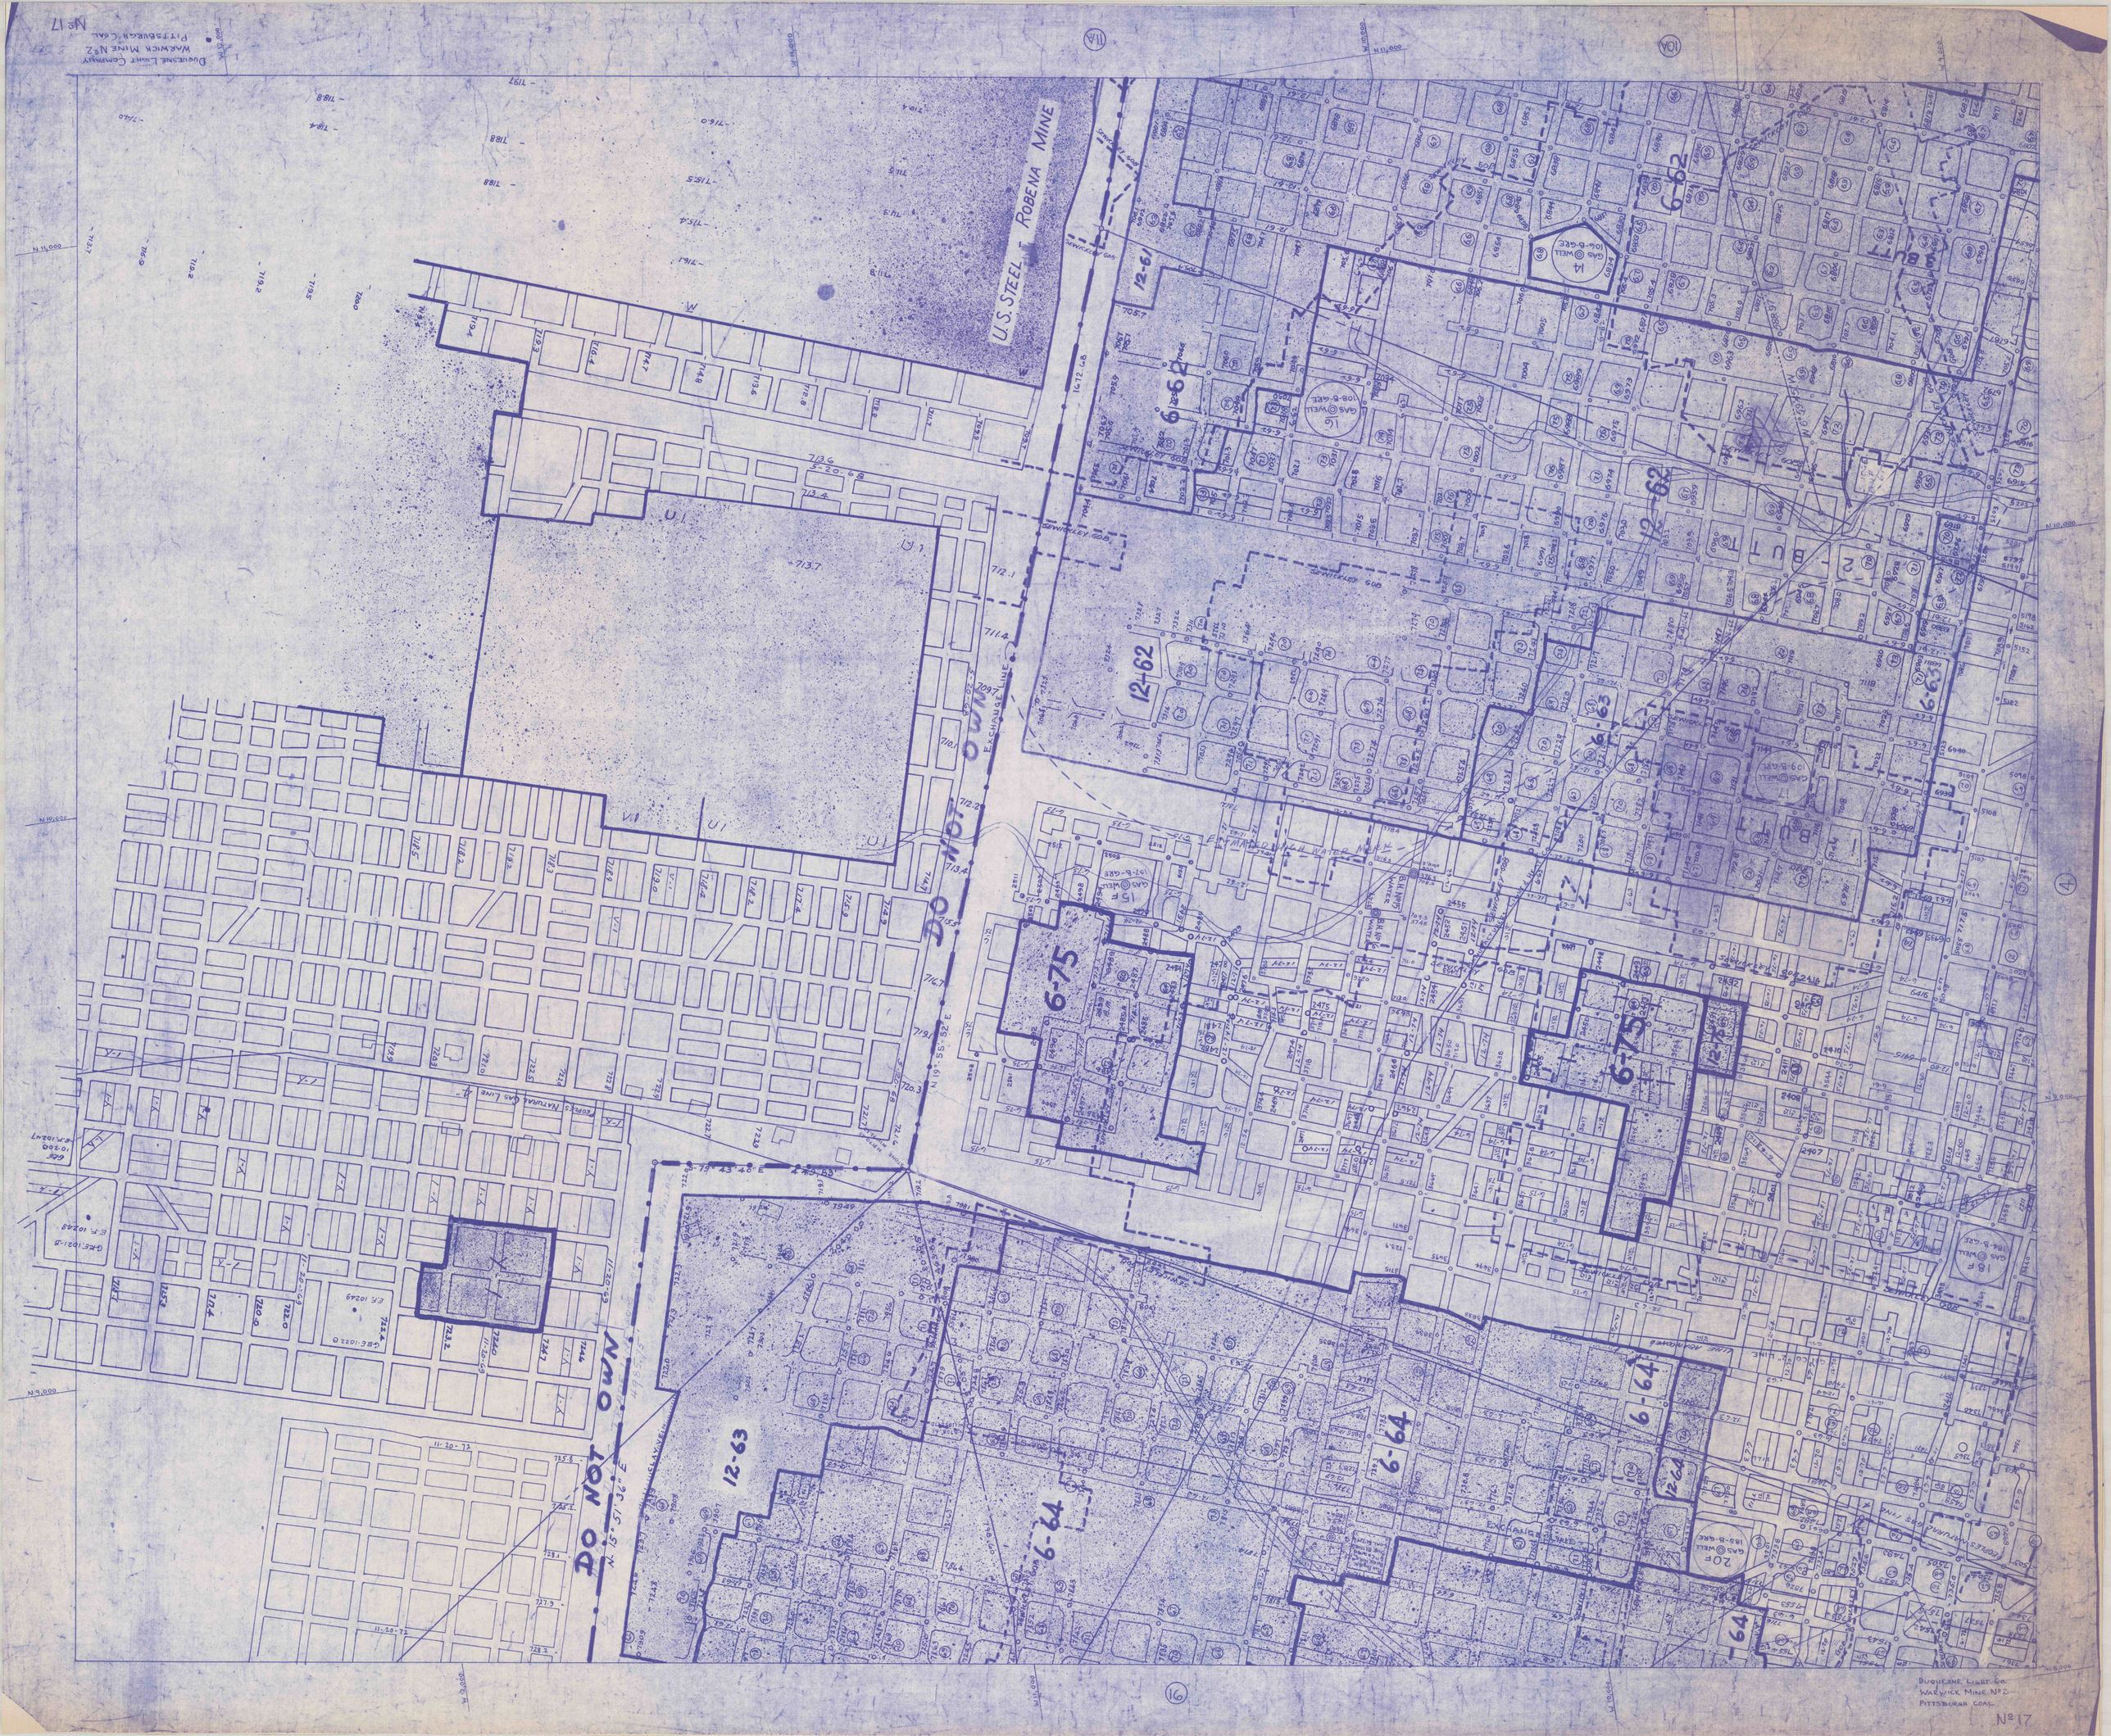

U.S. STEEL - ROBENA MINE
DO NOT OWN
DO NOT OWN
EXCHANGE LINE
12-61
6-62
12-62
6-63
6-75
12-63
6-64
12-64
2-BUTT
3-BUTT
DUQUESNE LIGHT CO.
WARWICK MINE No 2
PITTSBURGH COAL
No 17