


#5411d

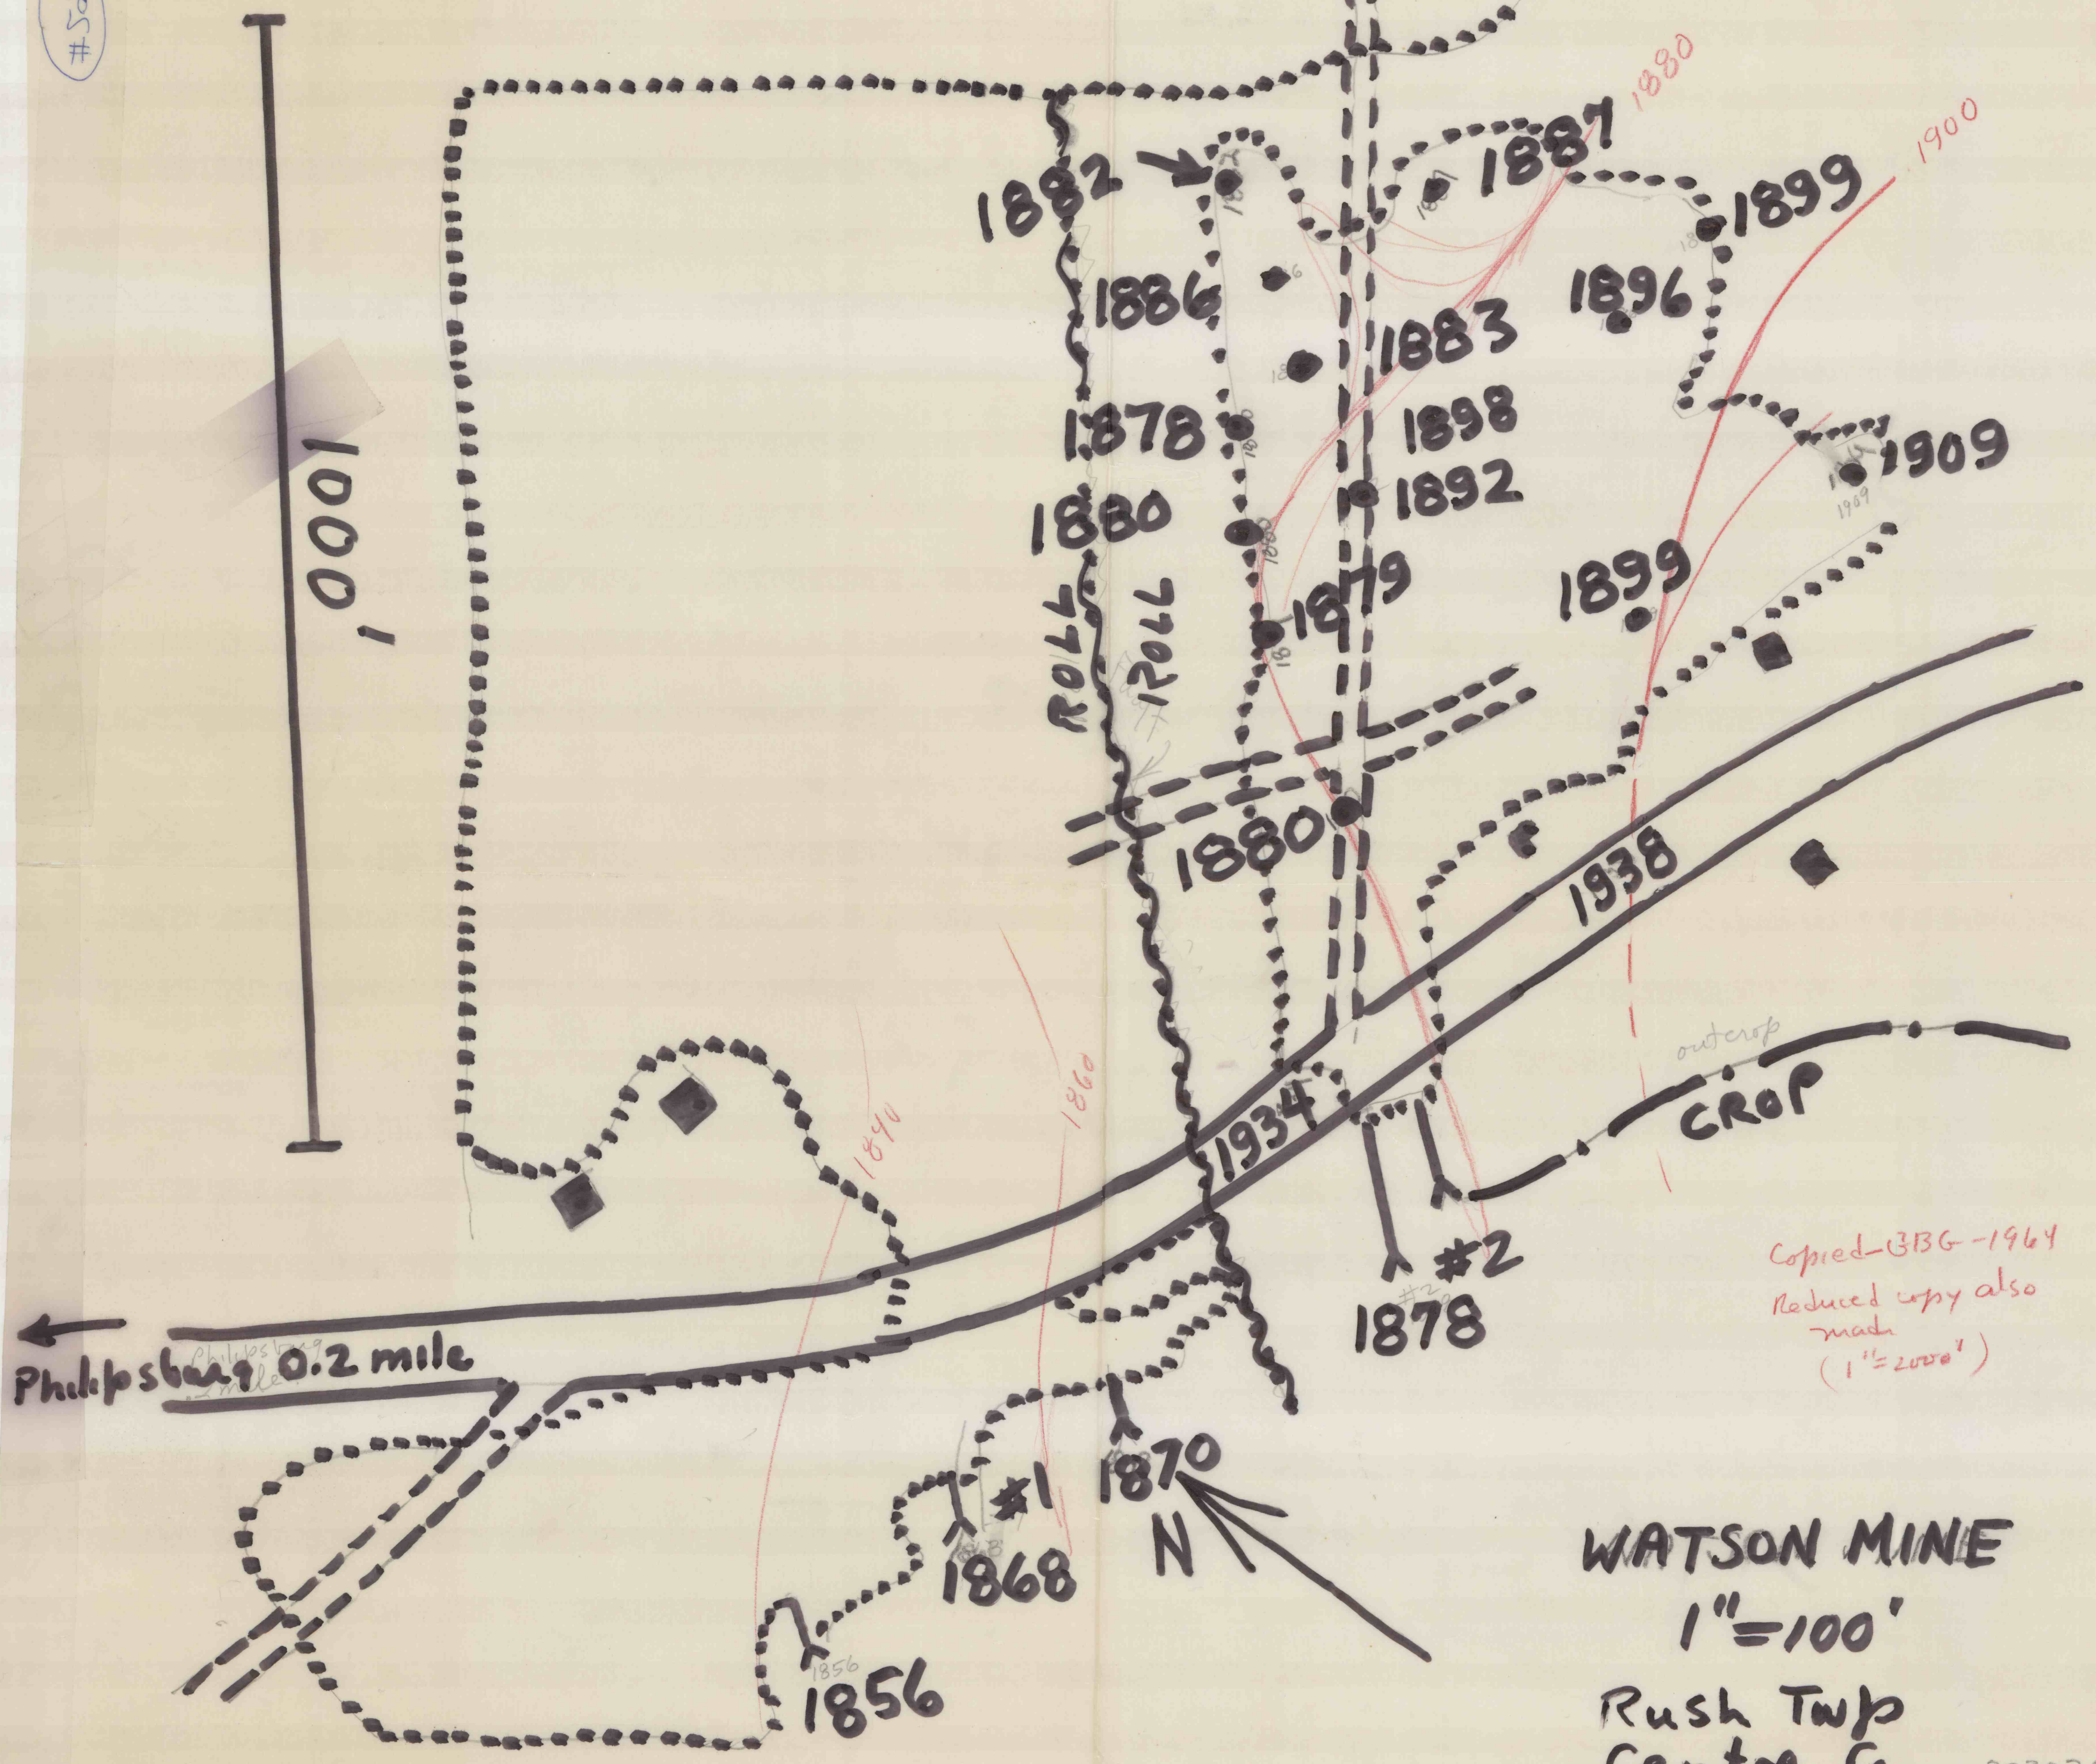

Copied-GBG-1964
 Reduced copy also
 made
 (1"=2000')

WATSON MINE
 1"=100'
 Rush Twp
 Centre Co

303075

303075