
 


| SURVEY | DATE |
|--------|----------------|
| 1 | Dec. 19, 1954 |
| 2 | July 25, 1955 |
| 3 | Sept. 29, 1957 |
| 4 | Jan. 11, 1958 |
| 5 | Apr. 13, 1959 |
| 6 | Jan. 14, 1960 |
| 7 | May 11, 1960 |
| 8 | May 11, 1960 |
STATE LINE COAL COMPANY
MINE & PROPERTY MAP 26-1956
"WAVERLY MINE"

PENNA., INDEPENDENCE TOWNSHIP, WASHINGTON COUNTY, PA.
 SCALE: 1" = 100 FT. MAY 22, 1947

DUNCAN & YOSER
 SURVEYORS
 PITTSBURGH, PA.

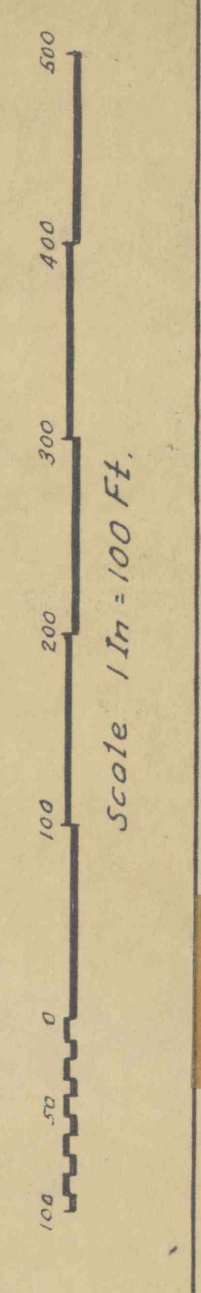

Surface Elevations Shown Thus 100.5 (±)
 All Others are Bottom of Coal.

- Buildings**
- | Number | Kind |
|----------------|--------------------------|
| 1 | Office |
| 2 | House |
| 3 | Blacksmith Shop |
| 4 | Supply House |
| 5 | First Aid & Mine Foreman |
| 6, 7, 8, 9, 10 | Mine's Houses |

Now or Formerly Robert Hudson

This Map Certified to
FRANK MALINOSKY
 S. J. Duncan
 Surveyor
 May 22, 1947