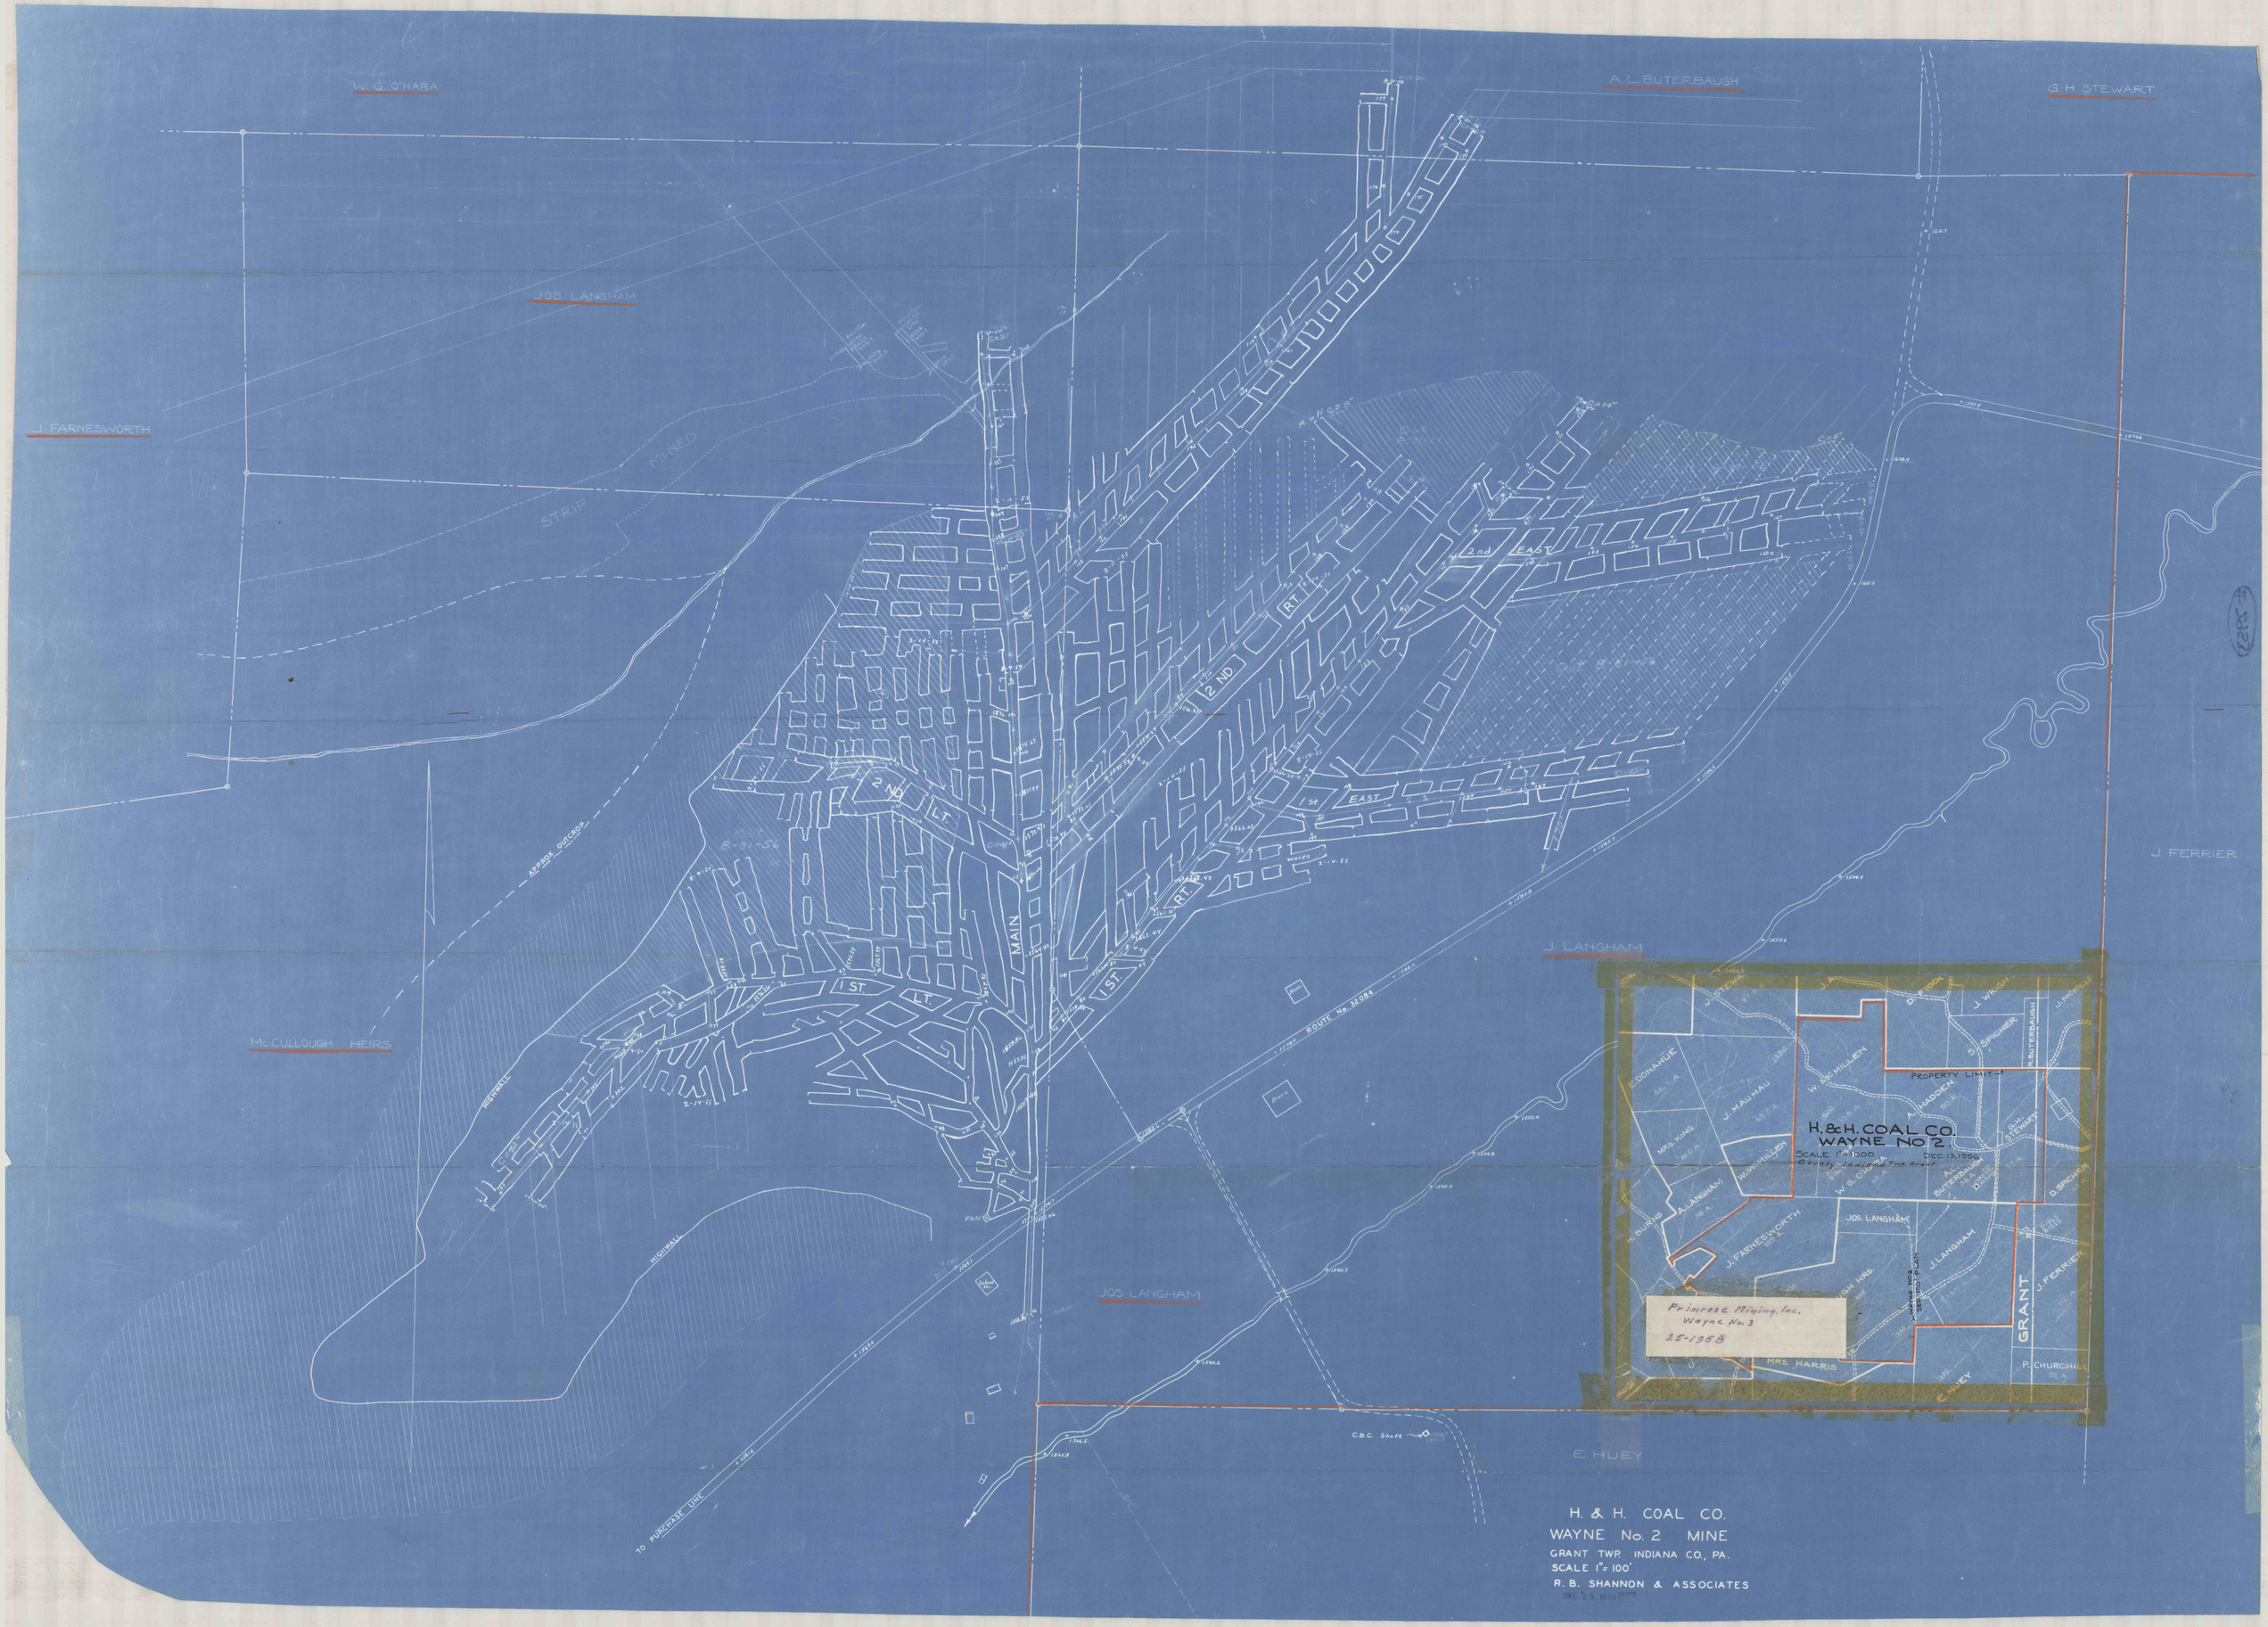
W. G. O'HARA
A. L. BUTERBAUGH
G. H. STEWART
JOS. LANGHAM
J. FARNESWORTH
STRIP MINED
2nd EAST
2 ND. RT.
2 ND. LT.
1 ST. EAST
1 ST. LT.
1 ST. RT.
MAIN
APPROX. OUTCROP
HIGHWALL
McCULLOUGH HEIRS
J. LANGHAM
J. FERRIER
JOS. LANGHAM
E. HUEY
C.B.C. Shaft
TO PURCHASE LINE
ROUTE No. 32084
H. & H. COAL CO.
WAYNE No. 2
SCALE 1" = 1000
DEC. 13, 1956
County Indiana Twp. Grant
PROPERTY LIMIT
J. MAUMAU
W. McMILLEN
A. HADDEN
S. SPICHER
J. WRIGHT
J. McMILLEN
E. DONAHUE
MRS. KING
A. LANGHAM
W. G. O'HARA
A. L. BUTERBAUGH
G. H. STEWART
D. SPICHER
H. BURNS
J. FARNESWORTH
JOS. LANGHAM
J. LANGHAM
J. FERRIER
GRANT
MRS. HARRIS
P. CHURCHILL
E. HUEY
Primrose Mining, Inc.
Wayne No. 3
25-1958
H. & H. COAL CO.
WAYNE No. 2 MINE
GRANT TWP. INDIANA CO., PA.
SCALE 1" = 100'
R. B. SHANNON & ASSOCIATES
DEC. 15 1958