WEST BROWNSVILLE MINE
DIAMOND COAL & COKE COMPANY

CHAS. S. KEATON & CO.
CIVIL ENGINEERS & SURVEYORS
FIRST NATIONAL BANK BUILDING
UNIONTOWN, PA.

SCALE 1" 100

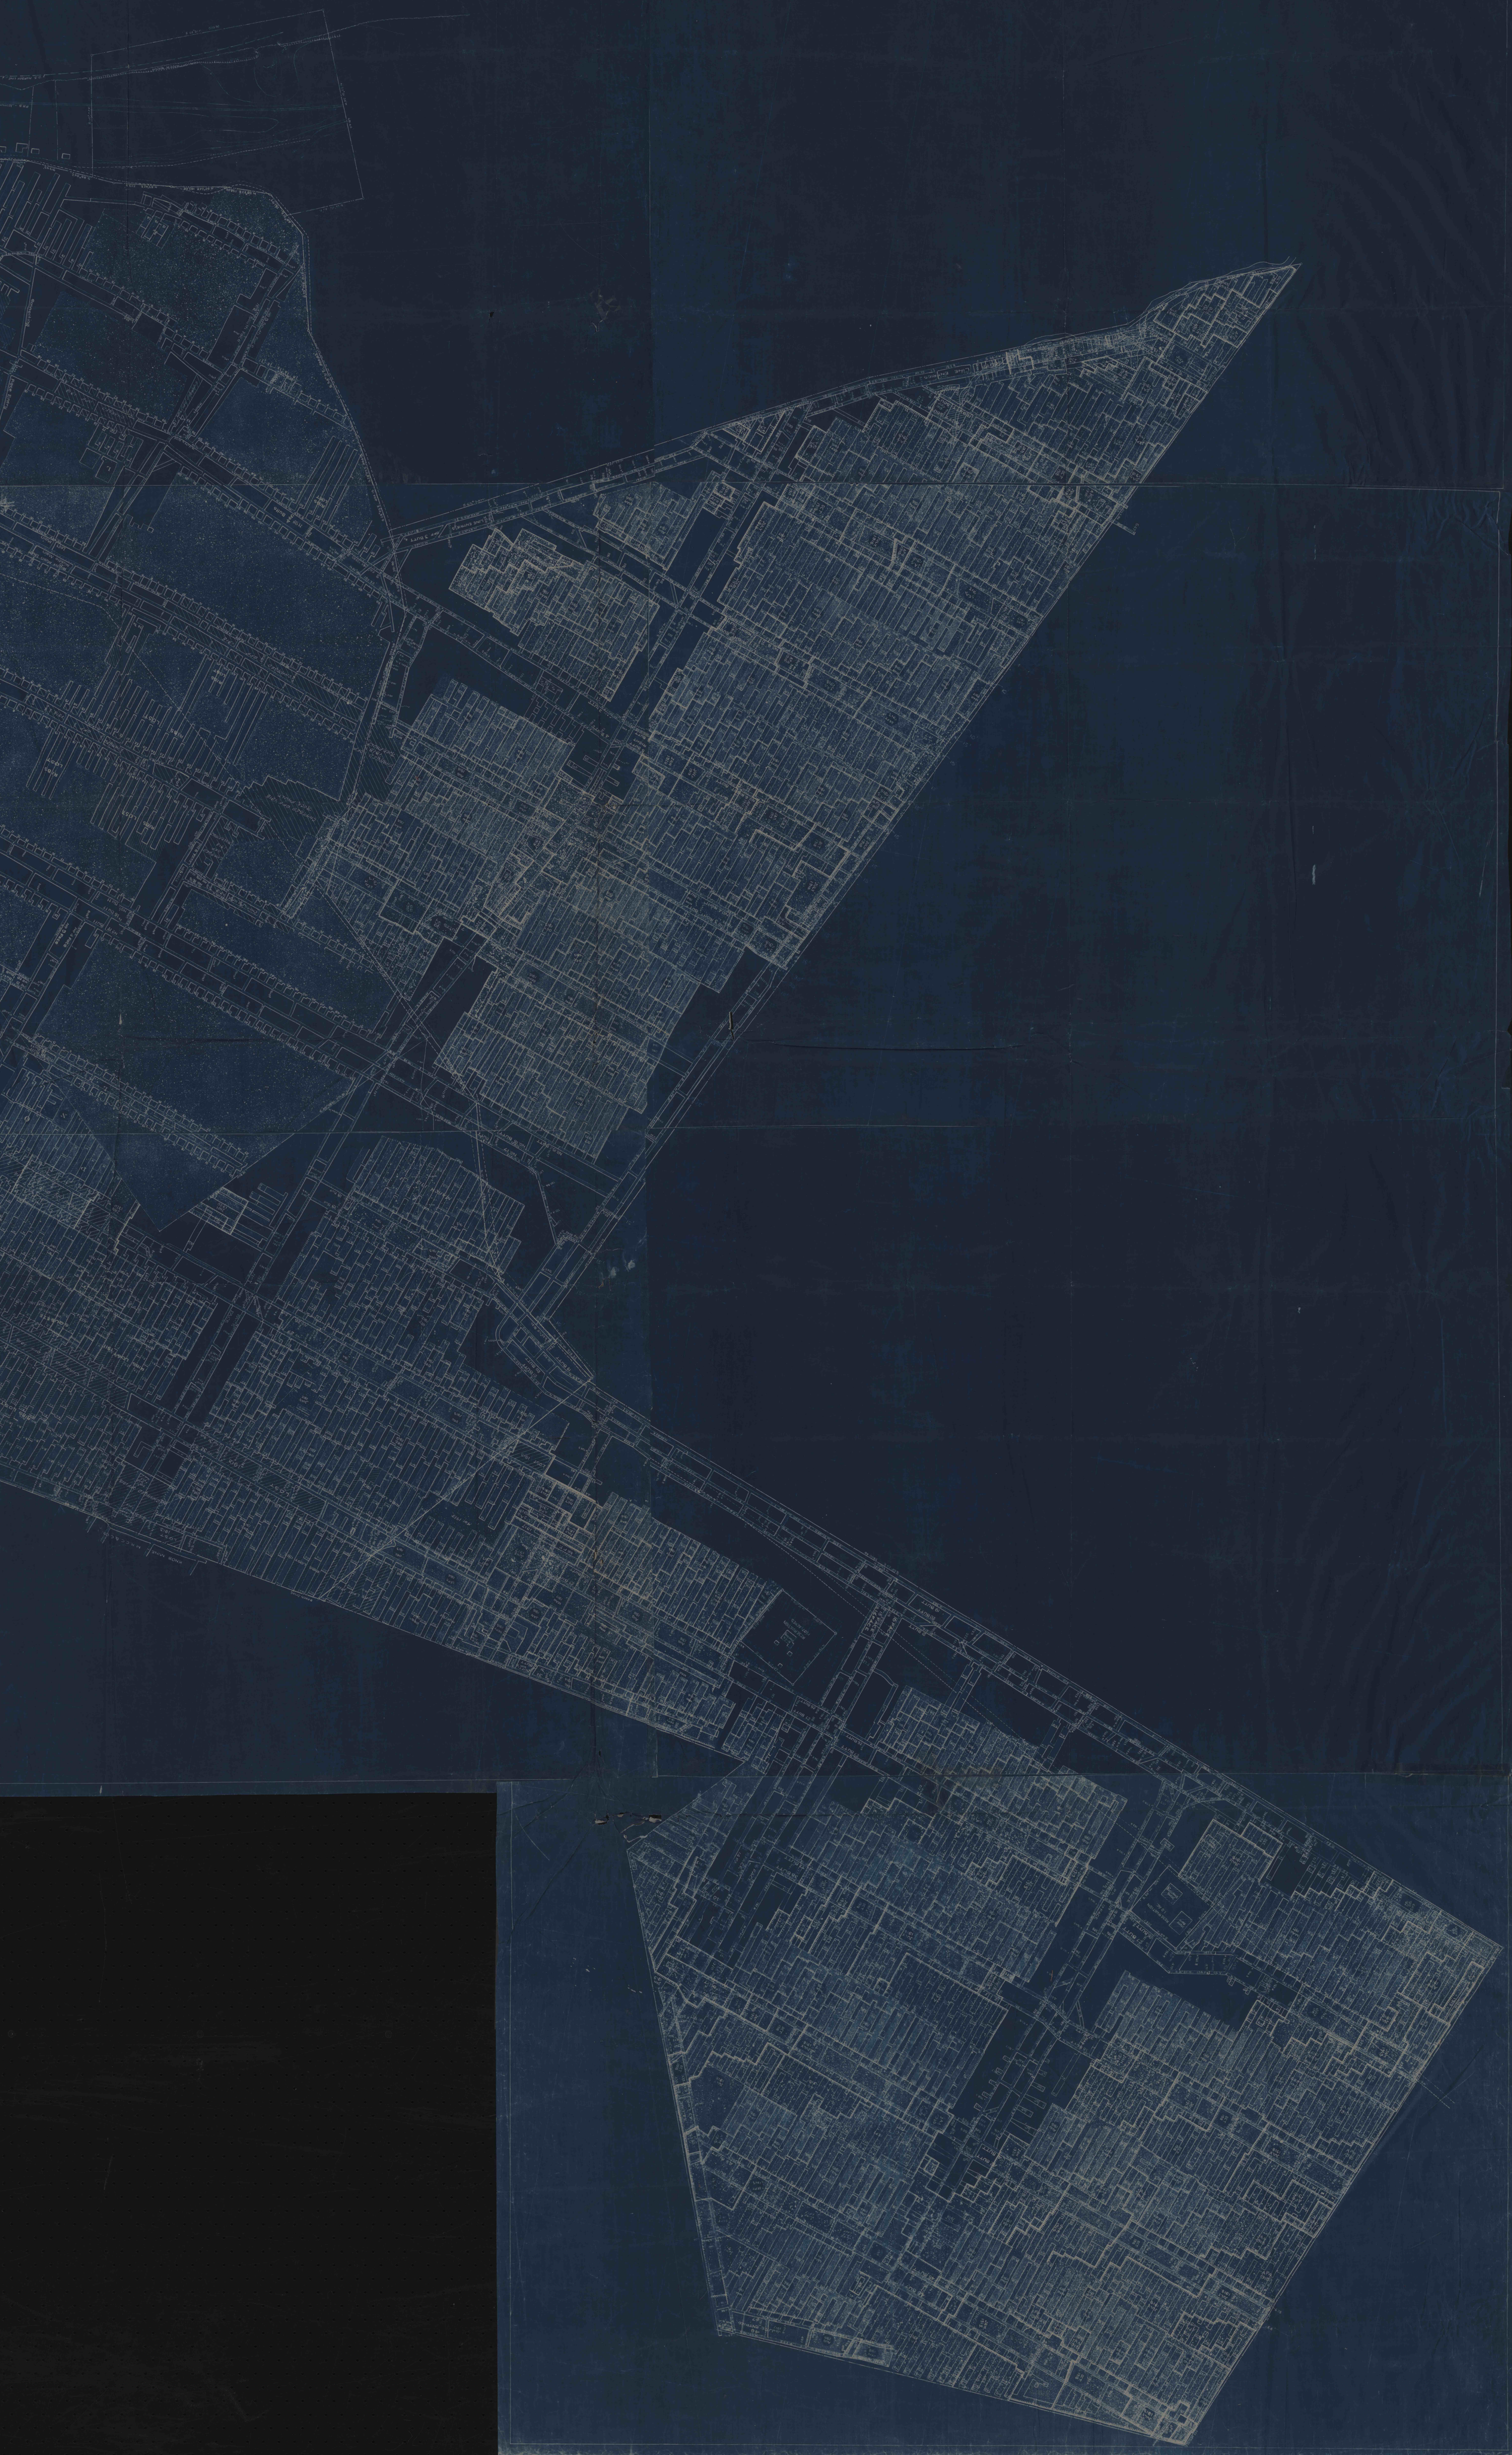
LINE ENTRIES
MAIN SLOPE
MAIN SLOPE
MAIN SLOPE