

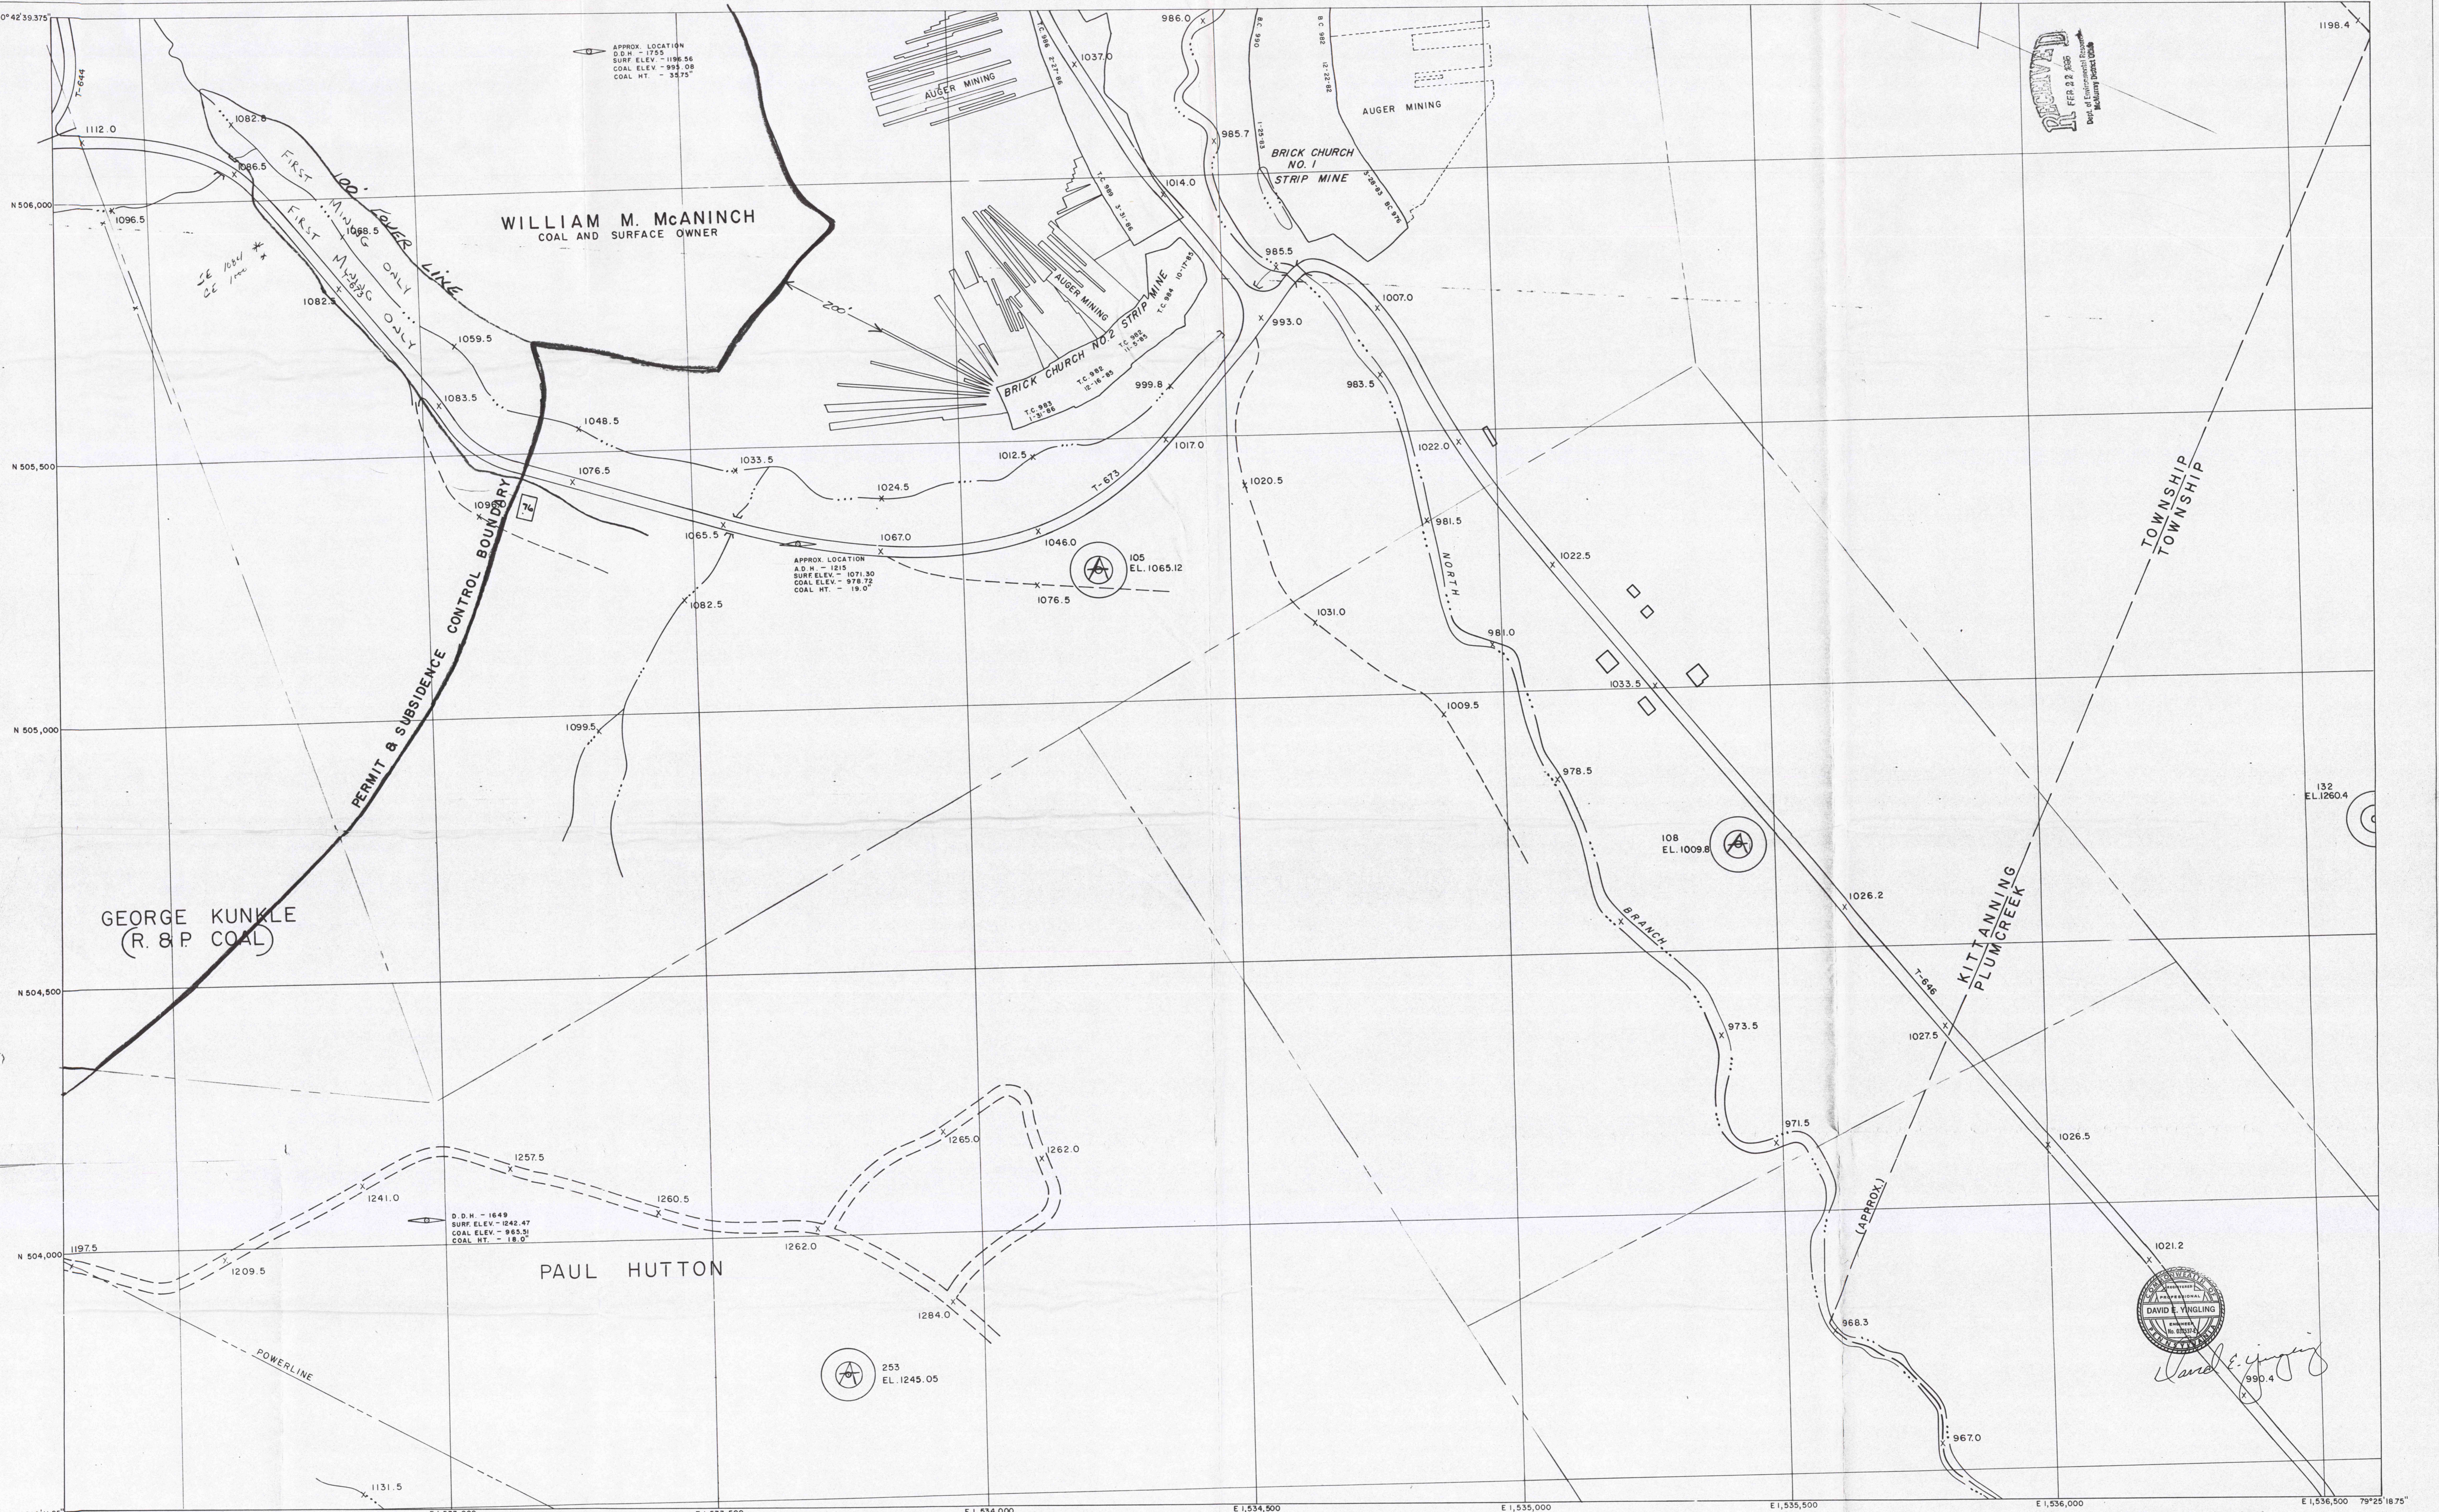
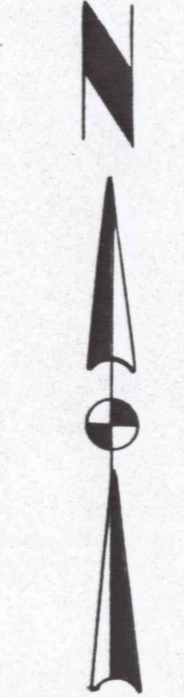


DAVID E. VINGLING  
 No. 62072  
 State of Pennsylvania  
*David E. Vingling*  
 990.4

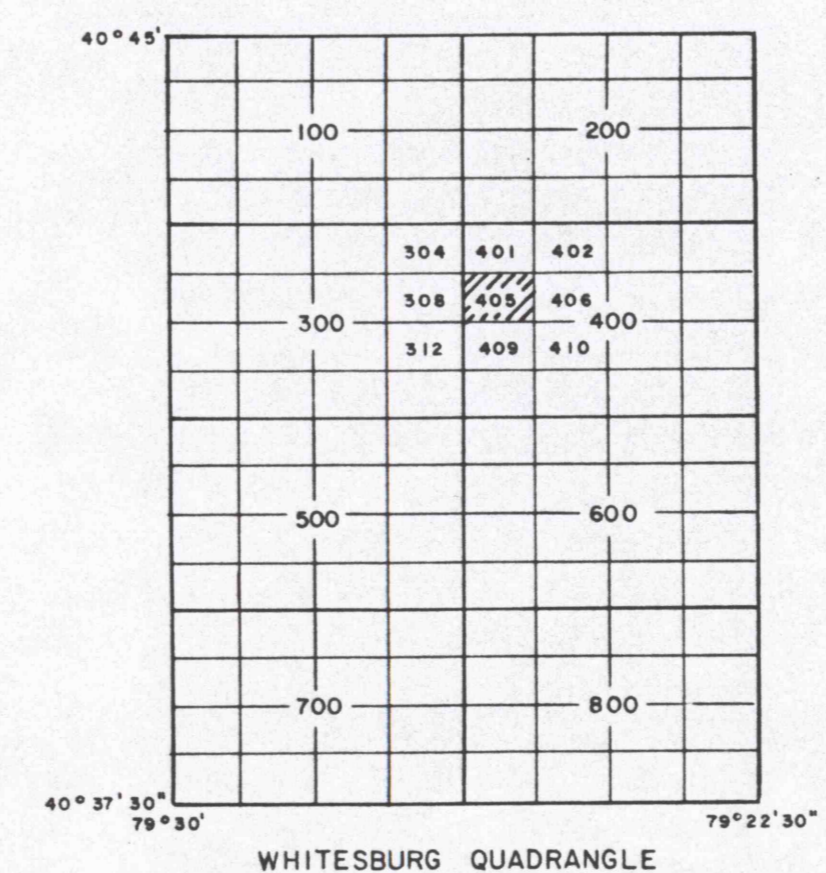

UPPER FREEPORT SEAM  
 (MSHA) NO.  
 MARGARET NO. 11 NO. 3 PORTAL  
 PERMIT (DER) NO. 03851304

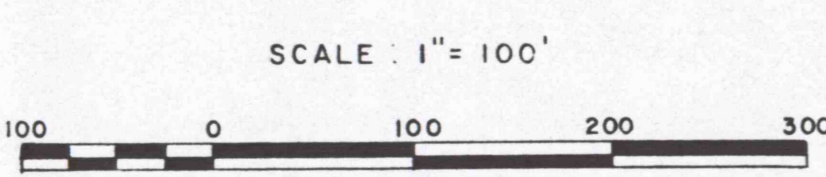

**FINAL POSTING 11/18/94**  
 KEYSTONE COAL MINING CORP.  
 MARGARET NO. 11 NO. 3 PORTAL  
 KITTANNING TOWNSHIP  
 WHITESBURG AREA  
 ARMSTRONG COUNTY  
 WHITESBURG QUADRANGLE  
 SHEET NO. 403730-792230/405

MARG-11-NO-3-405

Prepared By  
 MICHAEL BAKER, JR., INC.  
 Consulting Engineers  
 Beaver, Pennsylvania