

**RALPH S. WRIGHT**

VOLUMES:  
 CH4%  
 WATER GAGE  
 RETURN  
 INTAKE

MARGARET NO. 11  
 NO. 2 PORTAL NO. 1 FAN  
 MOTOR - 480-V JOY H60-36  
 MOTOR SPEED - 1185 RPM  
 MOTOR HP - 200  
 FAN SPEED - 920 RPM  
 BLADE SETTING - 12°

**CHARLES R. BAKER**  
 COAL AND SURFACE OWNER  
 MARGARET NO. 11 NO. 3 PORTAL NO. 1 FAN  
 VORAX 54D-1139  
 BELT DRIVE  
 FAN SPEED - 1170 R.P.M.  
 MOTOR HP - 100  
 VOLTS - 460  
 3 PHASE  
 60 CYCLE  
 BLADE POSITION 25°

VOLUMES  
 CH4%  
 WATER GAGE  
 RETURN  
 INTAKE



NOTE: THE ONLY MINING TO OCCUR IN THE AREA OF LESS THAN 100' COVER WITHIN THE PERENNIAL SECTION OF THE UNAMED TRIBUTARY TO THE NORTH BRANCH OF CHERRY RUN WILL BE FIRST MINING OF THE APPROVED CROSSING. NO ROOM DEVELOPMENT MAY EXTEND INTO THIS ZONE.

KEYSTONE COAL MINING CORP.  
**MARGARET NO. 11- NO. 3 PORTAL**  
 KITTANNING TOWNSHIP  
 WHITESBURG AREA  
 ARMSTRONG COUNTY  
 WHITESBURG QUADRANGLE  
 SHEET NO. 403730 - 792230/213

UPPER FREEPORT SEAM  
 MARGARET NO. 11 - NO. 3 PORTAL (MSHA) NO. 36-08139  
 PERMIT (DER) NO. 03891304


POSTED  
 MAY 1 1994

Contemplated Mining  
 From 5-1-94 To 11-1-94

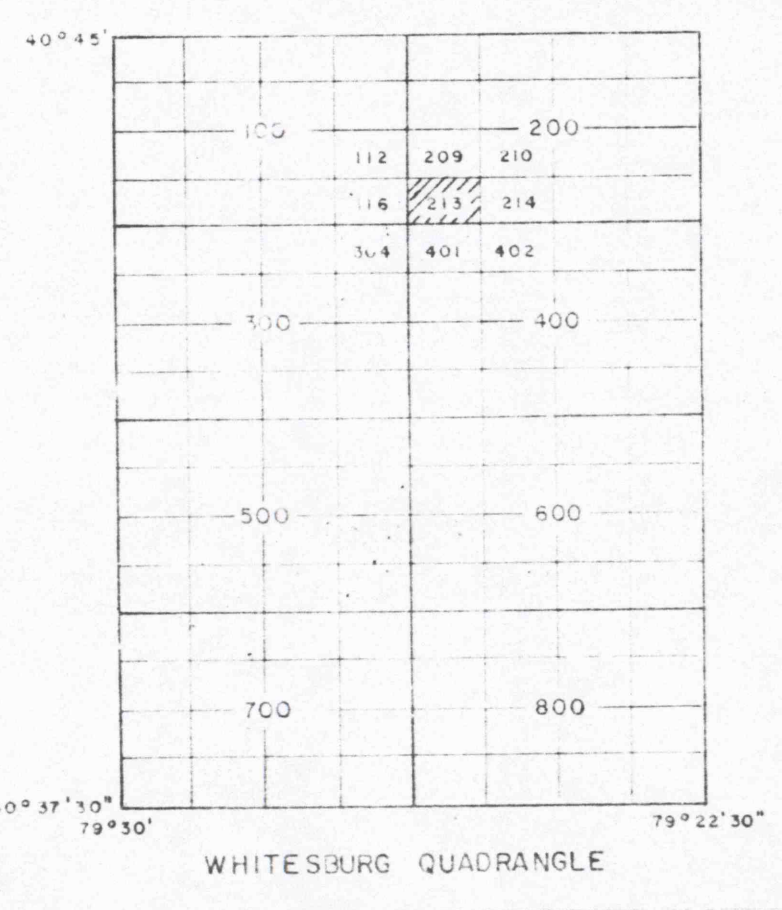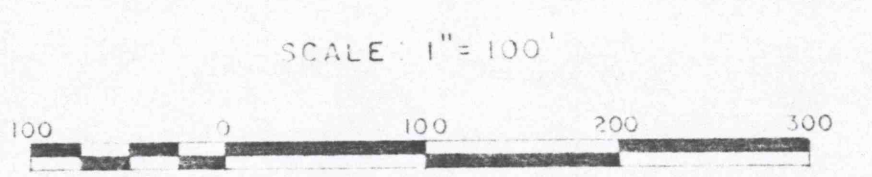

UPPER FREEPORT SEAM  
 MARGARET NO. 11- NO. 2 PORTAL (MSHA) NO. 36-08139  
 PERMIT (DER) NO. 03891301

KEYSTONE COAL MINING CORP.  
**MARGARET NO. 11- NO. 2 PORTAL**  
 KITTANNING TOWNSHIP  
 WHITESBURG AREA  
 ARMSTRONG COUNTY  
 WHITESBURG QUADRANGLE  
 SHEET NO. 403730 - 792230/213

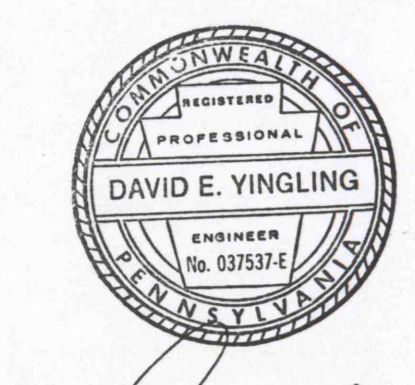

*David E. Vingling*

MARG. 11-NO. 2-213