
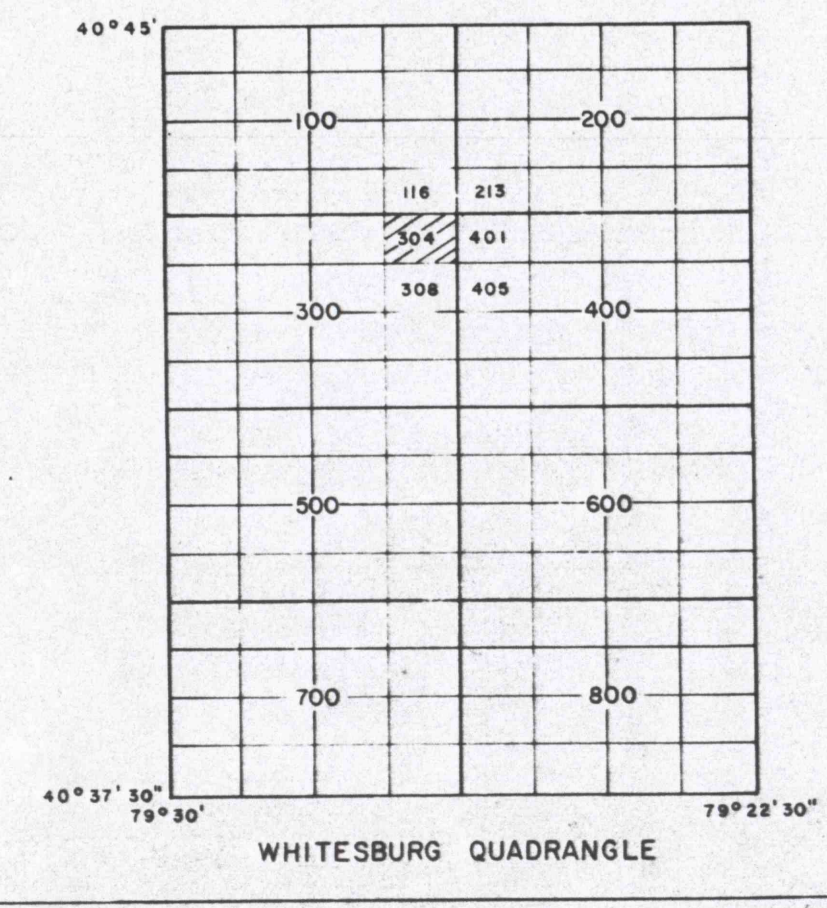


David E. Yingling

UPPER FREEPORT SEAM
 MARGARET NO. II - NO. 3 PORTAL (MSHA) NO. 36-08139
 PERMIT (DER) NO. 03851304

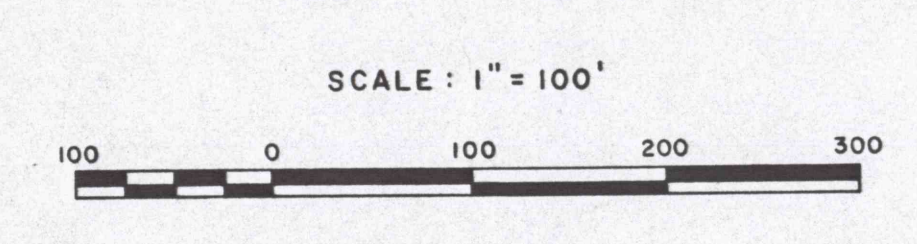

Prepared By
 MICHAEL BAKER, JR., INC.
 Consulting Engineers
 Beaver, Pennsylvania

FINAL POSTING 11/18/94
 KEYSTONE COAL MINING CORP
 MARGARET NO. II - NO. 3 PORTAL
 KIT TANNING TOWNSHIP
 WHITESBURG AREA
 ARMSTRONG COUNTY
 WHITESBURG QUADRANGLE
 SHEET NO. 403730 - 792230/304

MARG - II - No. 3 - 304