


assessed value \$2200. approx. 10 acres.  
average coal height 64 inches Pbg. Seam.

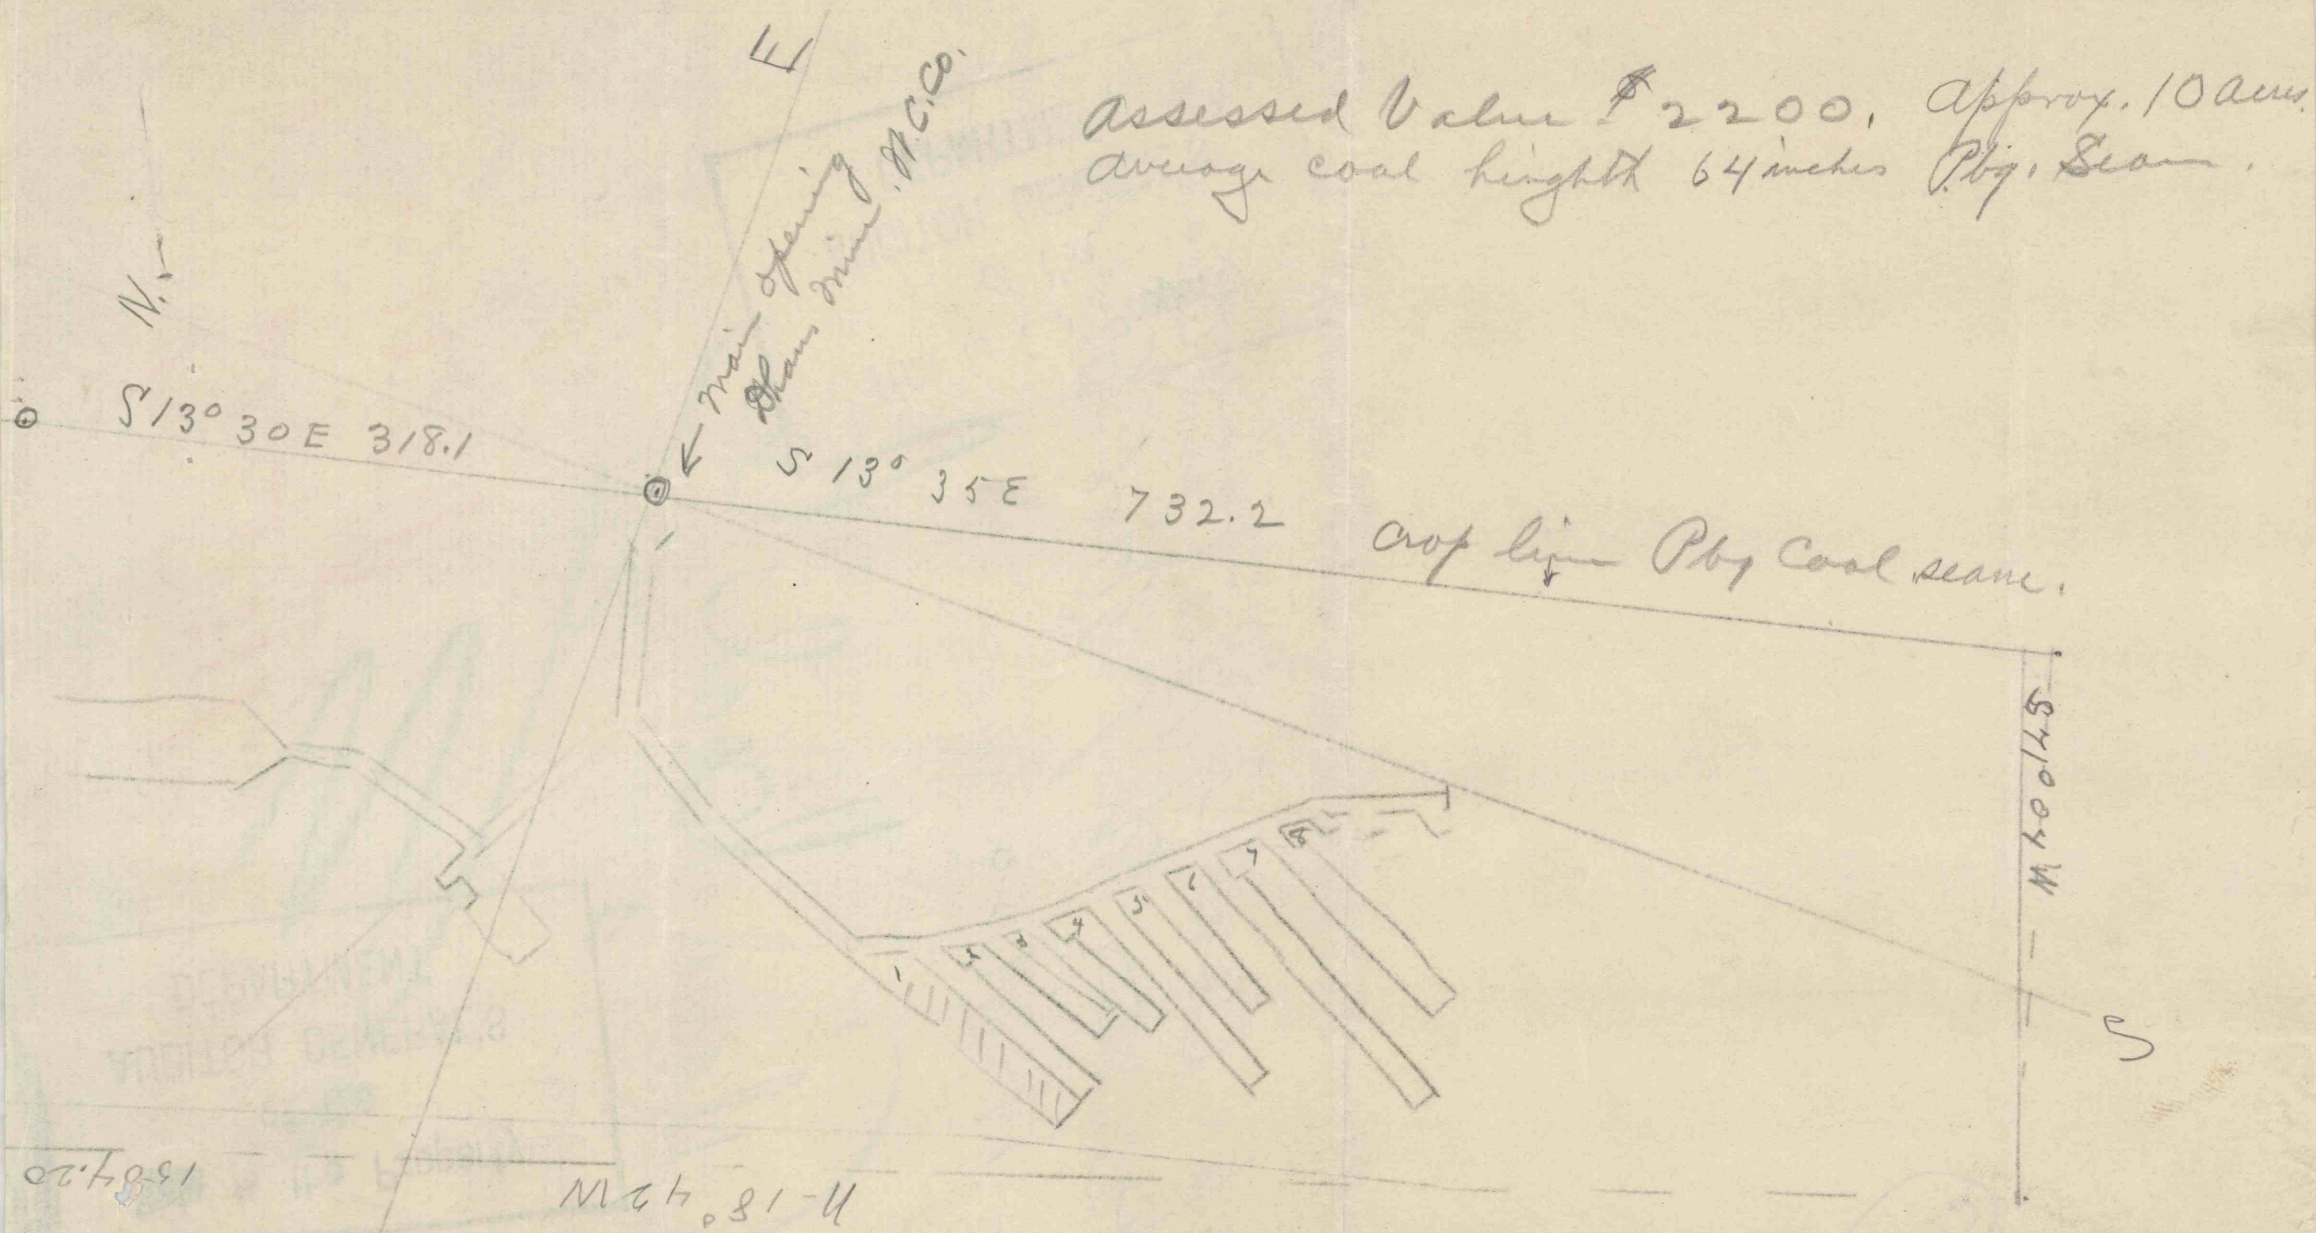

Westland Coal Co.  
Mount Pleasant Twp.  
Washington Co. Pa.

Pittsburg Coal Seam. Scale 1" = 100 ft.