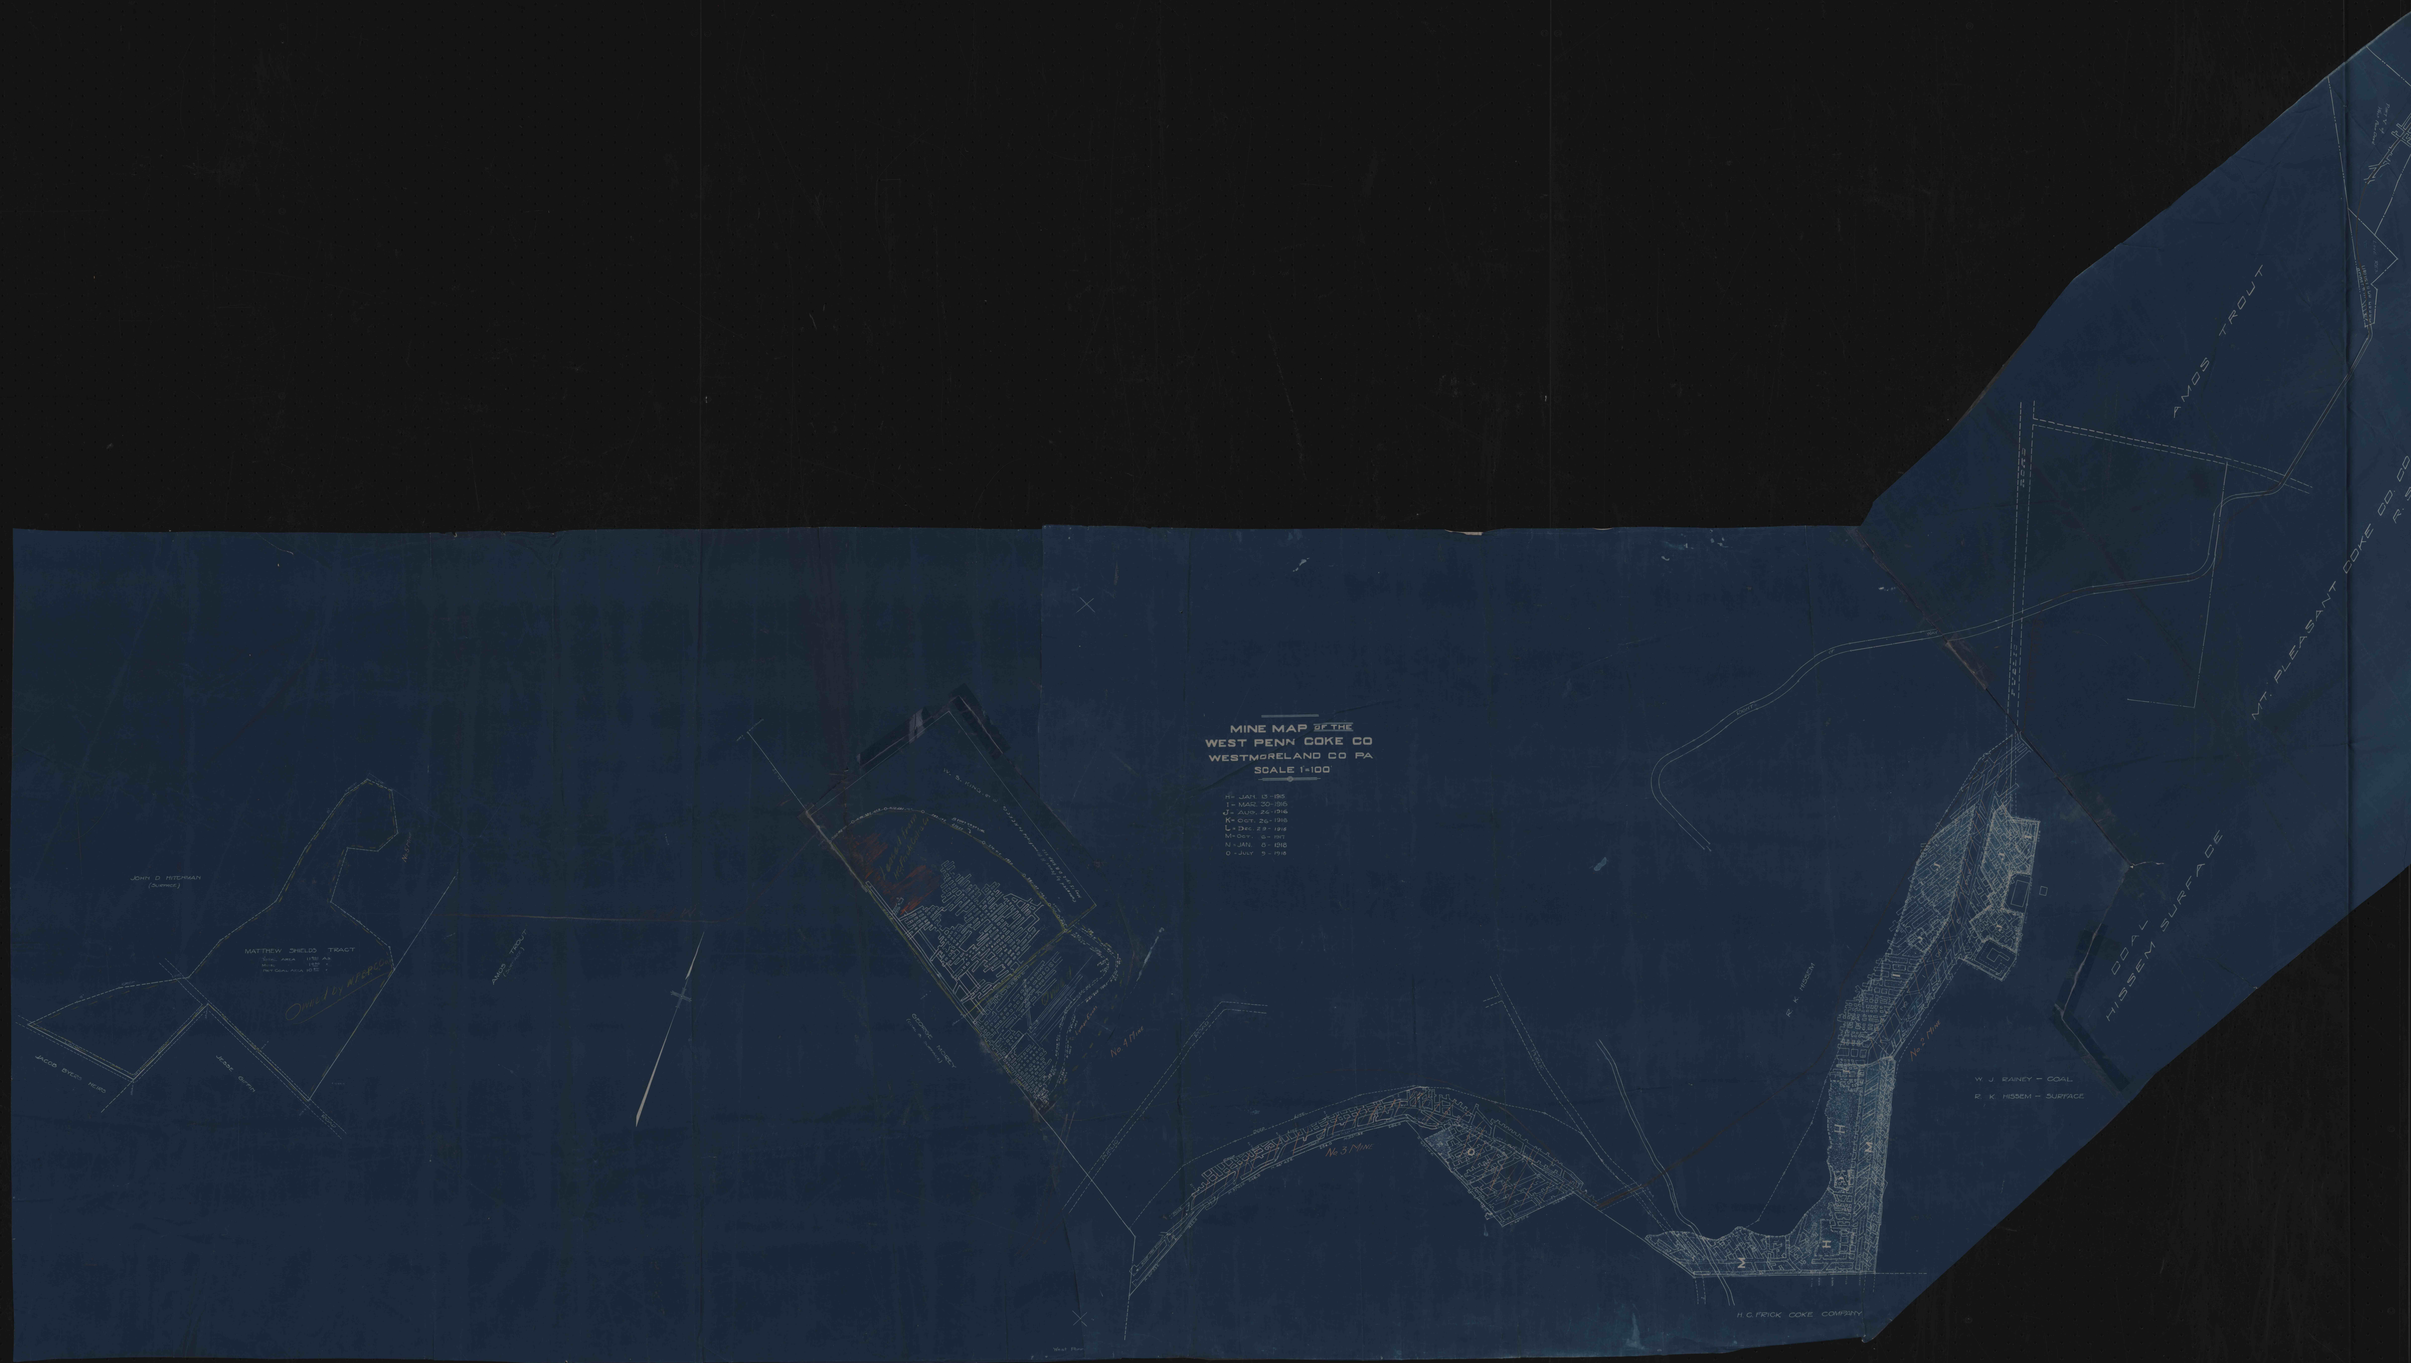
MINE MAP OF THE
WEST PENN COKE CO
WESTMORELAND CO PA
SCALE 1"=100'
H- JAN. 13-1915
I- MAR. 30-1916
J- AUG. 24-1916
K- OCT. 26-1916
L- DEC. 28-1916
M- DEC. 6-1917
N- JAN. 8-1918
O- JULY 5-1918
JOHN D. HITCHMAN
(SURFACE)
MATTHEW SHIELDS TRACT
JACOB BYERS HEIRS
JESSE GRIFFIN
AMOS TROUT
No. 4 Mine
No. 3 Mine
No. 2 Mine
R. K. HISSEM
W. J. RAINEY - COAL
R. K. HISSEM - SURFACE
H. C. FRICK COKE COMPANY
COAL
HISSEM SURFACE
MT. PLEASANT COKE CO. CO.