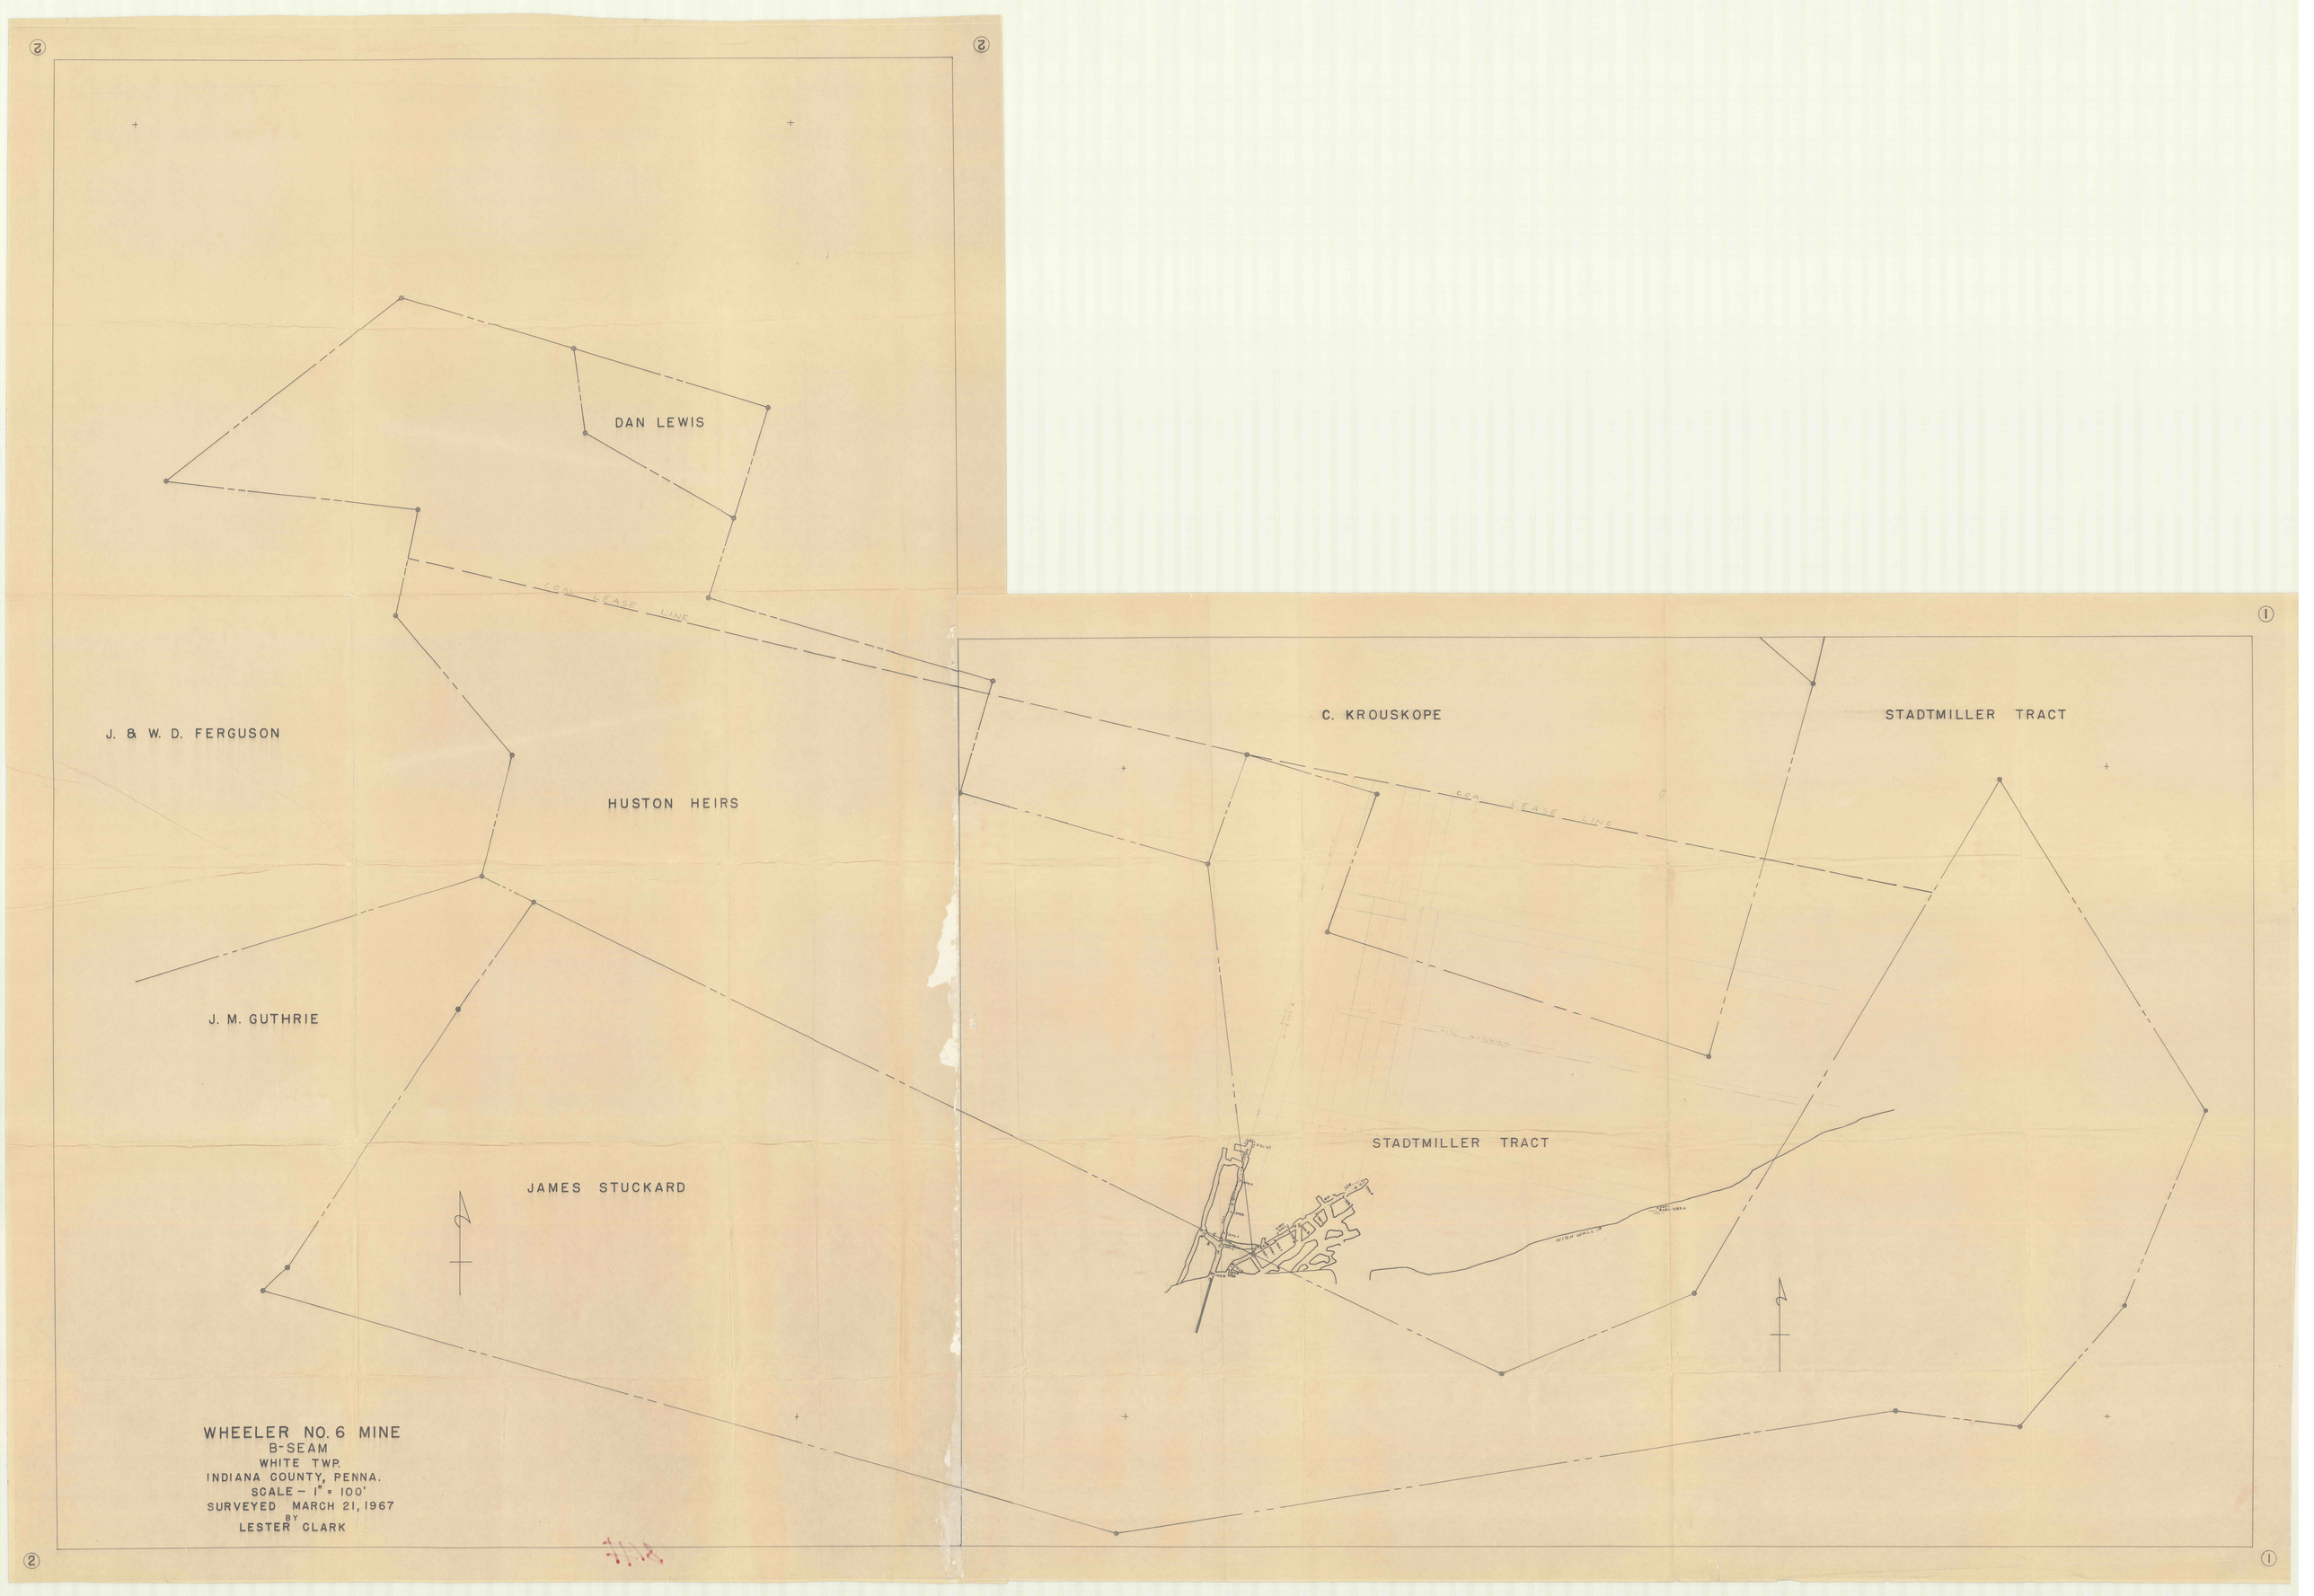
DAN LEWIS
COAL LEASE LINE
J. & W. D. FERGUSON
HUSTON HEIRS
J. M. GUTHRIE
JAMES STUCKARD
C. KROUSKOPE
STADTMILLER TRACT
COAL LEASE LINE
STADTMILLER TRACT
HIGH WALL
WHEELER NO. 6 MINE
B-SEAM
WHITE TWP.
INDIANA COUNTY, PENNA.
SCALE – 1" = 100'
SURVEYED MARCH 21, 1967
BY
LESTER CLARK