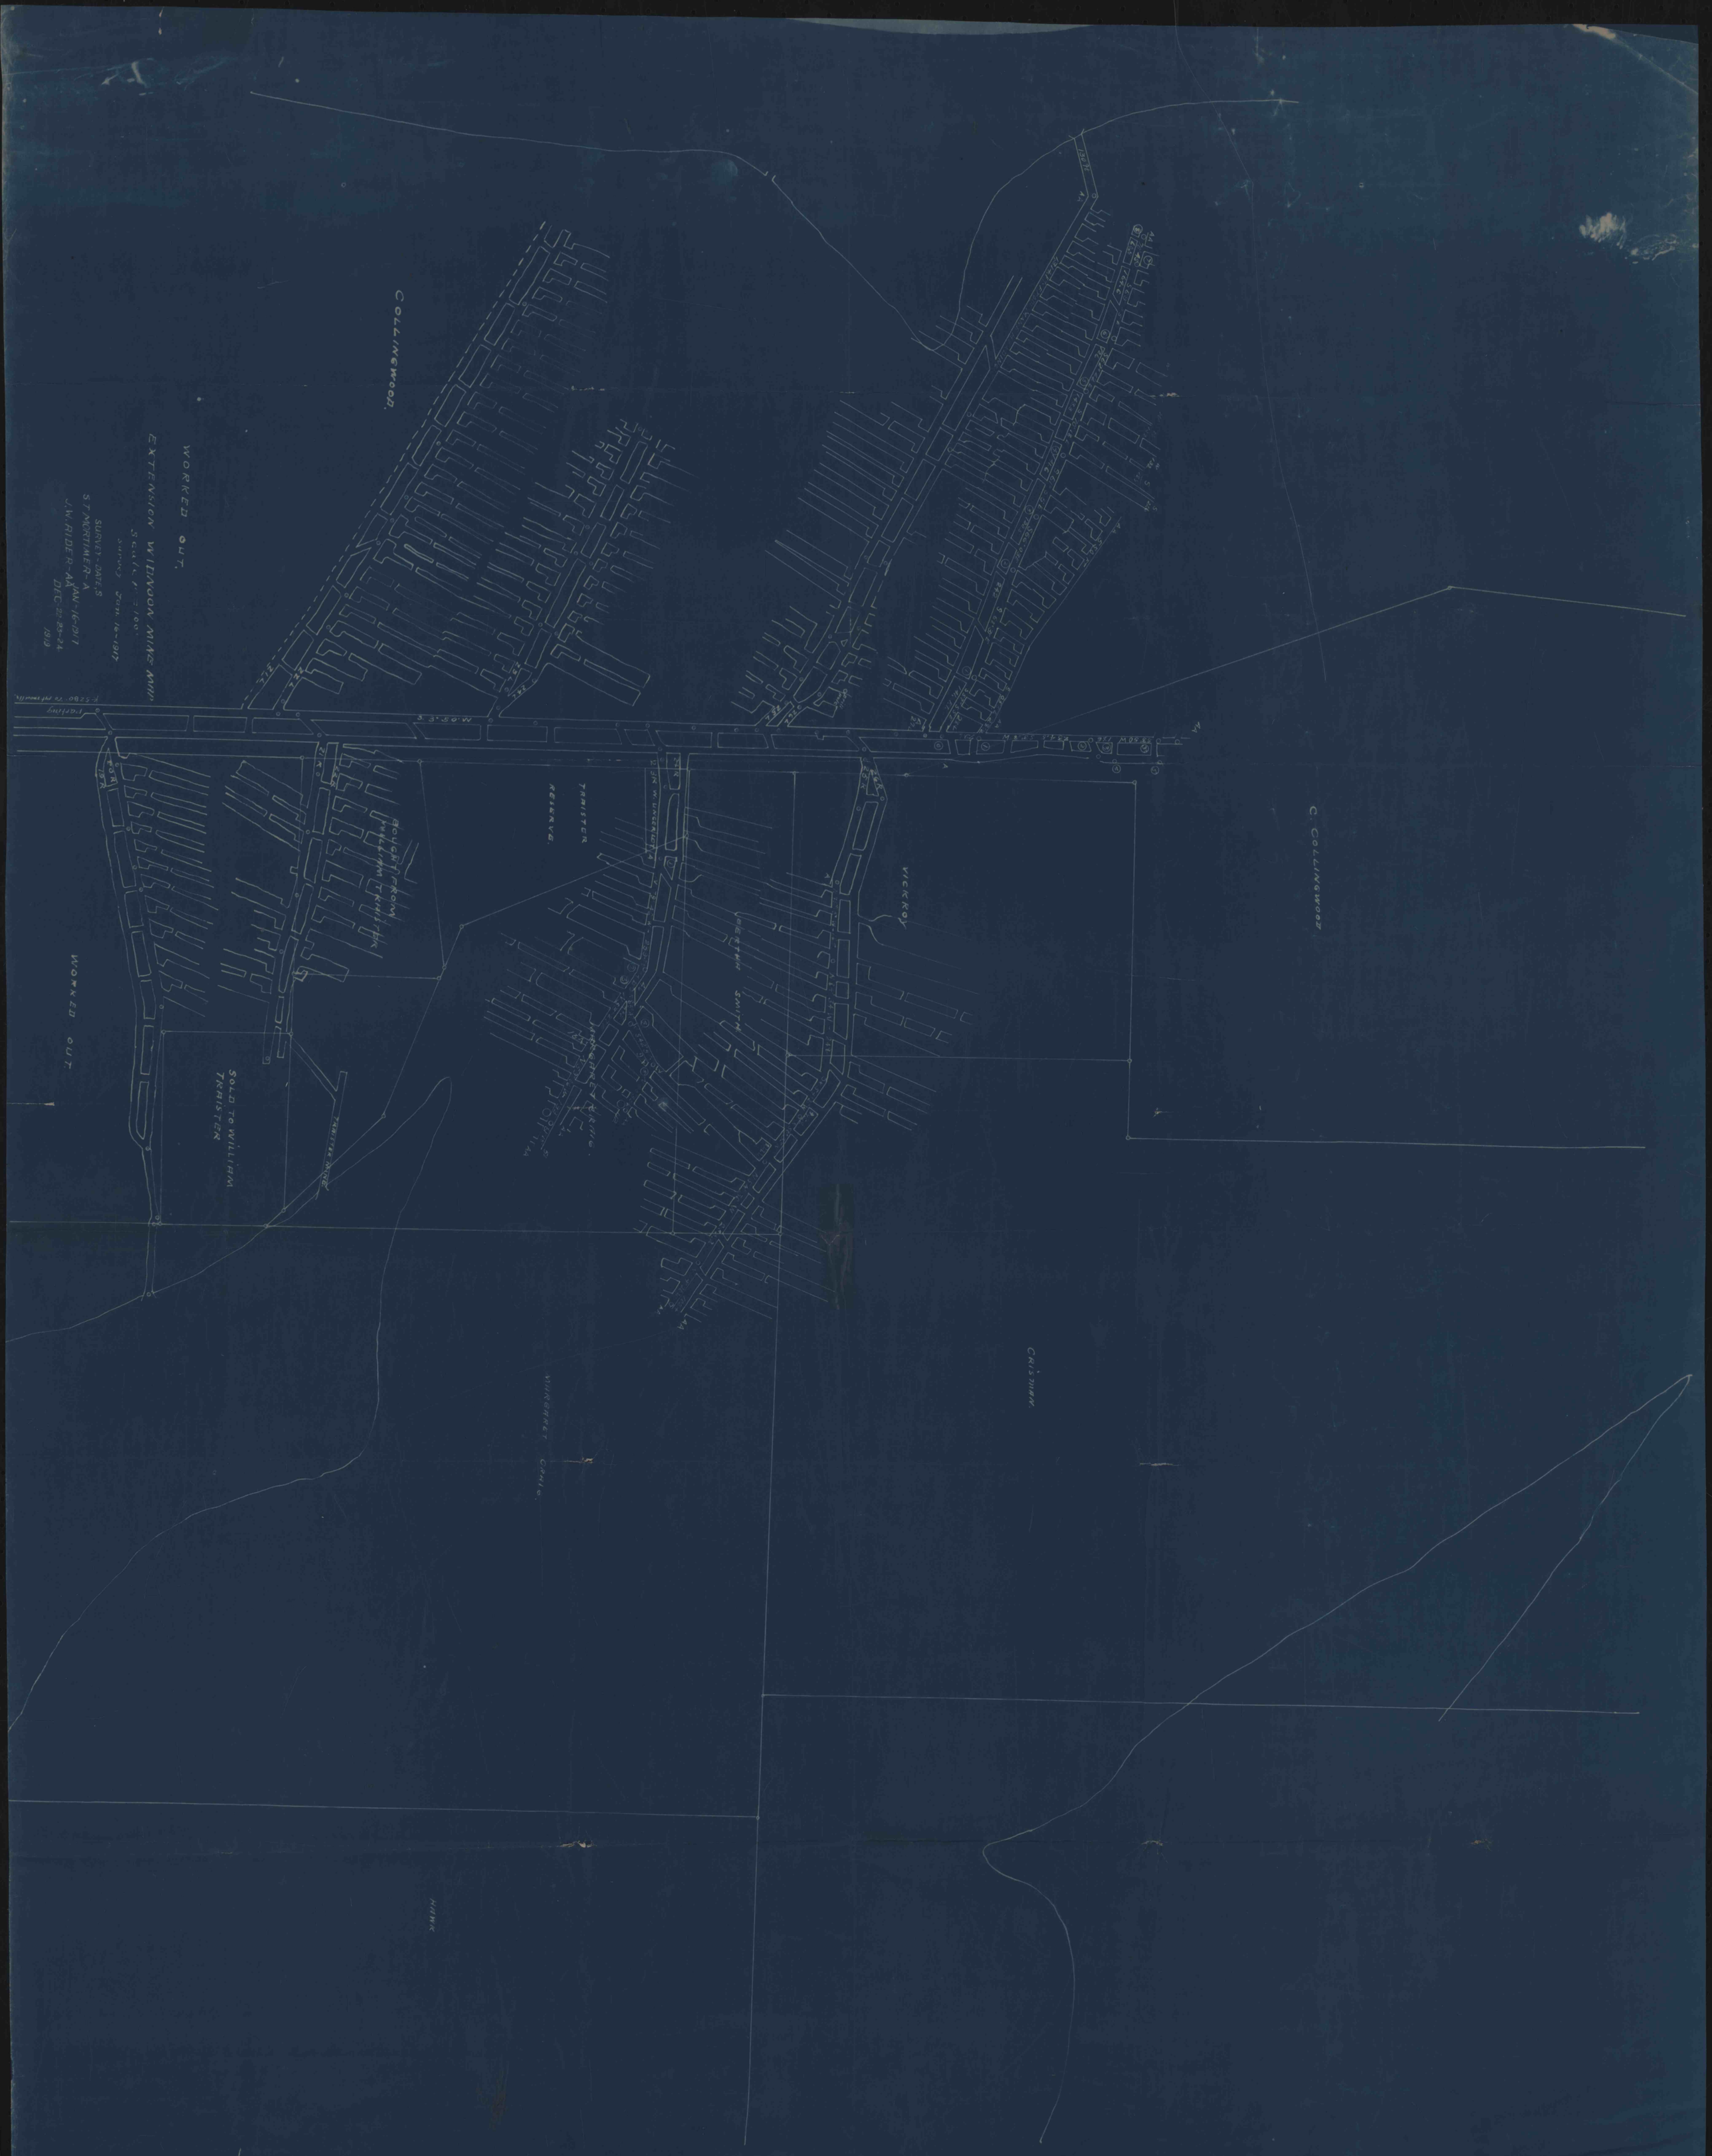
WORKED OUT.
EXTENSION WIDNOON MINE MAP
SCALE 1" = 100'
SURVEY FEB. 16-1917
SURVEY-DATES
ST MORTIMER-A
J.W. RIDER-AA
JAN-16-1917
DEC-22-23-24
1919
COLLINGWOOD.
WORKED OUT
SOLD TO WILLIAM TRAISTER
TRAISTER MINE
BOUGHT FROM WILLIAM TRAISTER
TRAISTER RESERVE
JAS. W. WOODWORTH
VICKROY
BERTHA SMITH
COLLINGWOOD
CRISMAN
WINGERT
HAWK