


WIGTON COAL CO.

*Part 11
1 in = 100 ft*

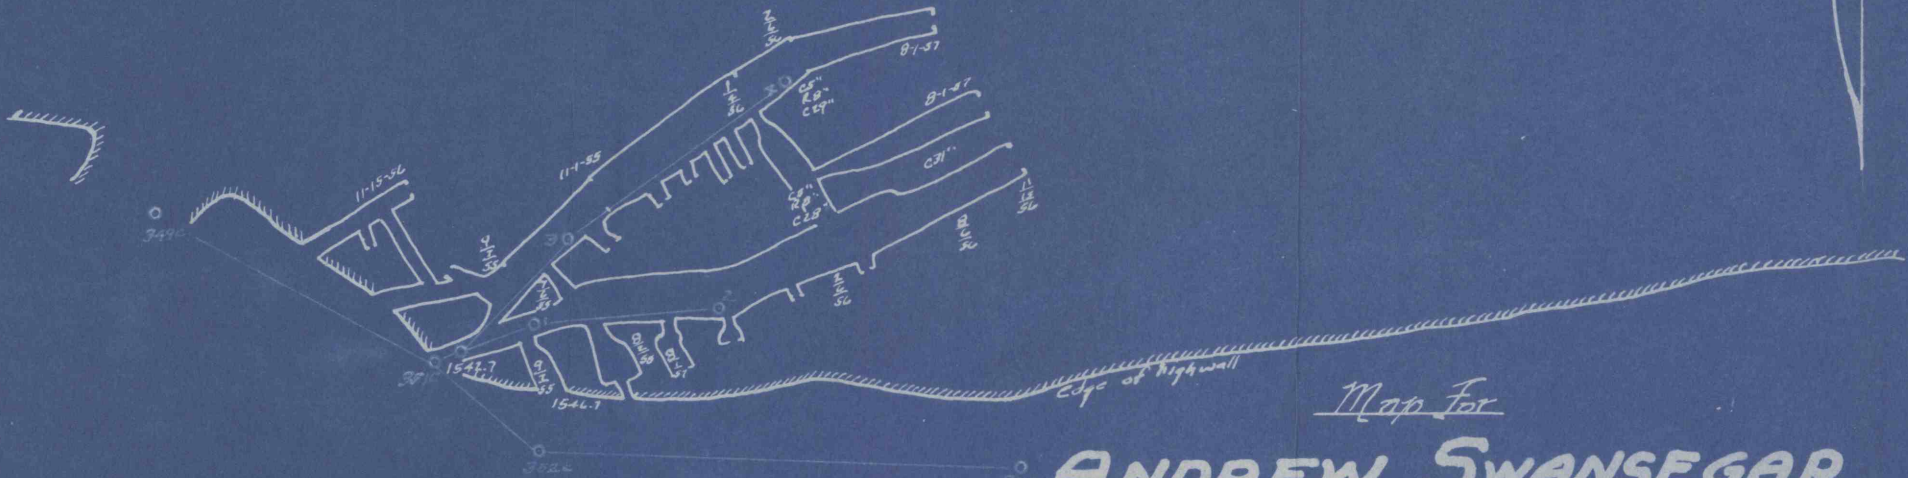

Map For
ANDREW SWANSEGAR
Showing
"C" prime Deep Mine Operation

Morris Township *Clearfield Co. Pa.*

Scale 1 in = 100 ft.

August 14, 1957

E. L. Gray

DIST 8