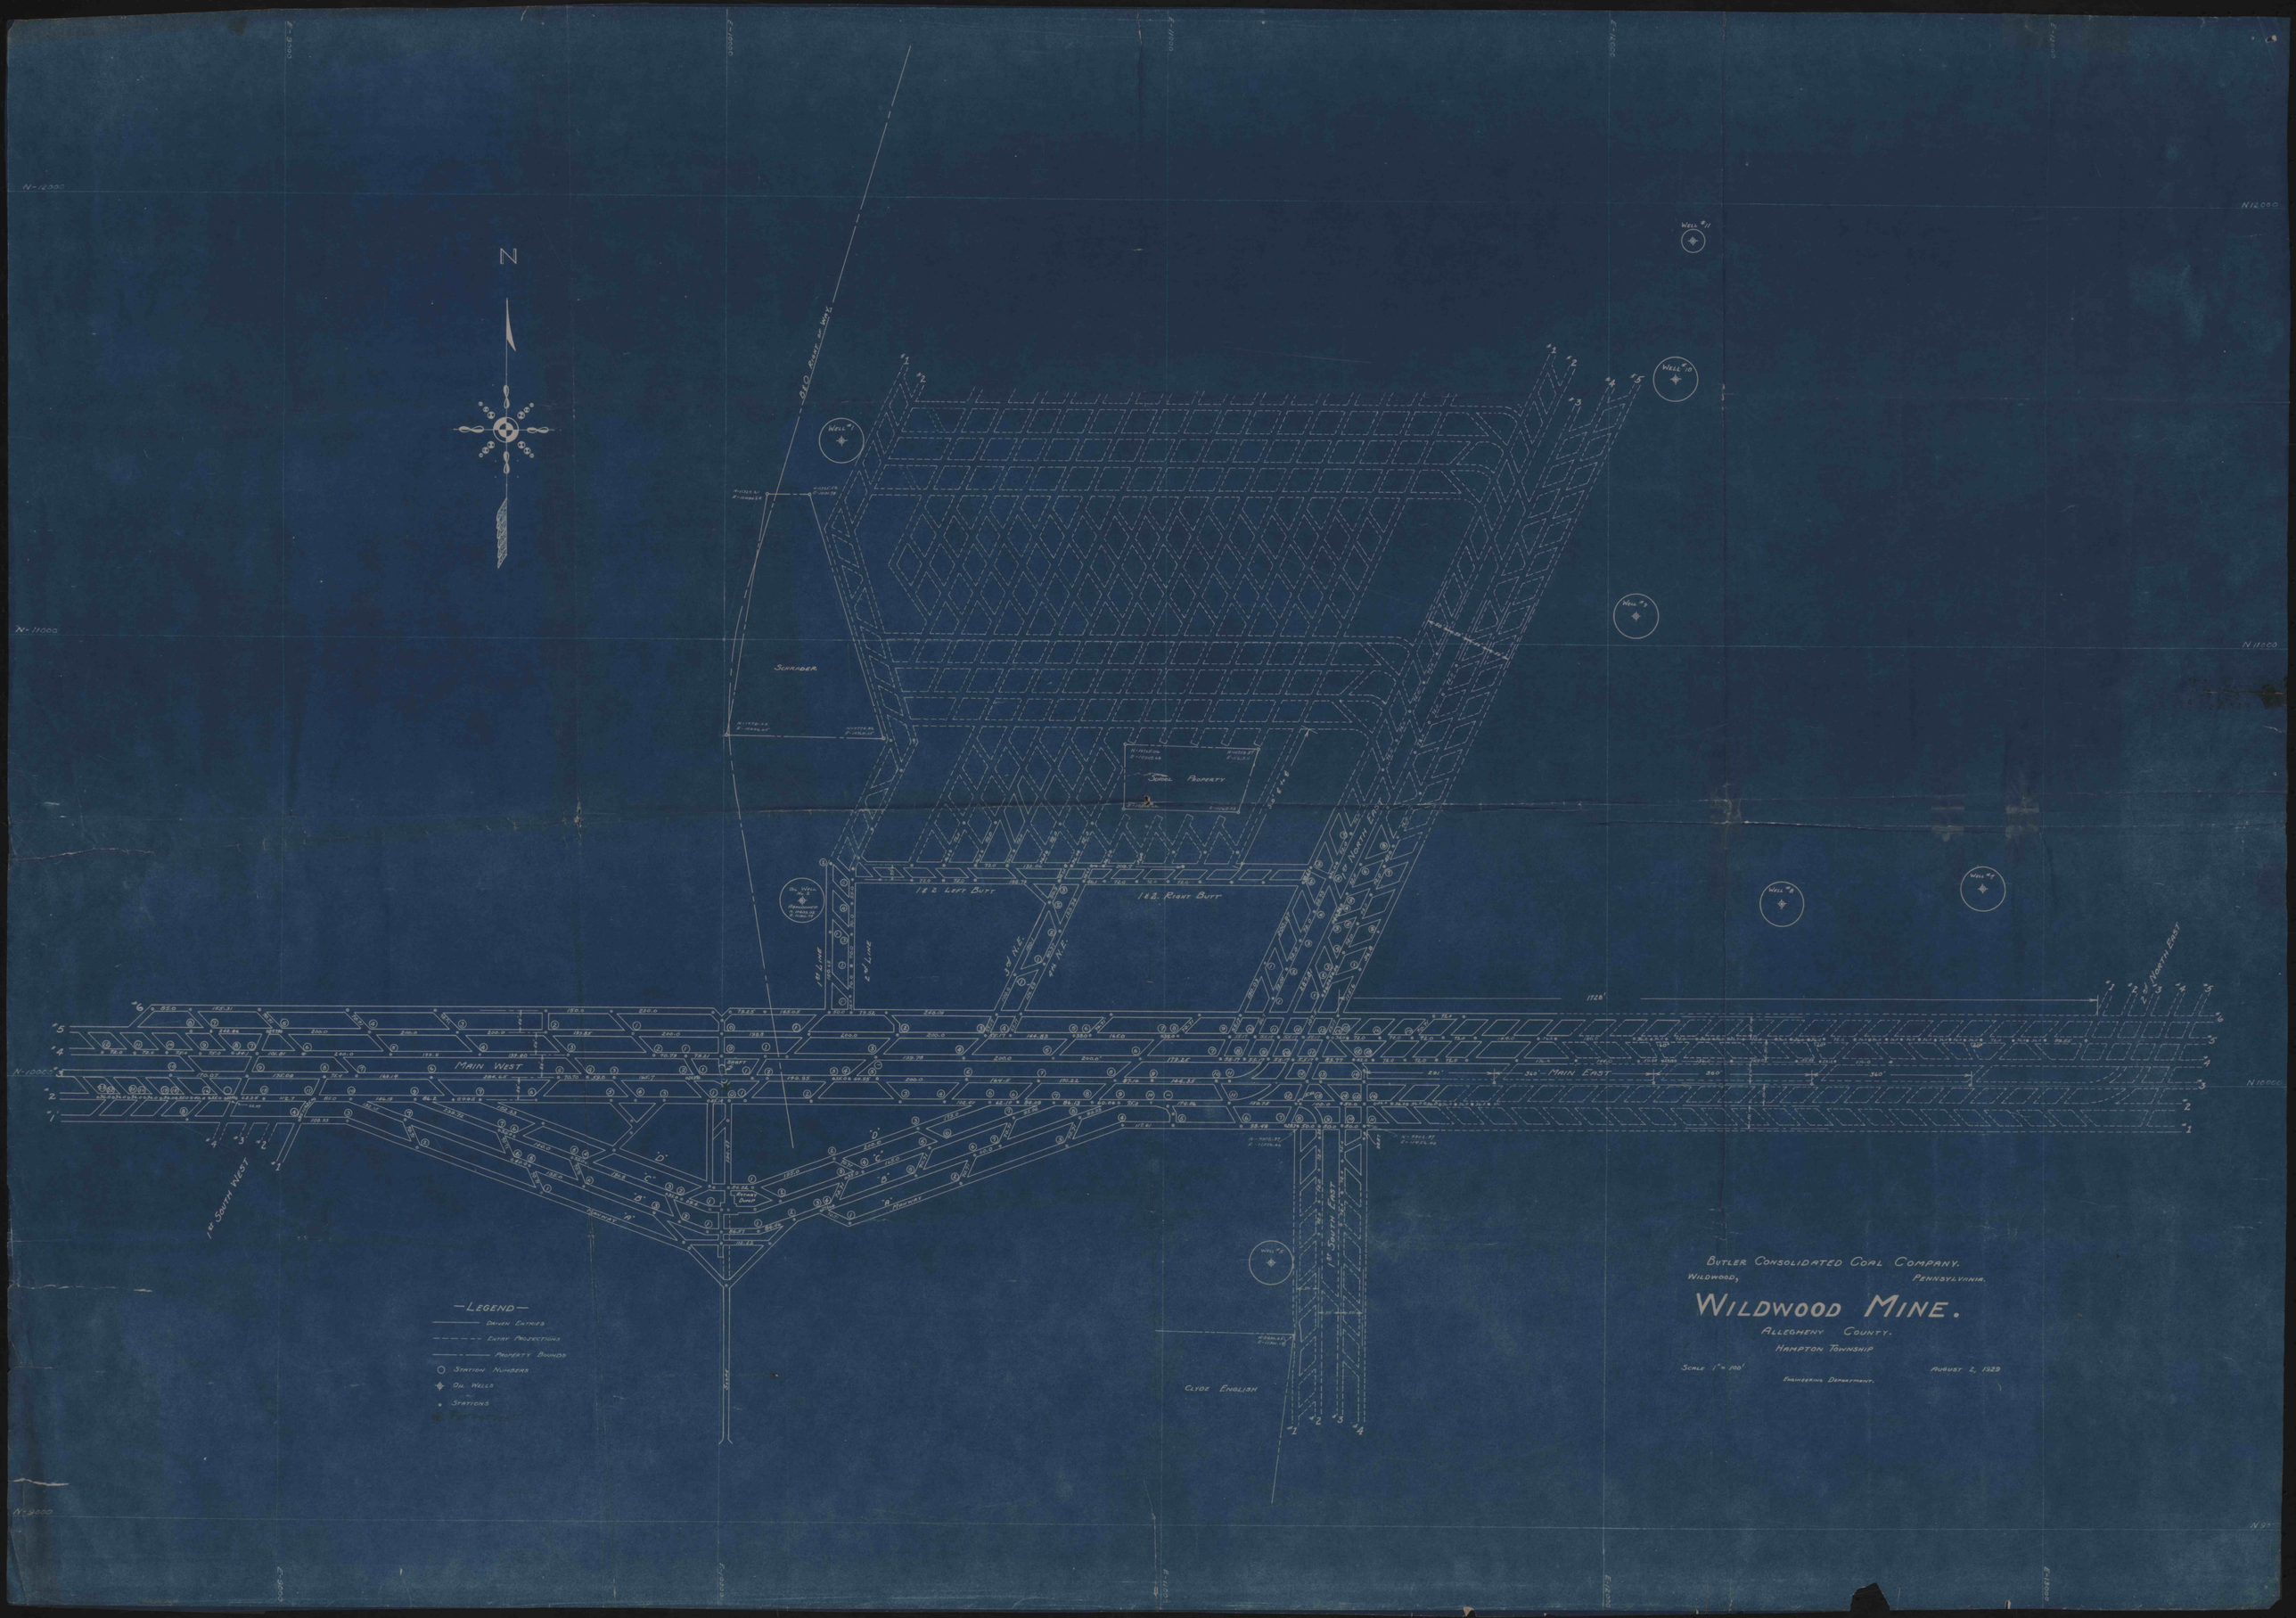
N
Well #1
Well #3
Well #4
Well #5
Well #7
Well #8
Well #10
Well #11
Schrader
School Property
1 & 2 Left Butt
1 & 2 Right Butt
Main West
Main East
1st South West
1st South East
2nd North East
Clyde English
Legend
Driven Entries
Entry Projections
Property Bounds
Station Numbers
Oil Wells
Stations
Butler Consolidated Coal Company.
Wildwood, Pennsylvania.
Wildwood Mine.
Allegheny County.
Hampton Township
Scale 1" = 100'
August 2, 1929
Engineering Department.