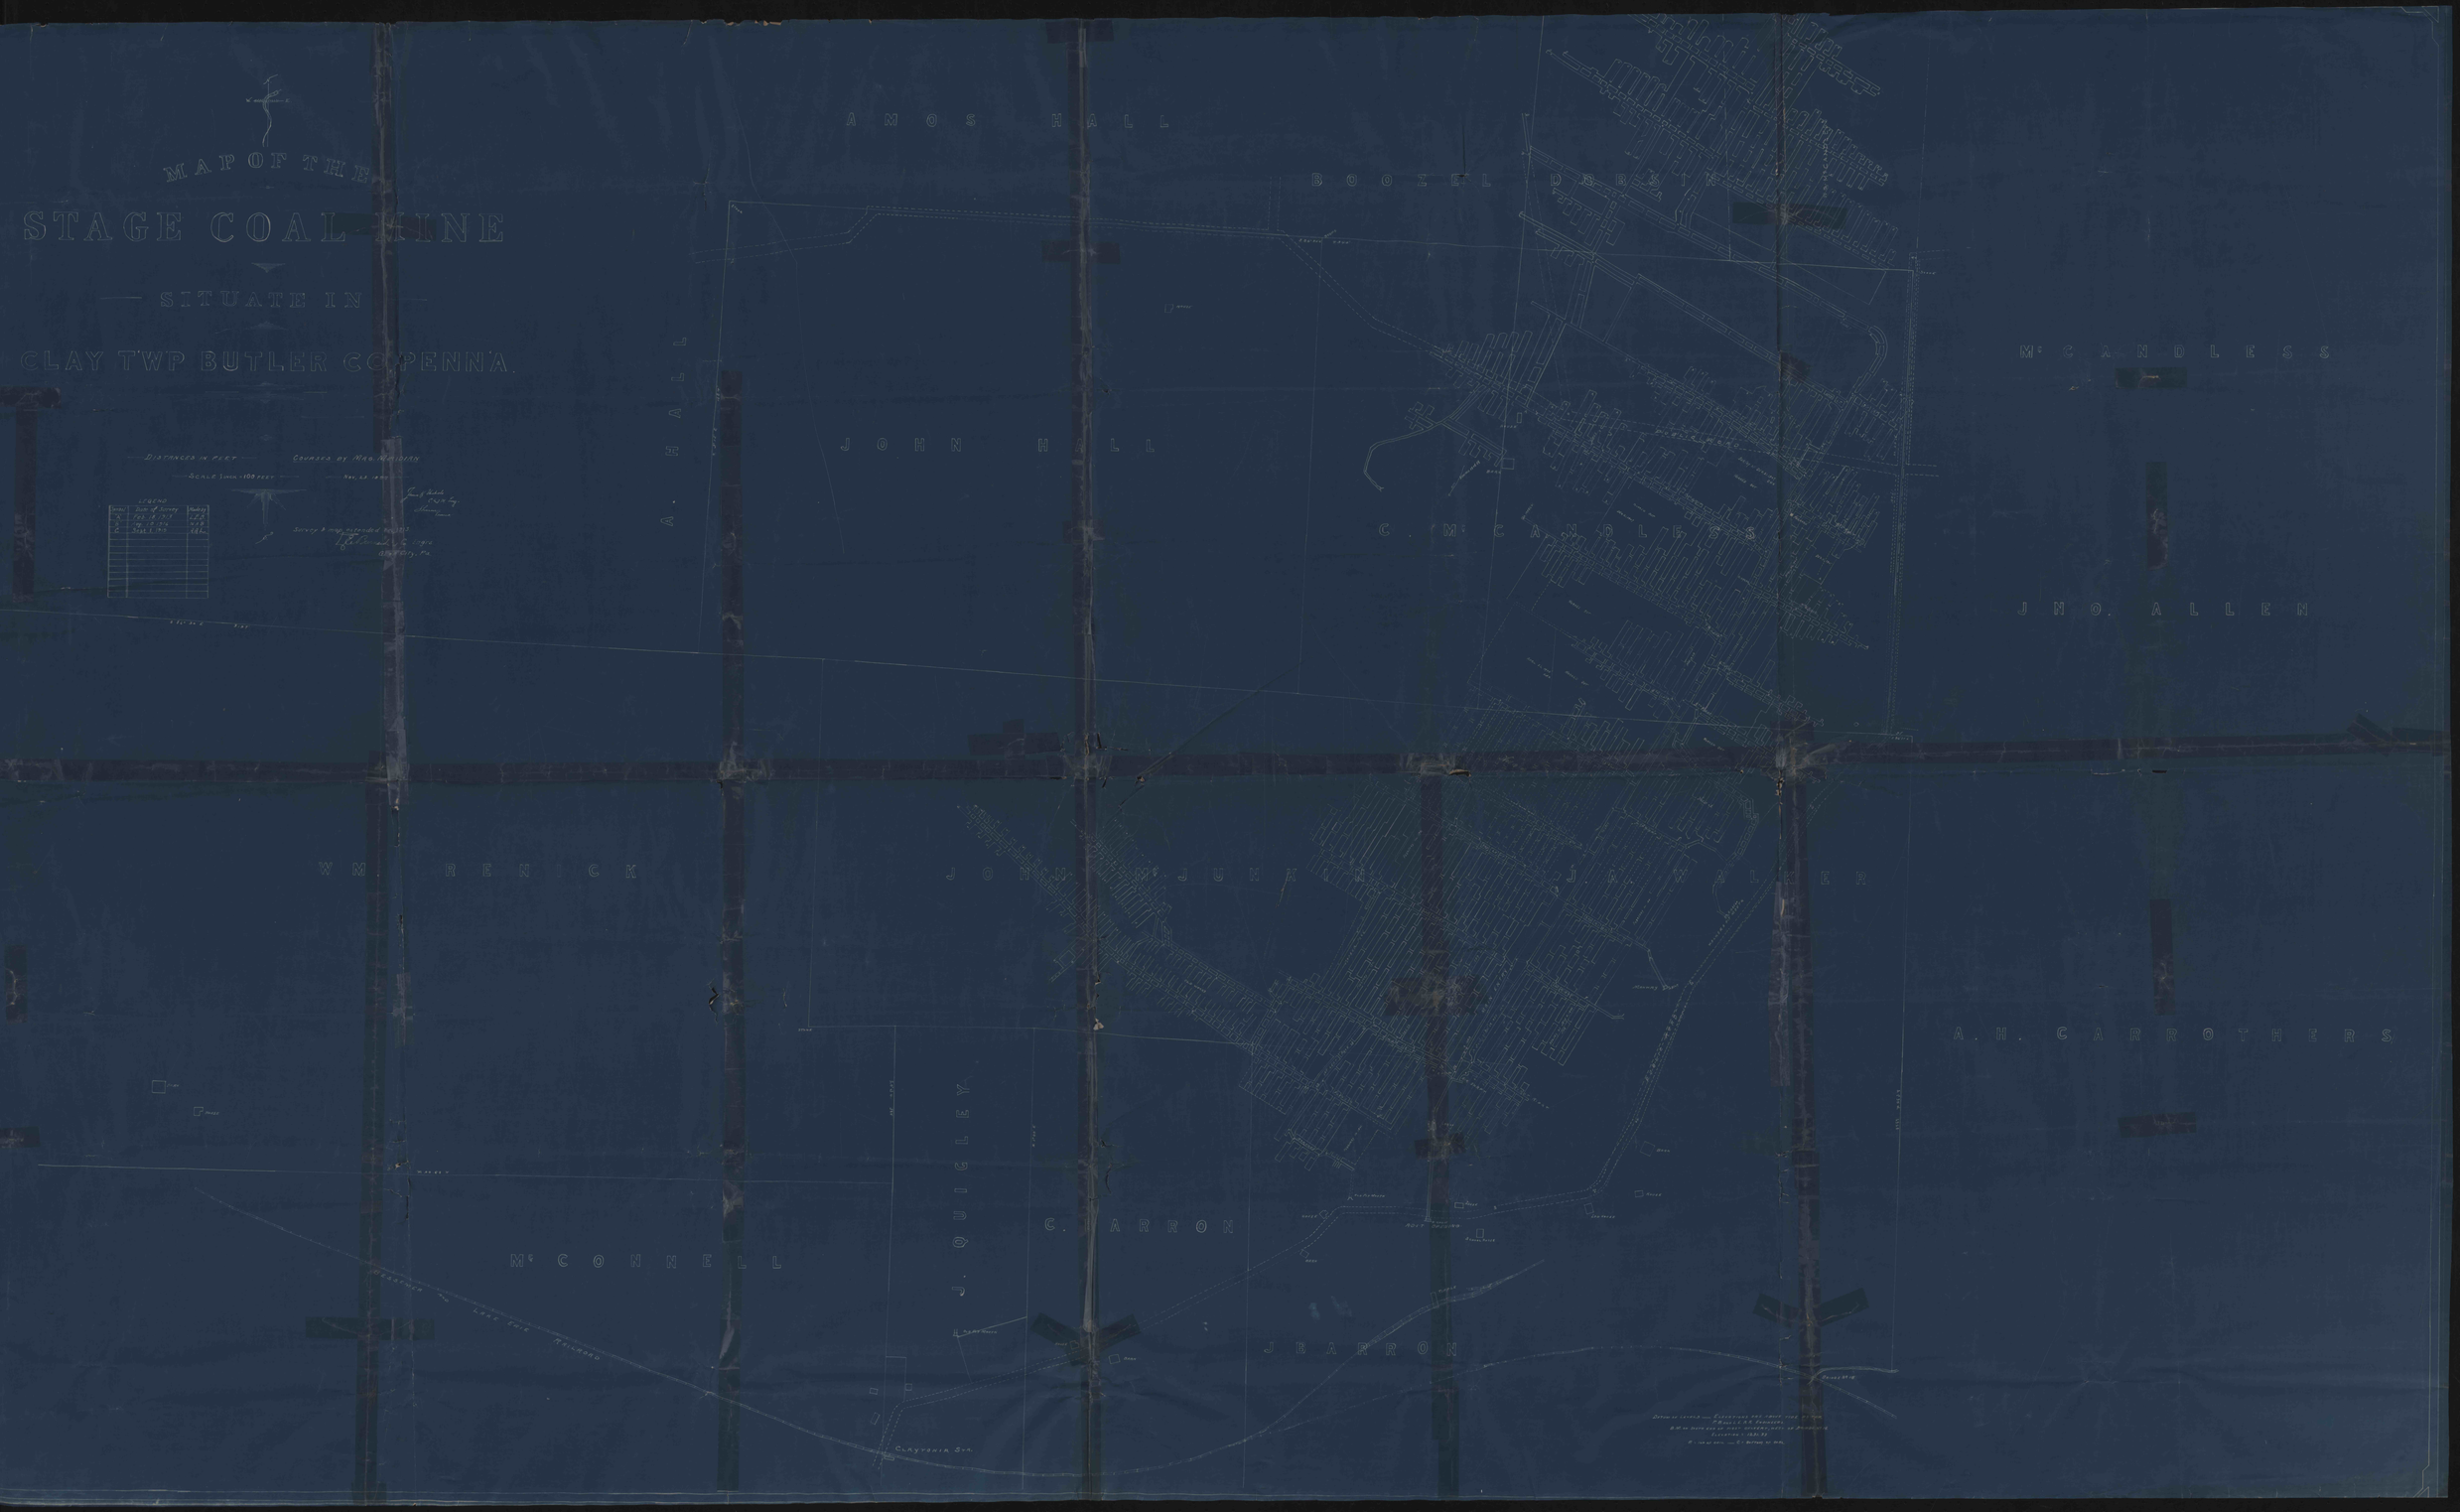
MAP OF THE
STAGE COAL MINE
SITUATE IN
CLAY TWP BUTLER CO PENNA.
AMOS HALL
BOOZEL DOBSON
A. HALL
JOHN HALL
McCANDLESS
C. McCANDLESS
JNO. ALLEN
WM. RENICK
JOHN McJUNKIN
J. A. WALKER
A. H. CARROTHERS
J. QUIGLEY
C. BARRON
McCONNELL
J. BARRON