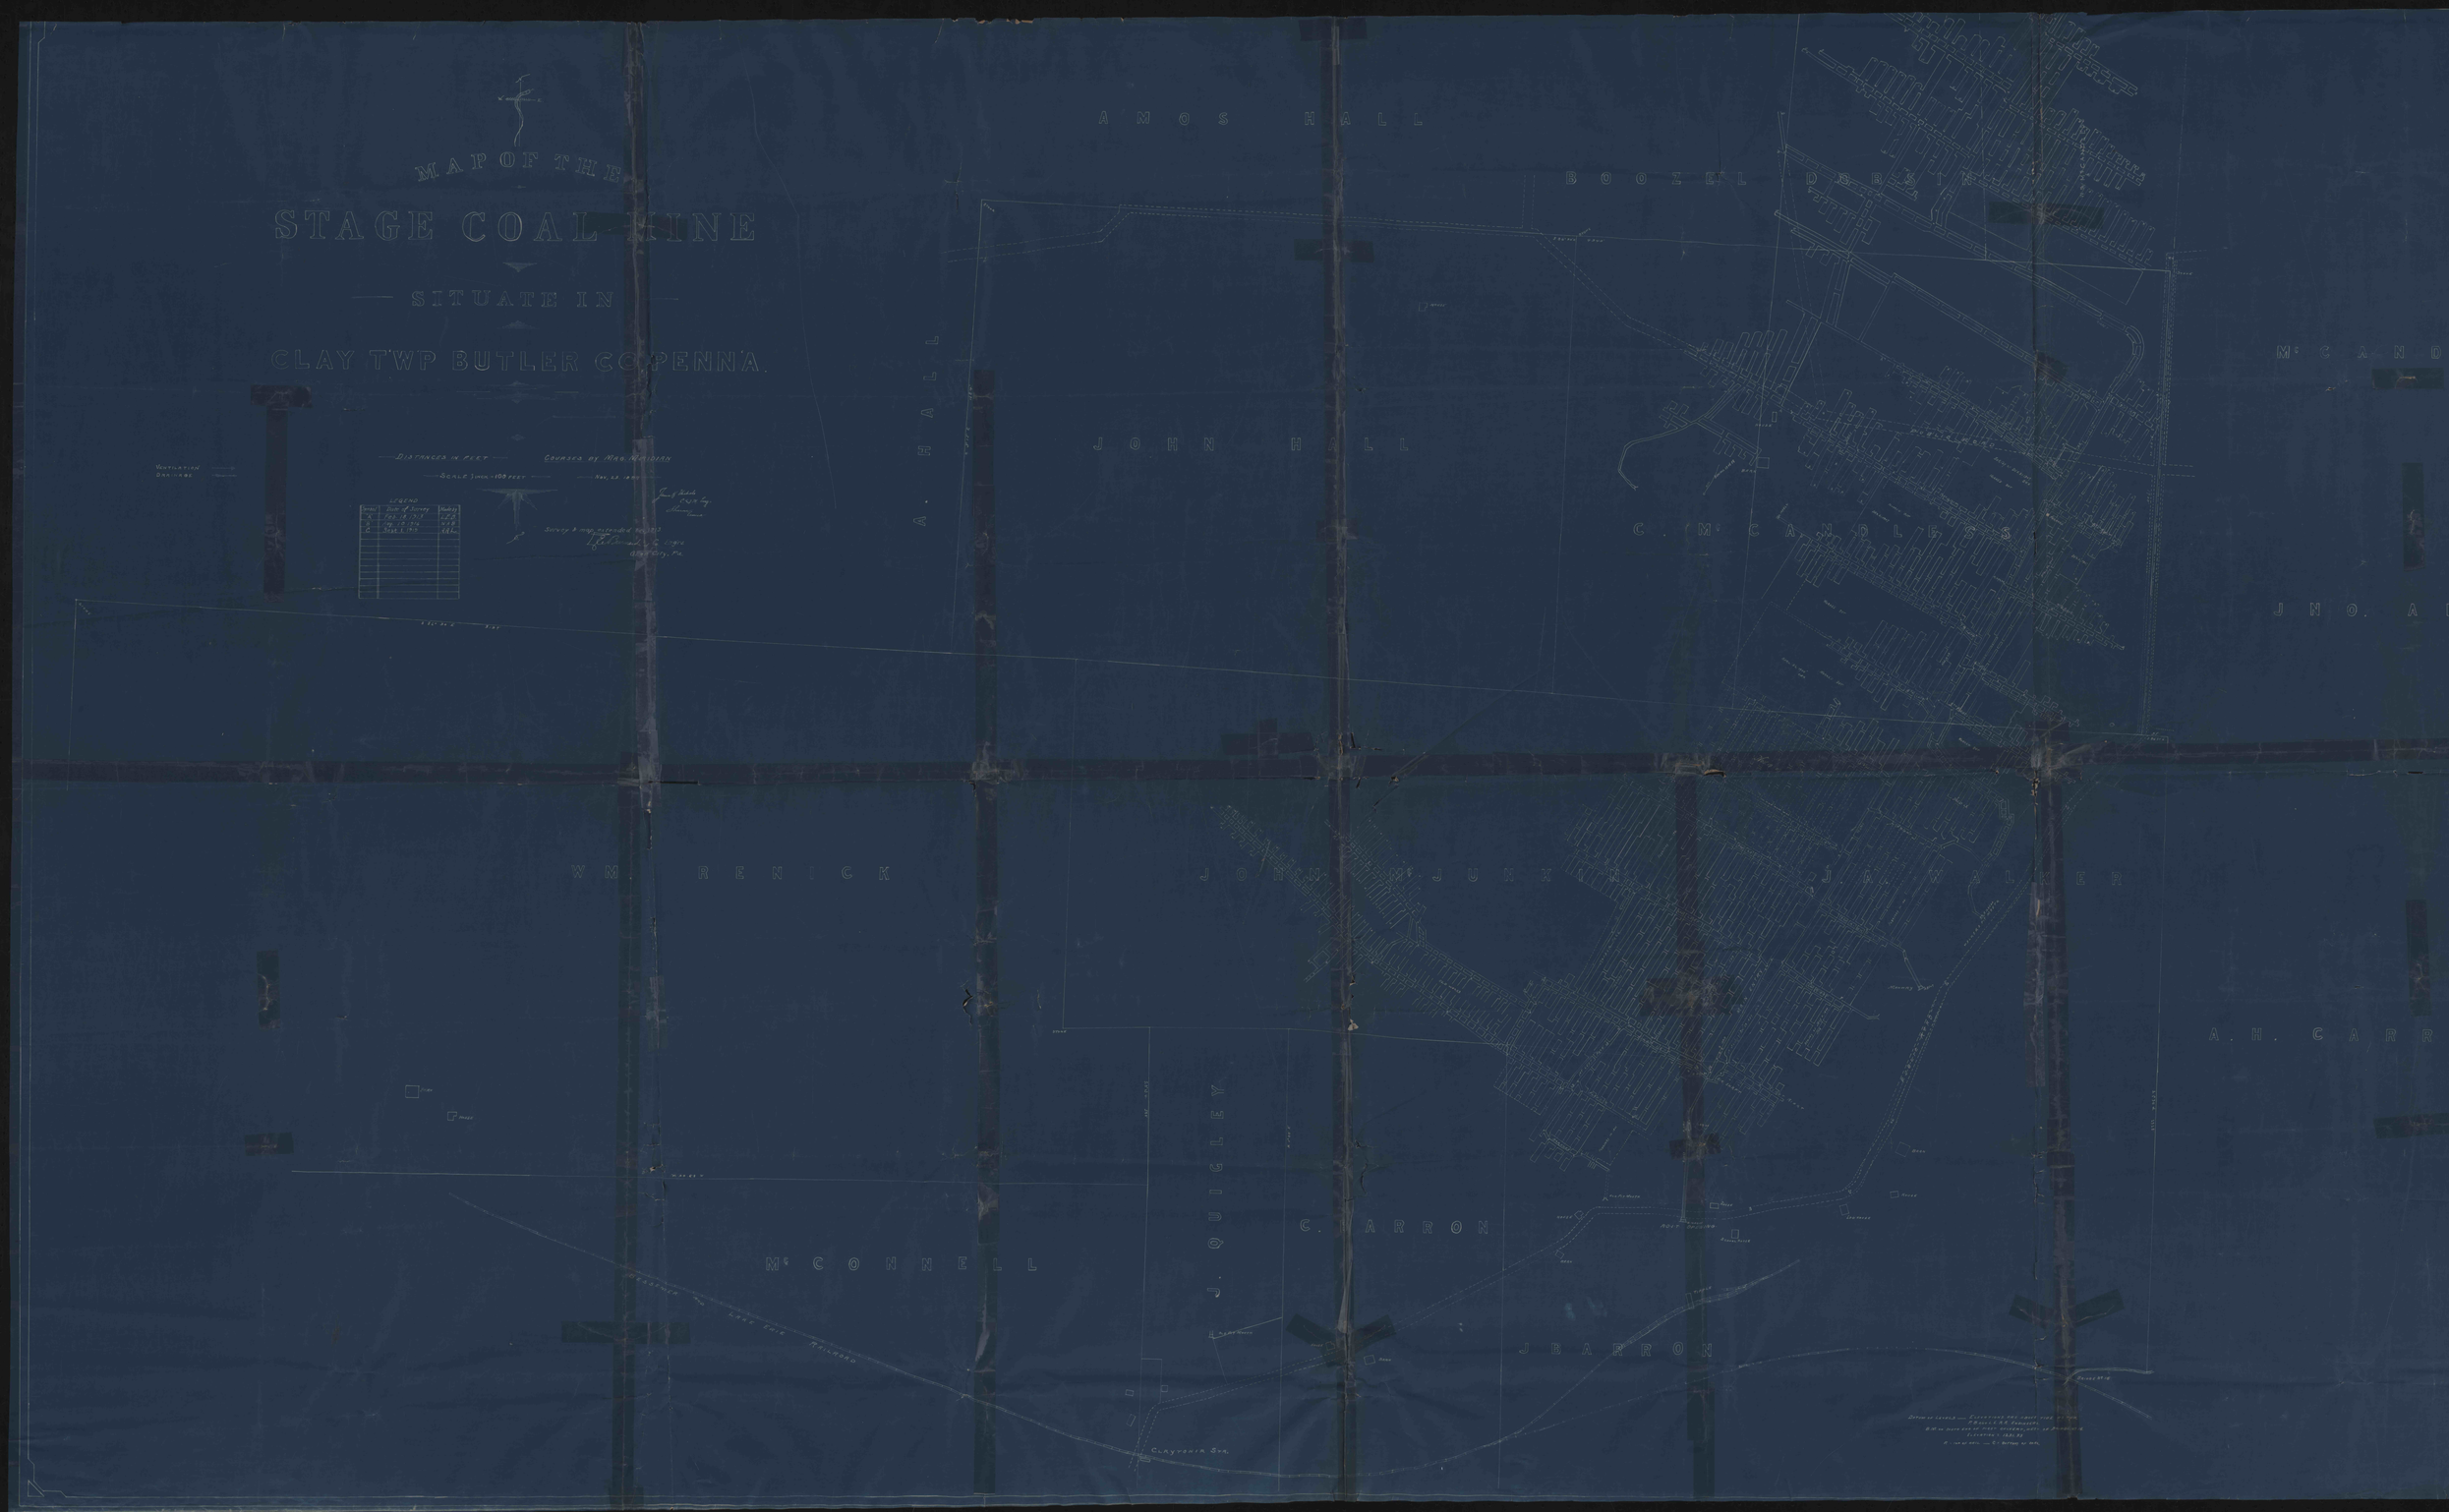
MAP OF THE
STAGE COAL MINE
SITUATE IN
CLAY TWP BUTLER CO PENNA.
DISTANCES IN FEET
COURSES BY MAG. MERIDIAN
SCALE 1 INCH = 100 FEET
LEGEND
Surveys & map extended to 1913
AMOS HALL
BOOZEL DOBSIN
A. HALL
JOHN HALL
C. McCANDLESS
McCAND
JNO. A
WM. RENICK
JOHN McJUNKIN
J. A. WALKER
A. H. CARR
McCONNELL
J. QUIGLEY
C. BARRON
J. BARRON
CLAYTONIA STA.