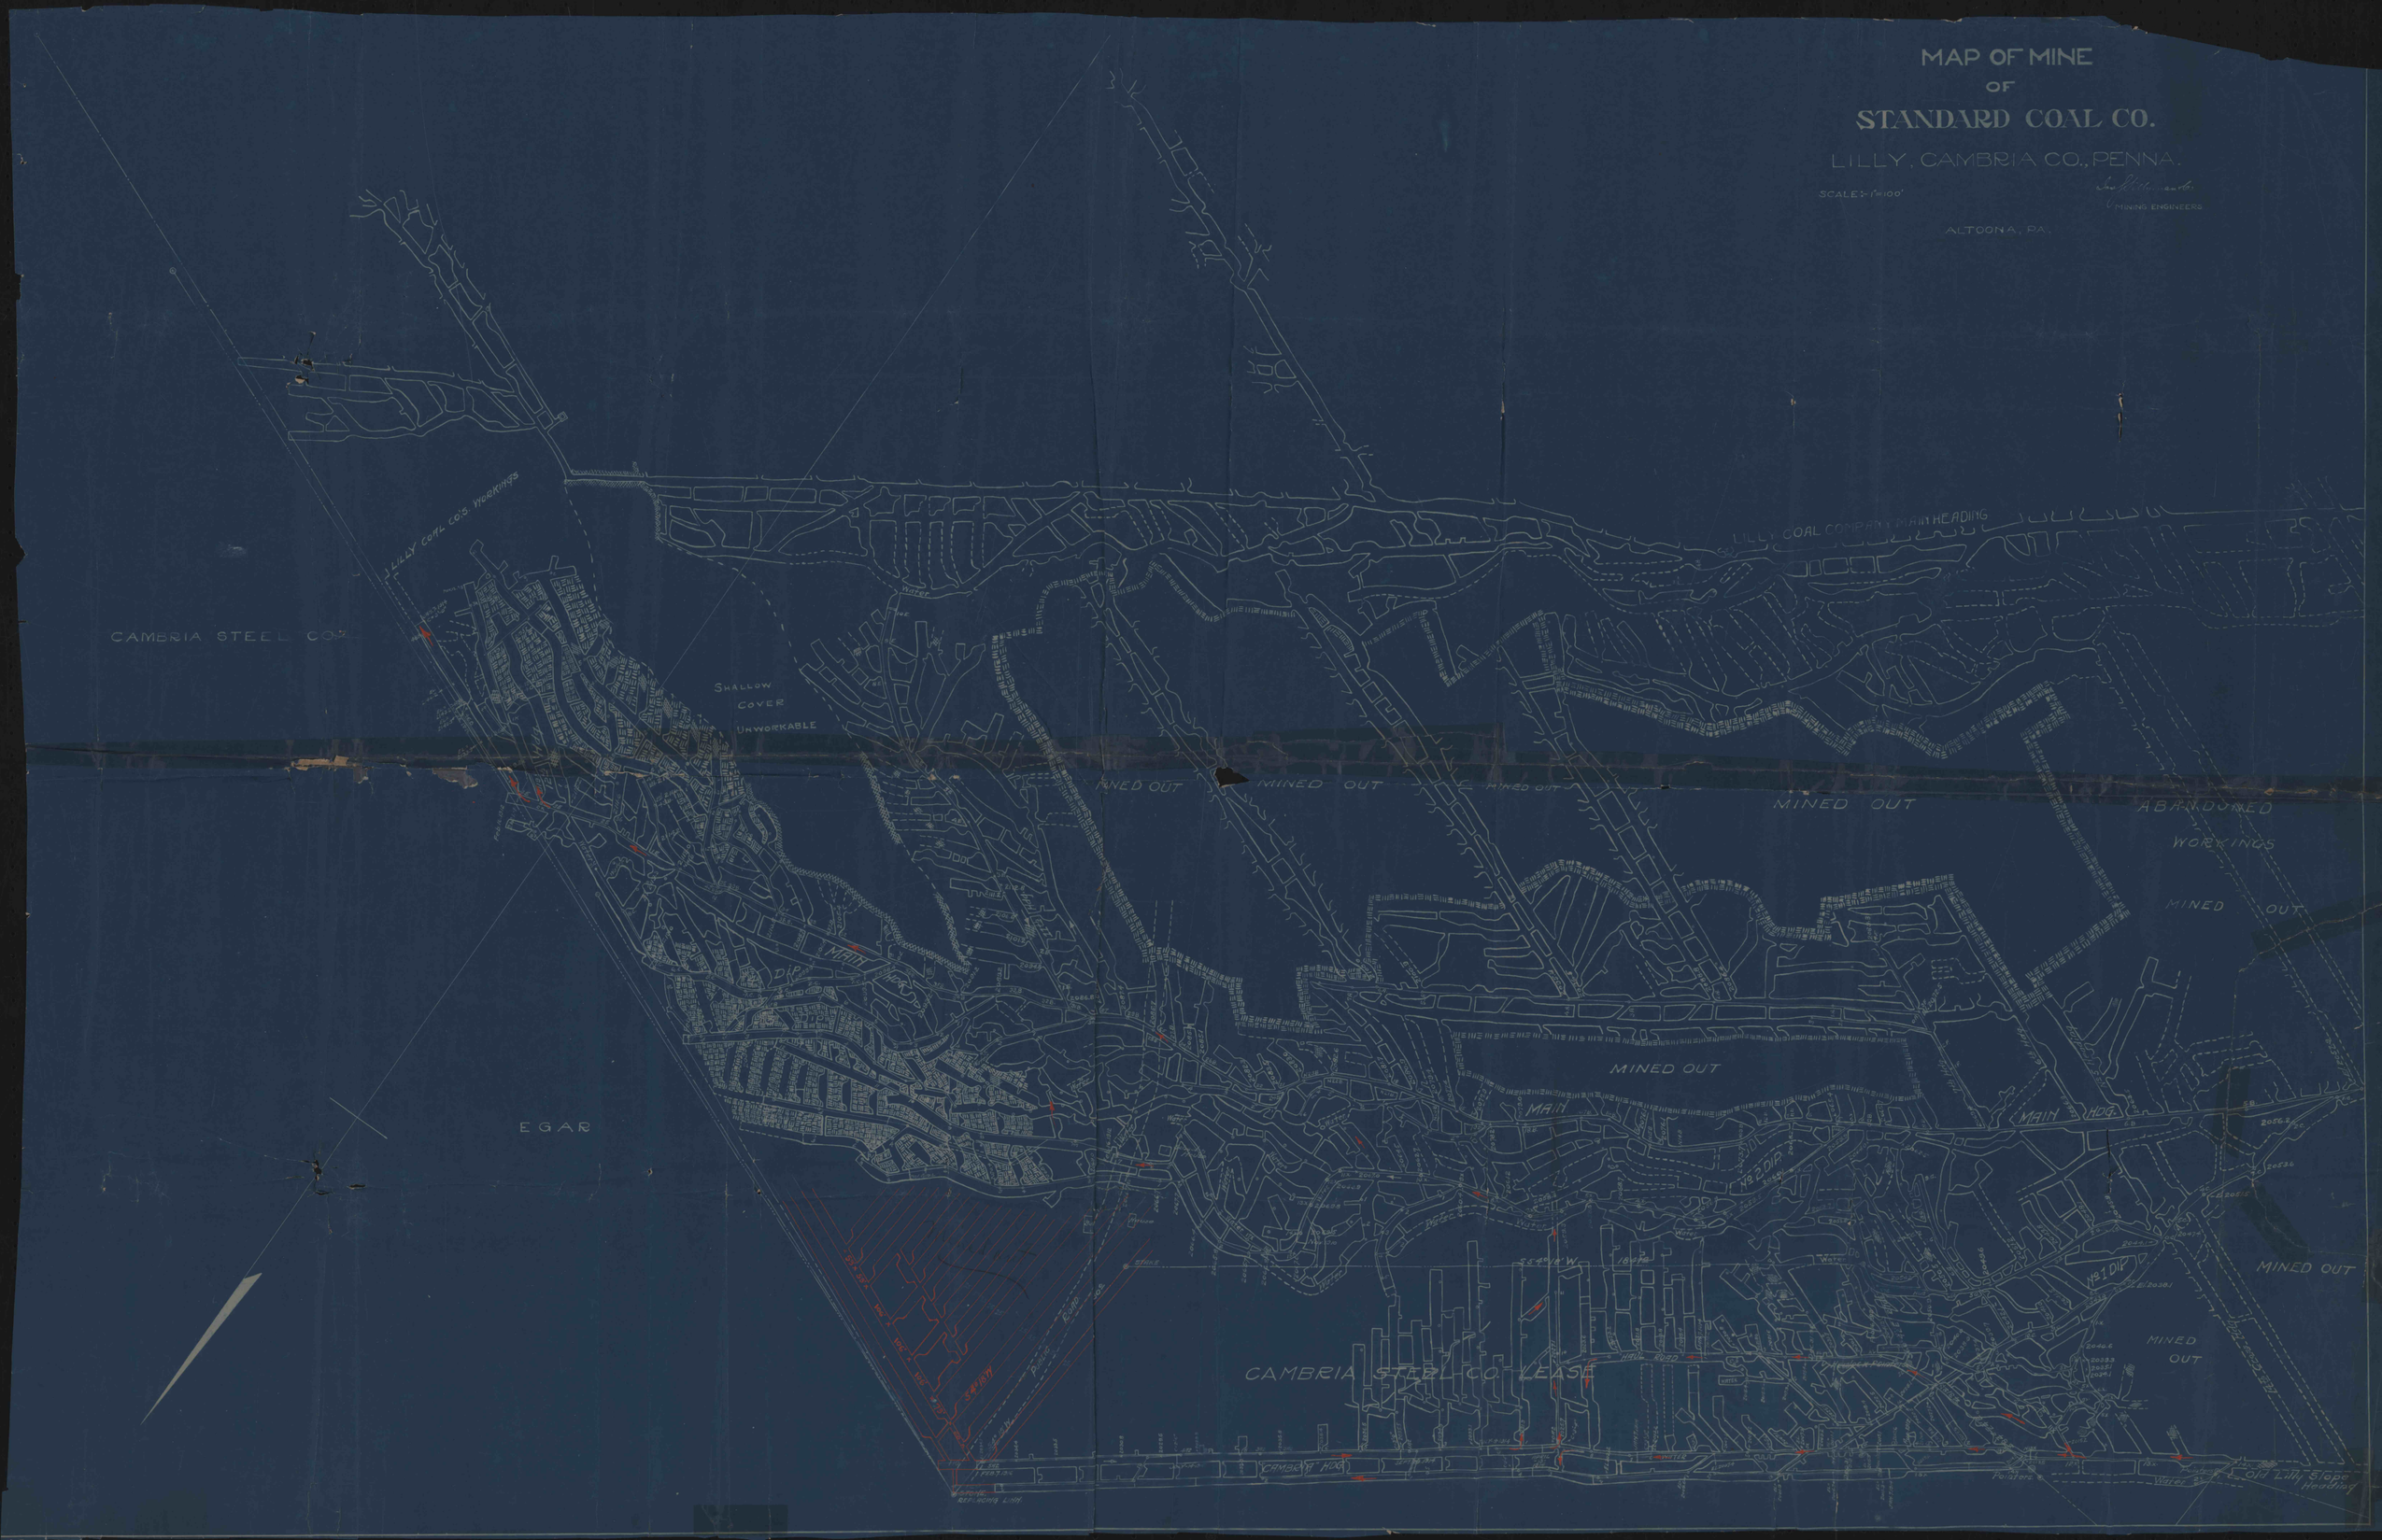
MAP OF MINE
OF
STANDARD COAL CO.
LILLY, CAMBRIA CO., PENNA.
SCALE:- 1"=100'
MINING ENGINEERS
ALTOONA, PA.
LILLY COAL CO'S. WORKINGS
CAMBRIA STEEL CO.
SHALLOW
COVER
UNWORKABLE
LILLY COAL COMPANY MAIN HEADING
MINED OUT
MINED OUT
MINED OUT
MINED OUT
ABANDONED
WORKINGS
MINED OUT
MAIN
MAIN HDG.
EGAR
CAMBRIA STEEL CO. LEASE
CAMBRIA HDG.
Old Lilly Slope Heading