


R O Y L E H E I R S .

A . S C H I E

I D E N T A N

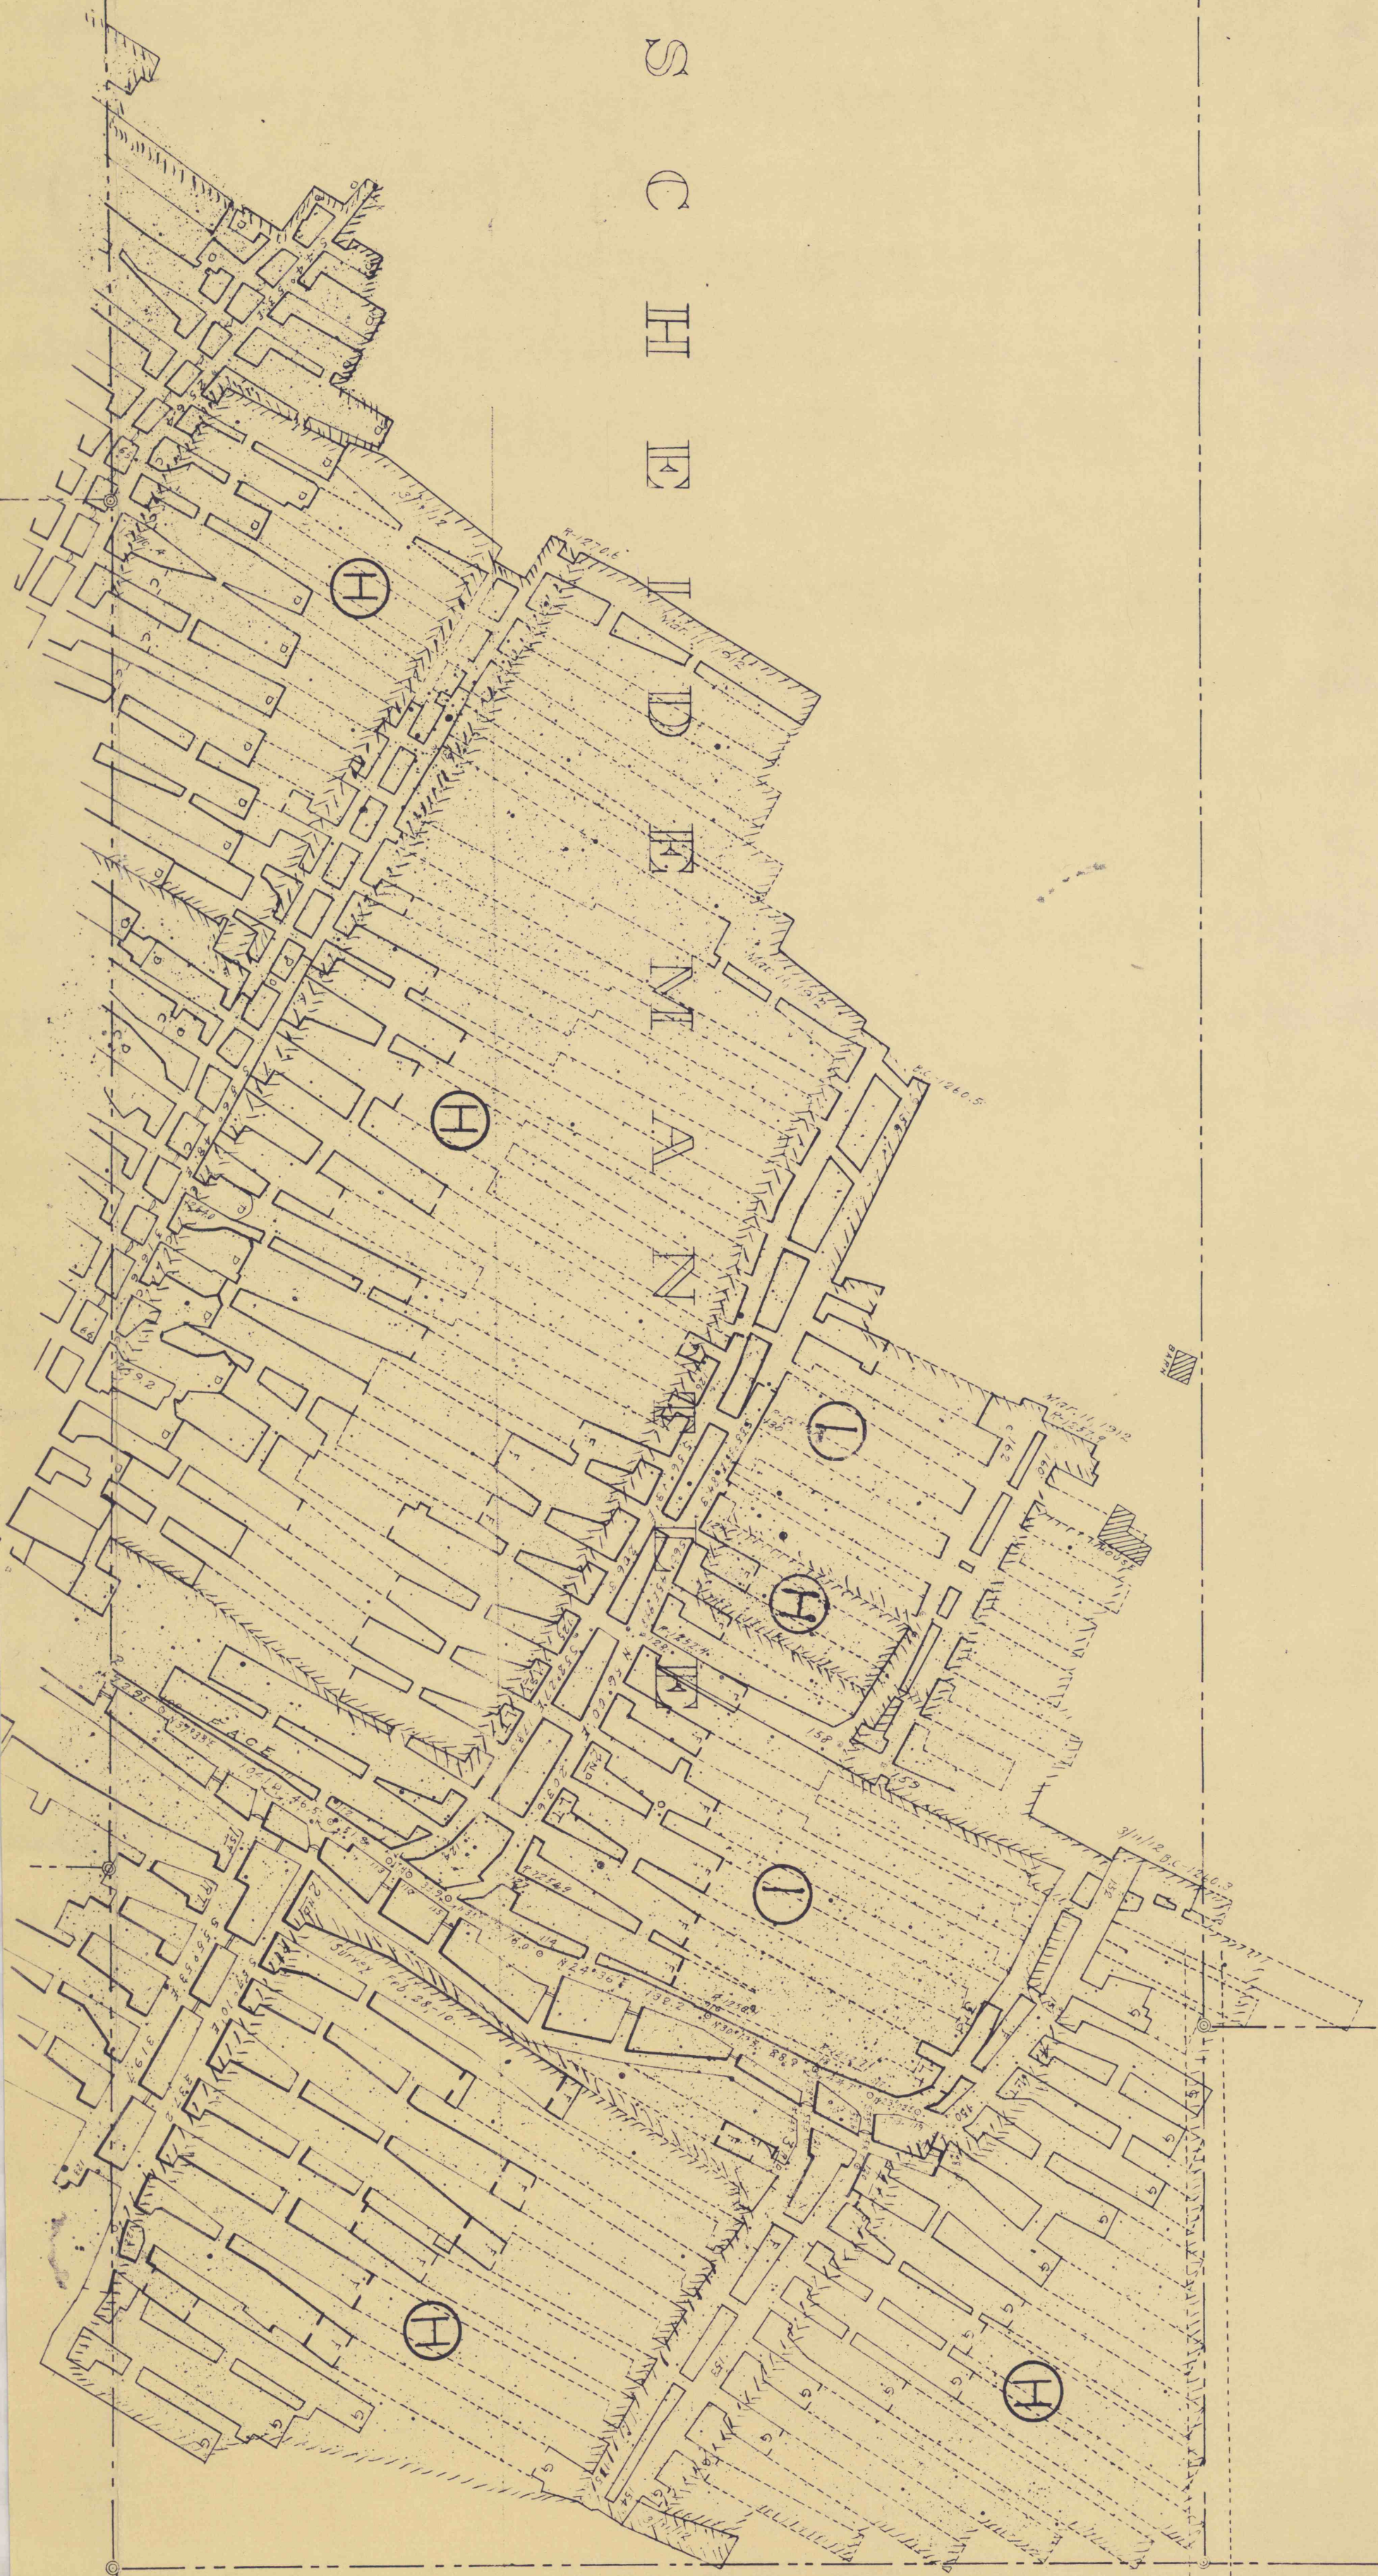

T . S L O A N .

LOCHRIE BROS COAL CO.  
COAL LEASE.

E . V A N D E R L I N .

LOCHRIE BROS COAL CO. COAL LEASE.