

OAK HILL COAL CORP.

CLYMER - PENNA 15728

STARFORD No. 1 - DEEP MINE

BLACKLICK AND CAMBRIA TOWNSHIPS

CAMBRIA COUNTY

SCALE- 1"=100'

SURVEY DATE \_\_\_\_\_

CONTEMPLATED MINING \_\_\_\_\_ TO \_\_\_\_\_

SIX MONTH EXTRACTION \_\_\_\_\_ TO \_\_\_\_\_

REVISED ADDITIONS \_\_\_\_\_ TO \_\_\_\_\_

JOHN C. PASSMORE SURVEYOR

DRAWING BY - A. C.

Signed *John C. Passmore*

SEAL

SURF EDWARDS LEROY

364.55 AC.  
COAL - EASTERN GAS & RUEL ASSOCIATES

INACTIVE - 10-31-1973



HIGH WALL BARRIER 300'

CAMBRIA TWP  
BLACKLICK TWP

HIGH WALL BARRIER 300'

MINING BARRIER 200'

HIGH - WALL

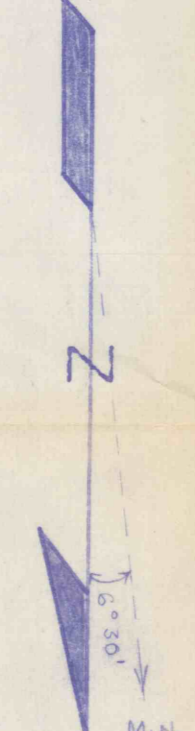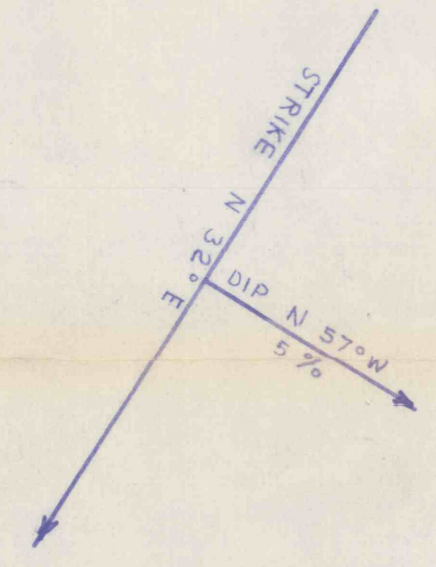

NOTE: 465 TURN FROM ST. No 5

