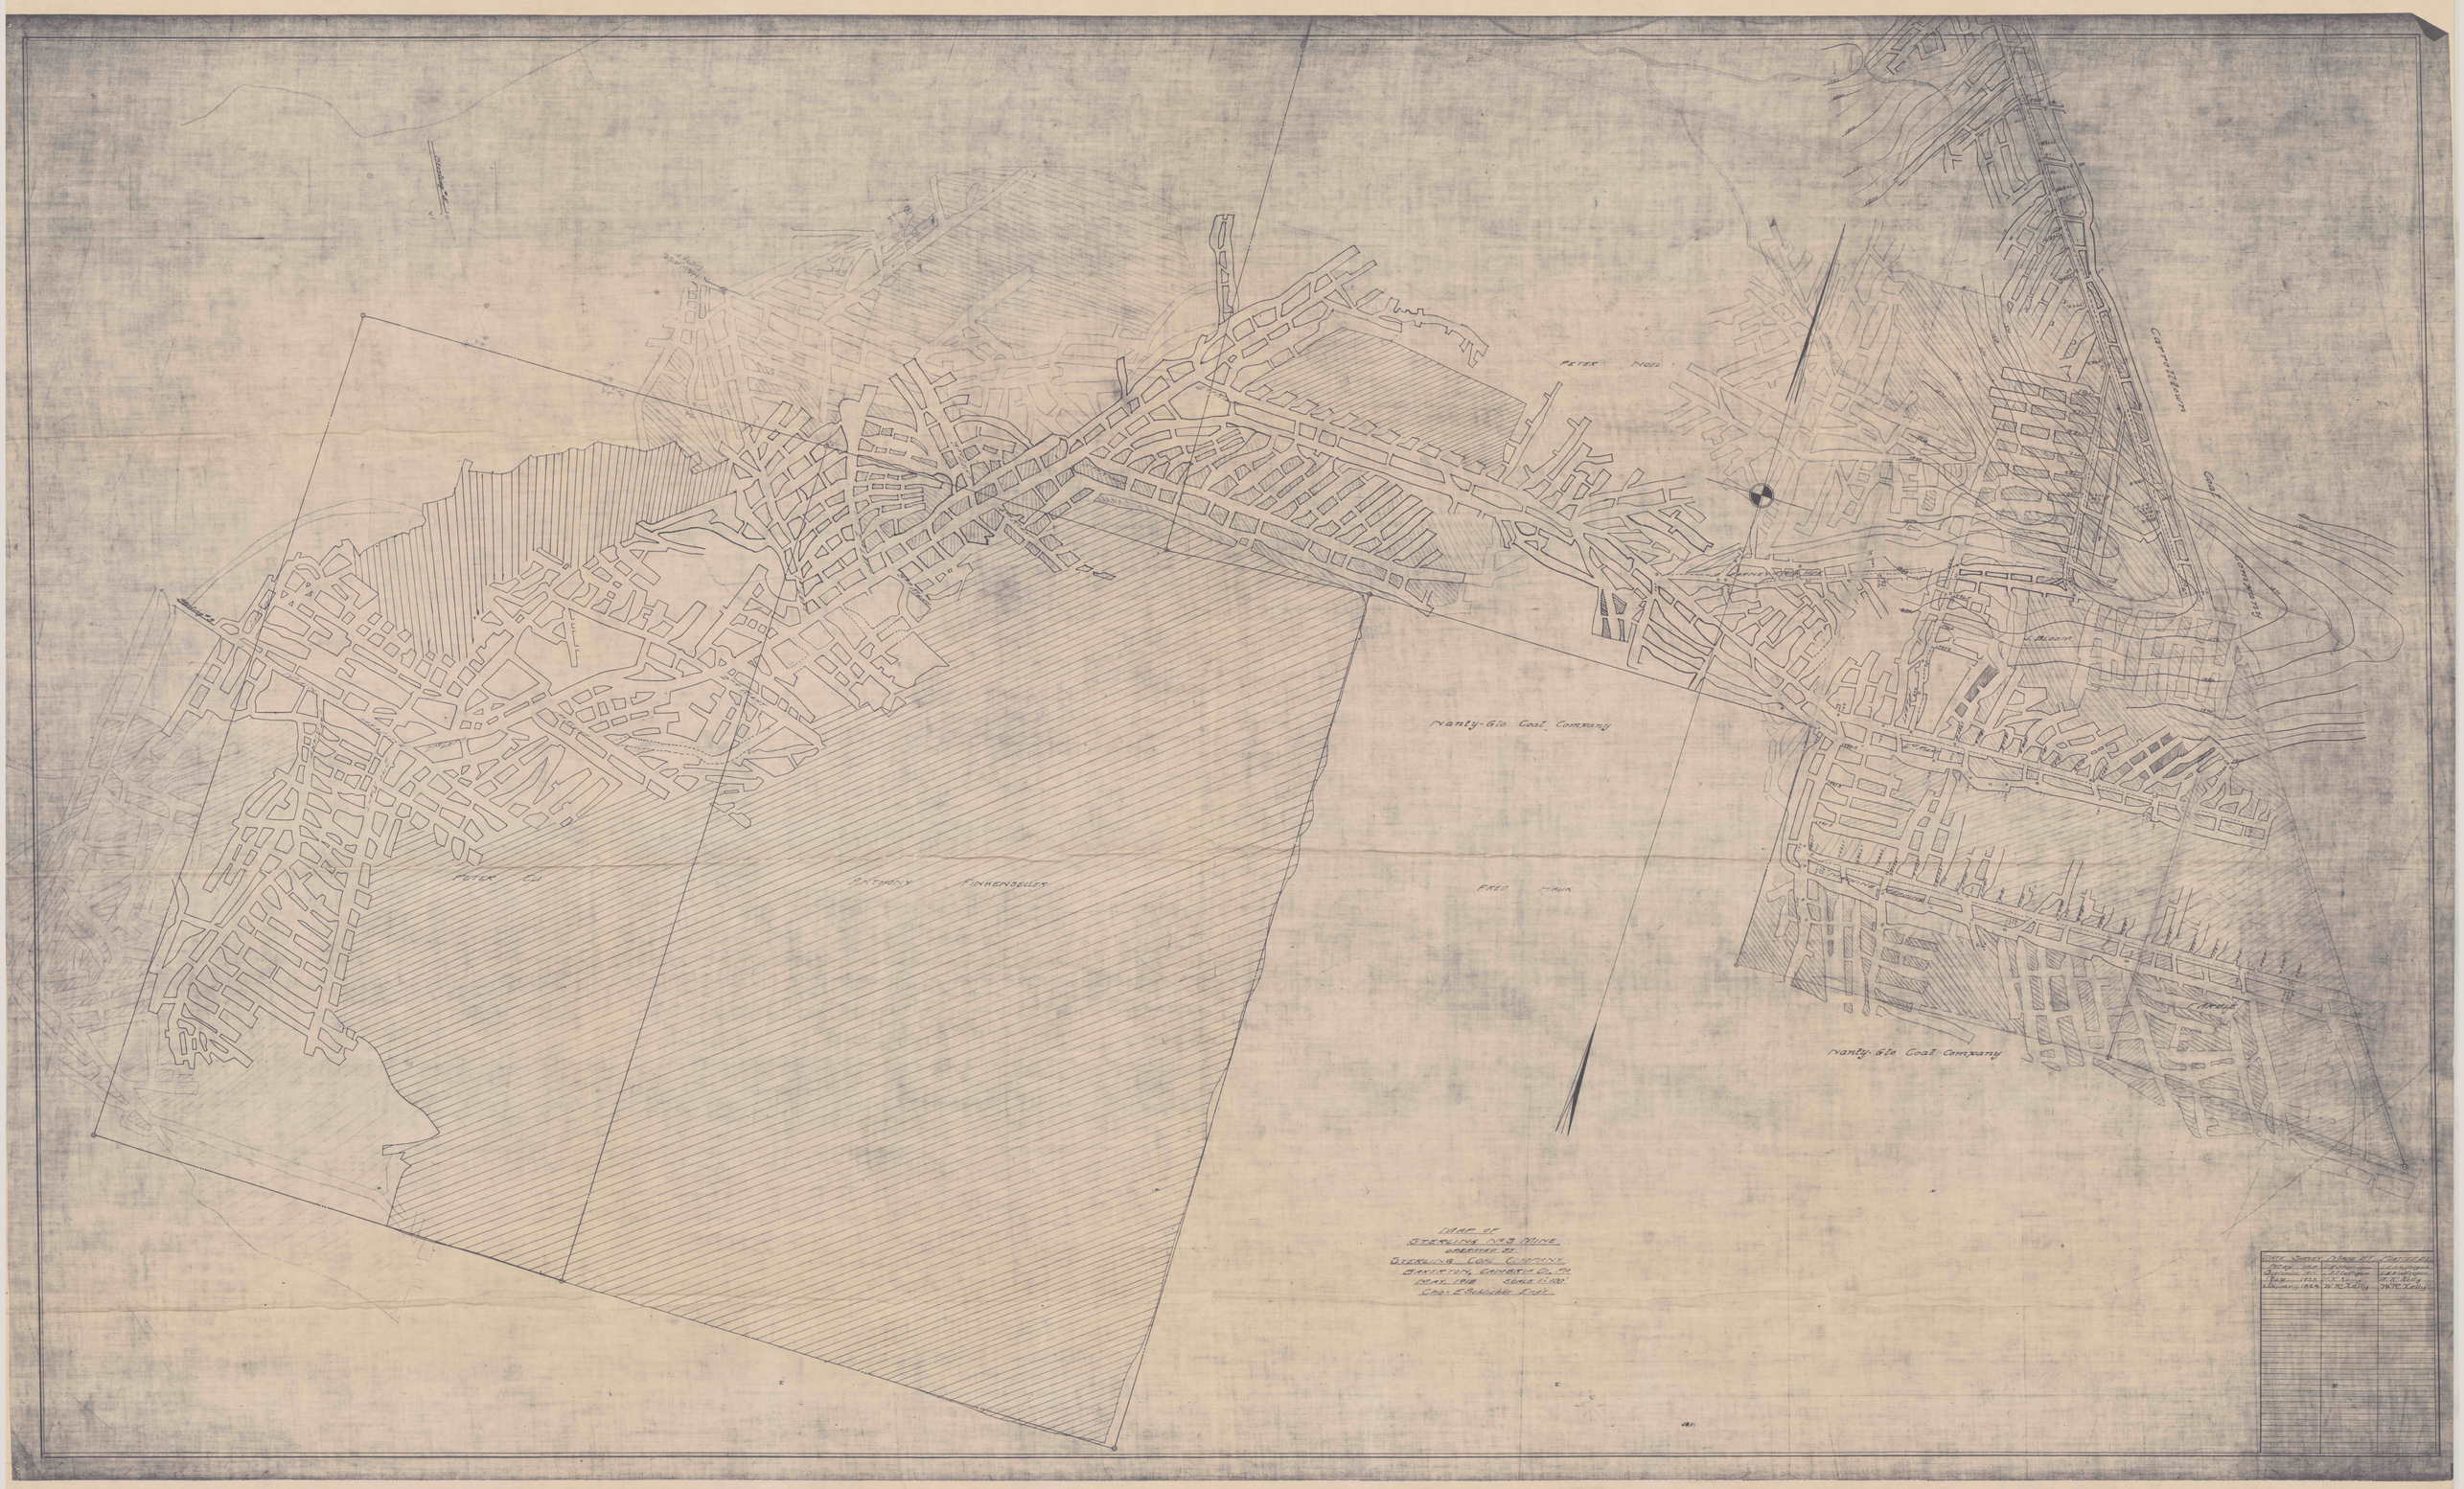
PETER NOEL
Carrottown Coal Company
J. Bloom
Nanty-Glo Coal Company
PETER ELI
ANTHONY FINKENSELLER
FRED HAUK
Nanty-Glo Coal Company
MAP OF
STERLING No 3 MINE
OPERATED BY
STERLING COAL COMPANY
BAKERTON, CAMBRIA Co. Pa
MAY, 1918 SCALE 1" = 100'
Chas. E. Schlicher Eng'r
DATE SURVEY MADE BY PLOTTED BY
Aug. 1918 L.E. Stoppiger L.E. Stoppiger
Oct. 1918 L.E. Stoppiger L.E. Stoppiger
May 1923 W.R. Kelly W.R. Kelly
January 1924 W.R. Kelly W.R. Kelly