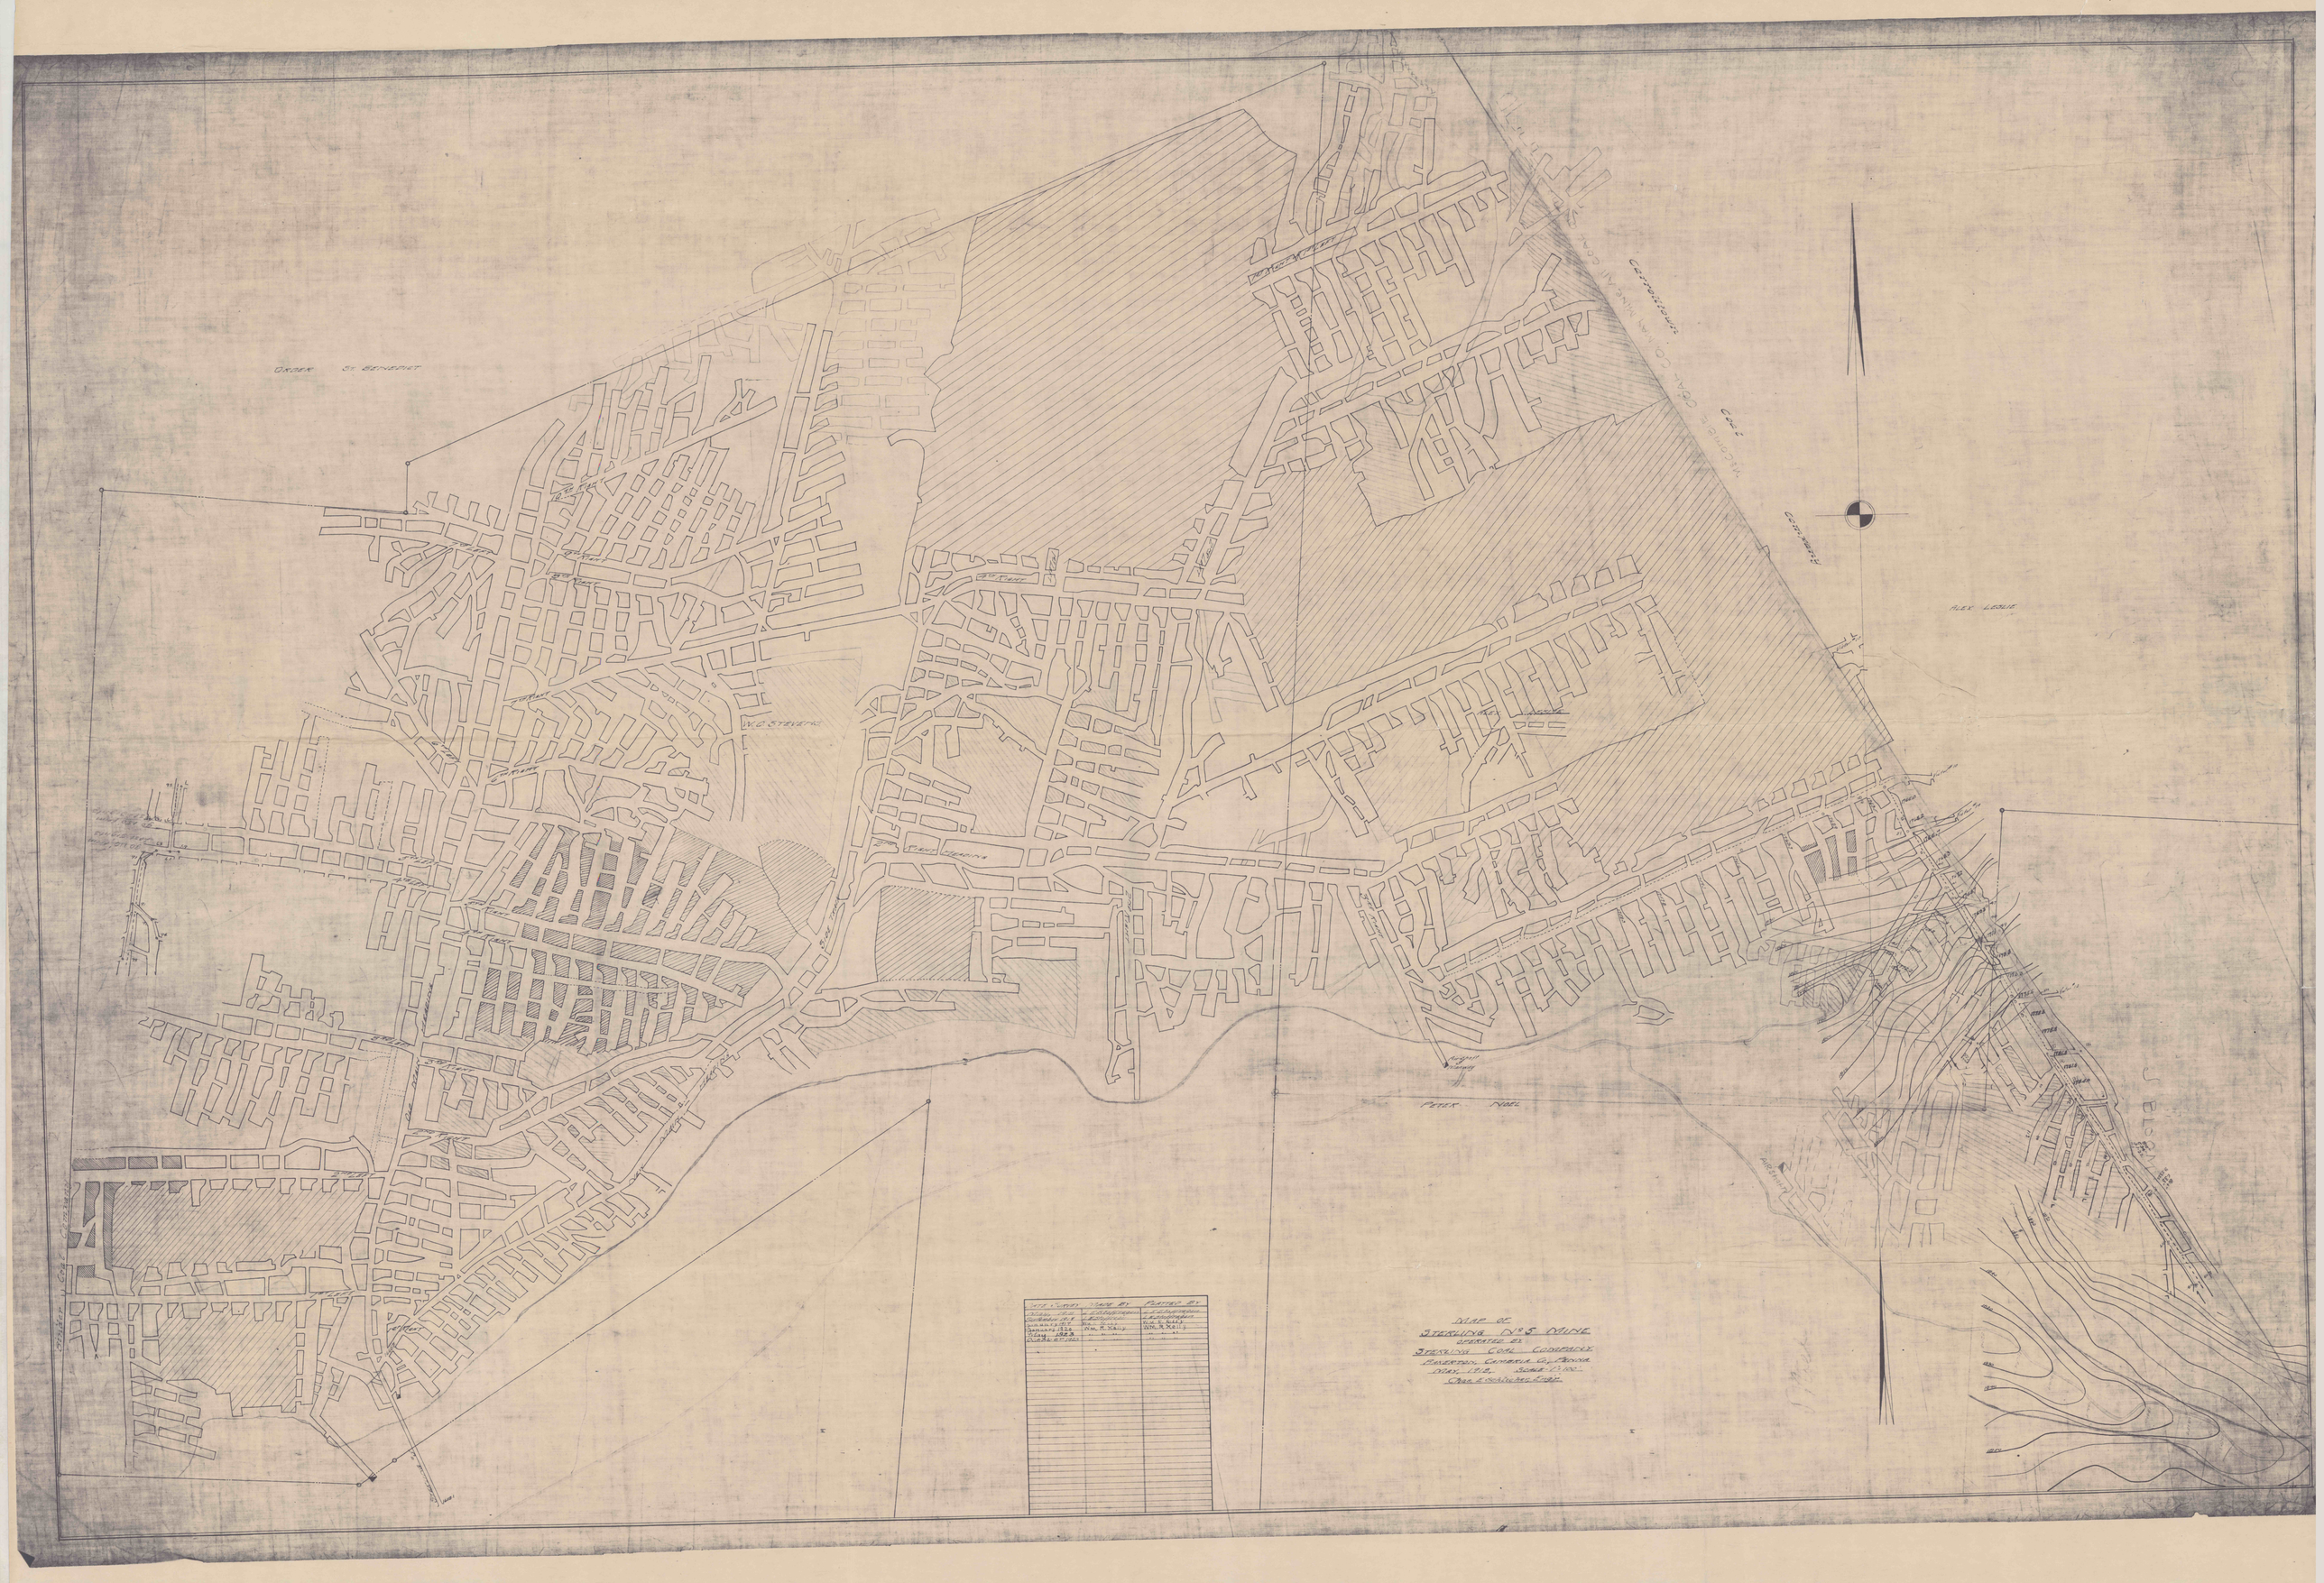

DATE SURVEY	MADE BY	PLOTTED BY
[illegible]	[illegible]	[illegible]
[illegible]	[illegible]	[illegible]
[illegible]	[illegible]	[illegible]
[illegible]	Wm. R. Kelly	Wm. R. Kelly
[illegible]	[illegible]	[illegible]
[illegible]	[illegible]	[illegible]