



W. F. HICE EST.

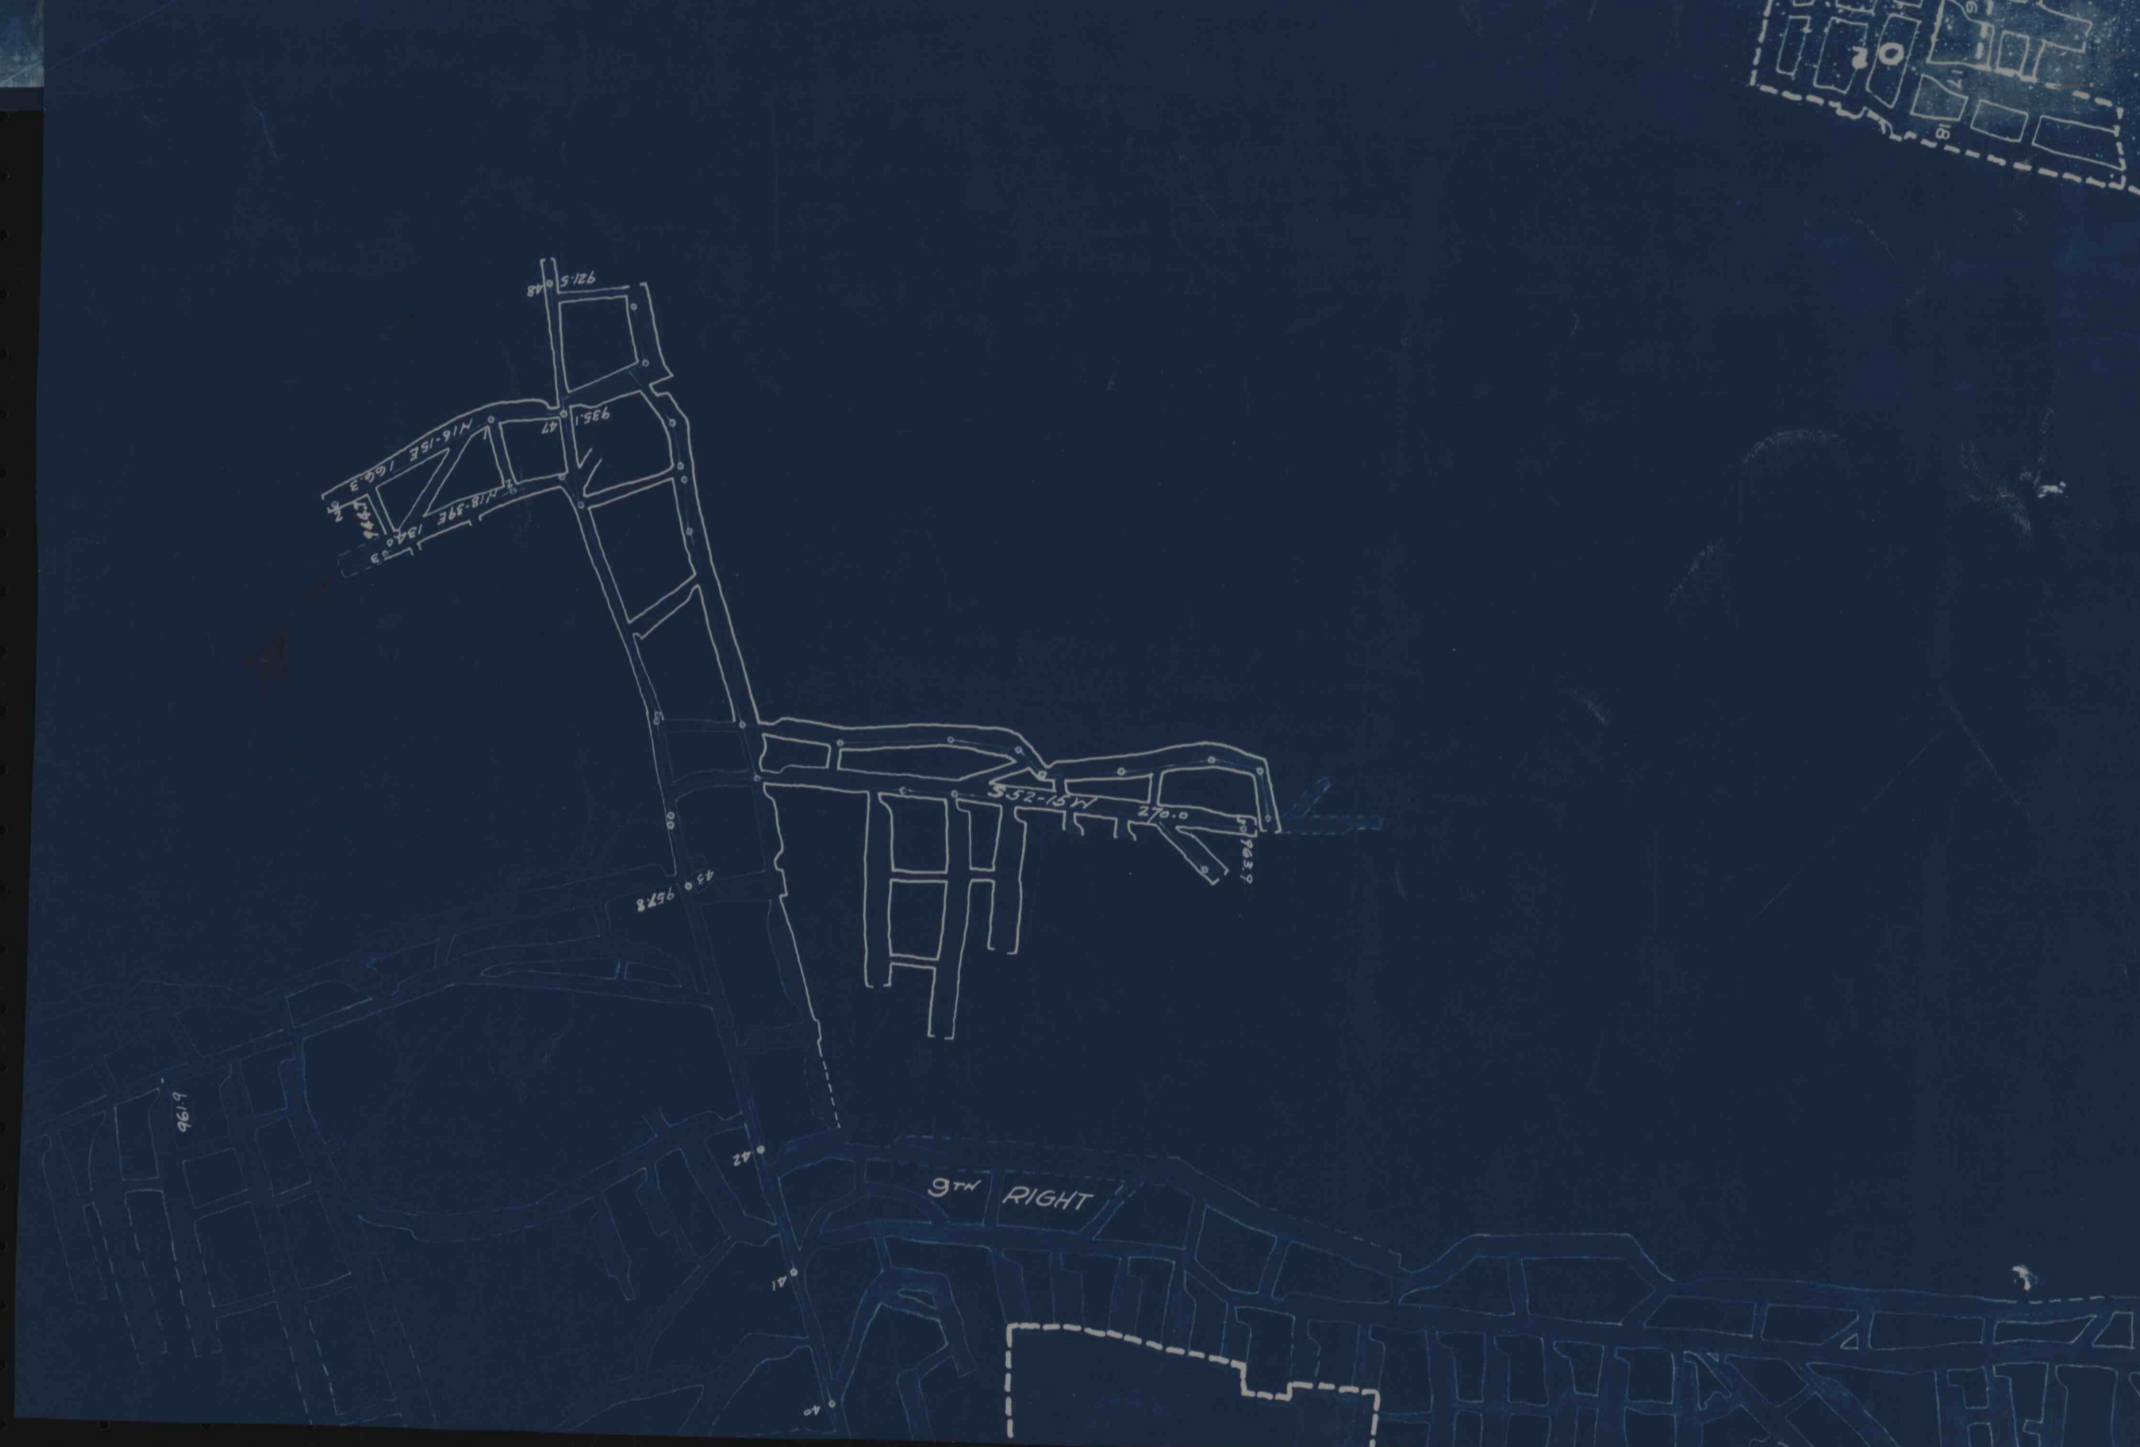

W. F. HICE EST.

