







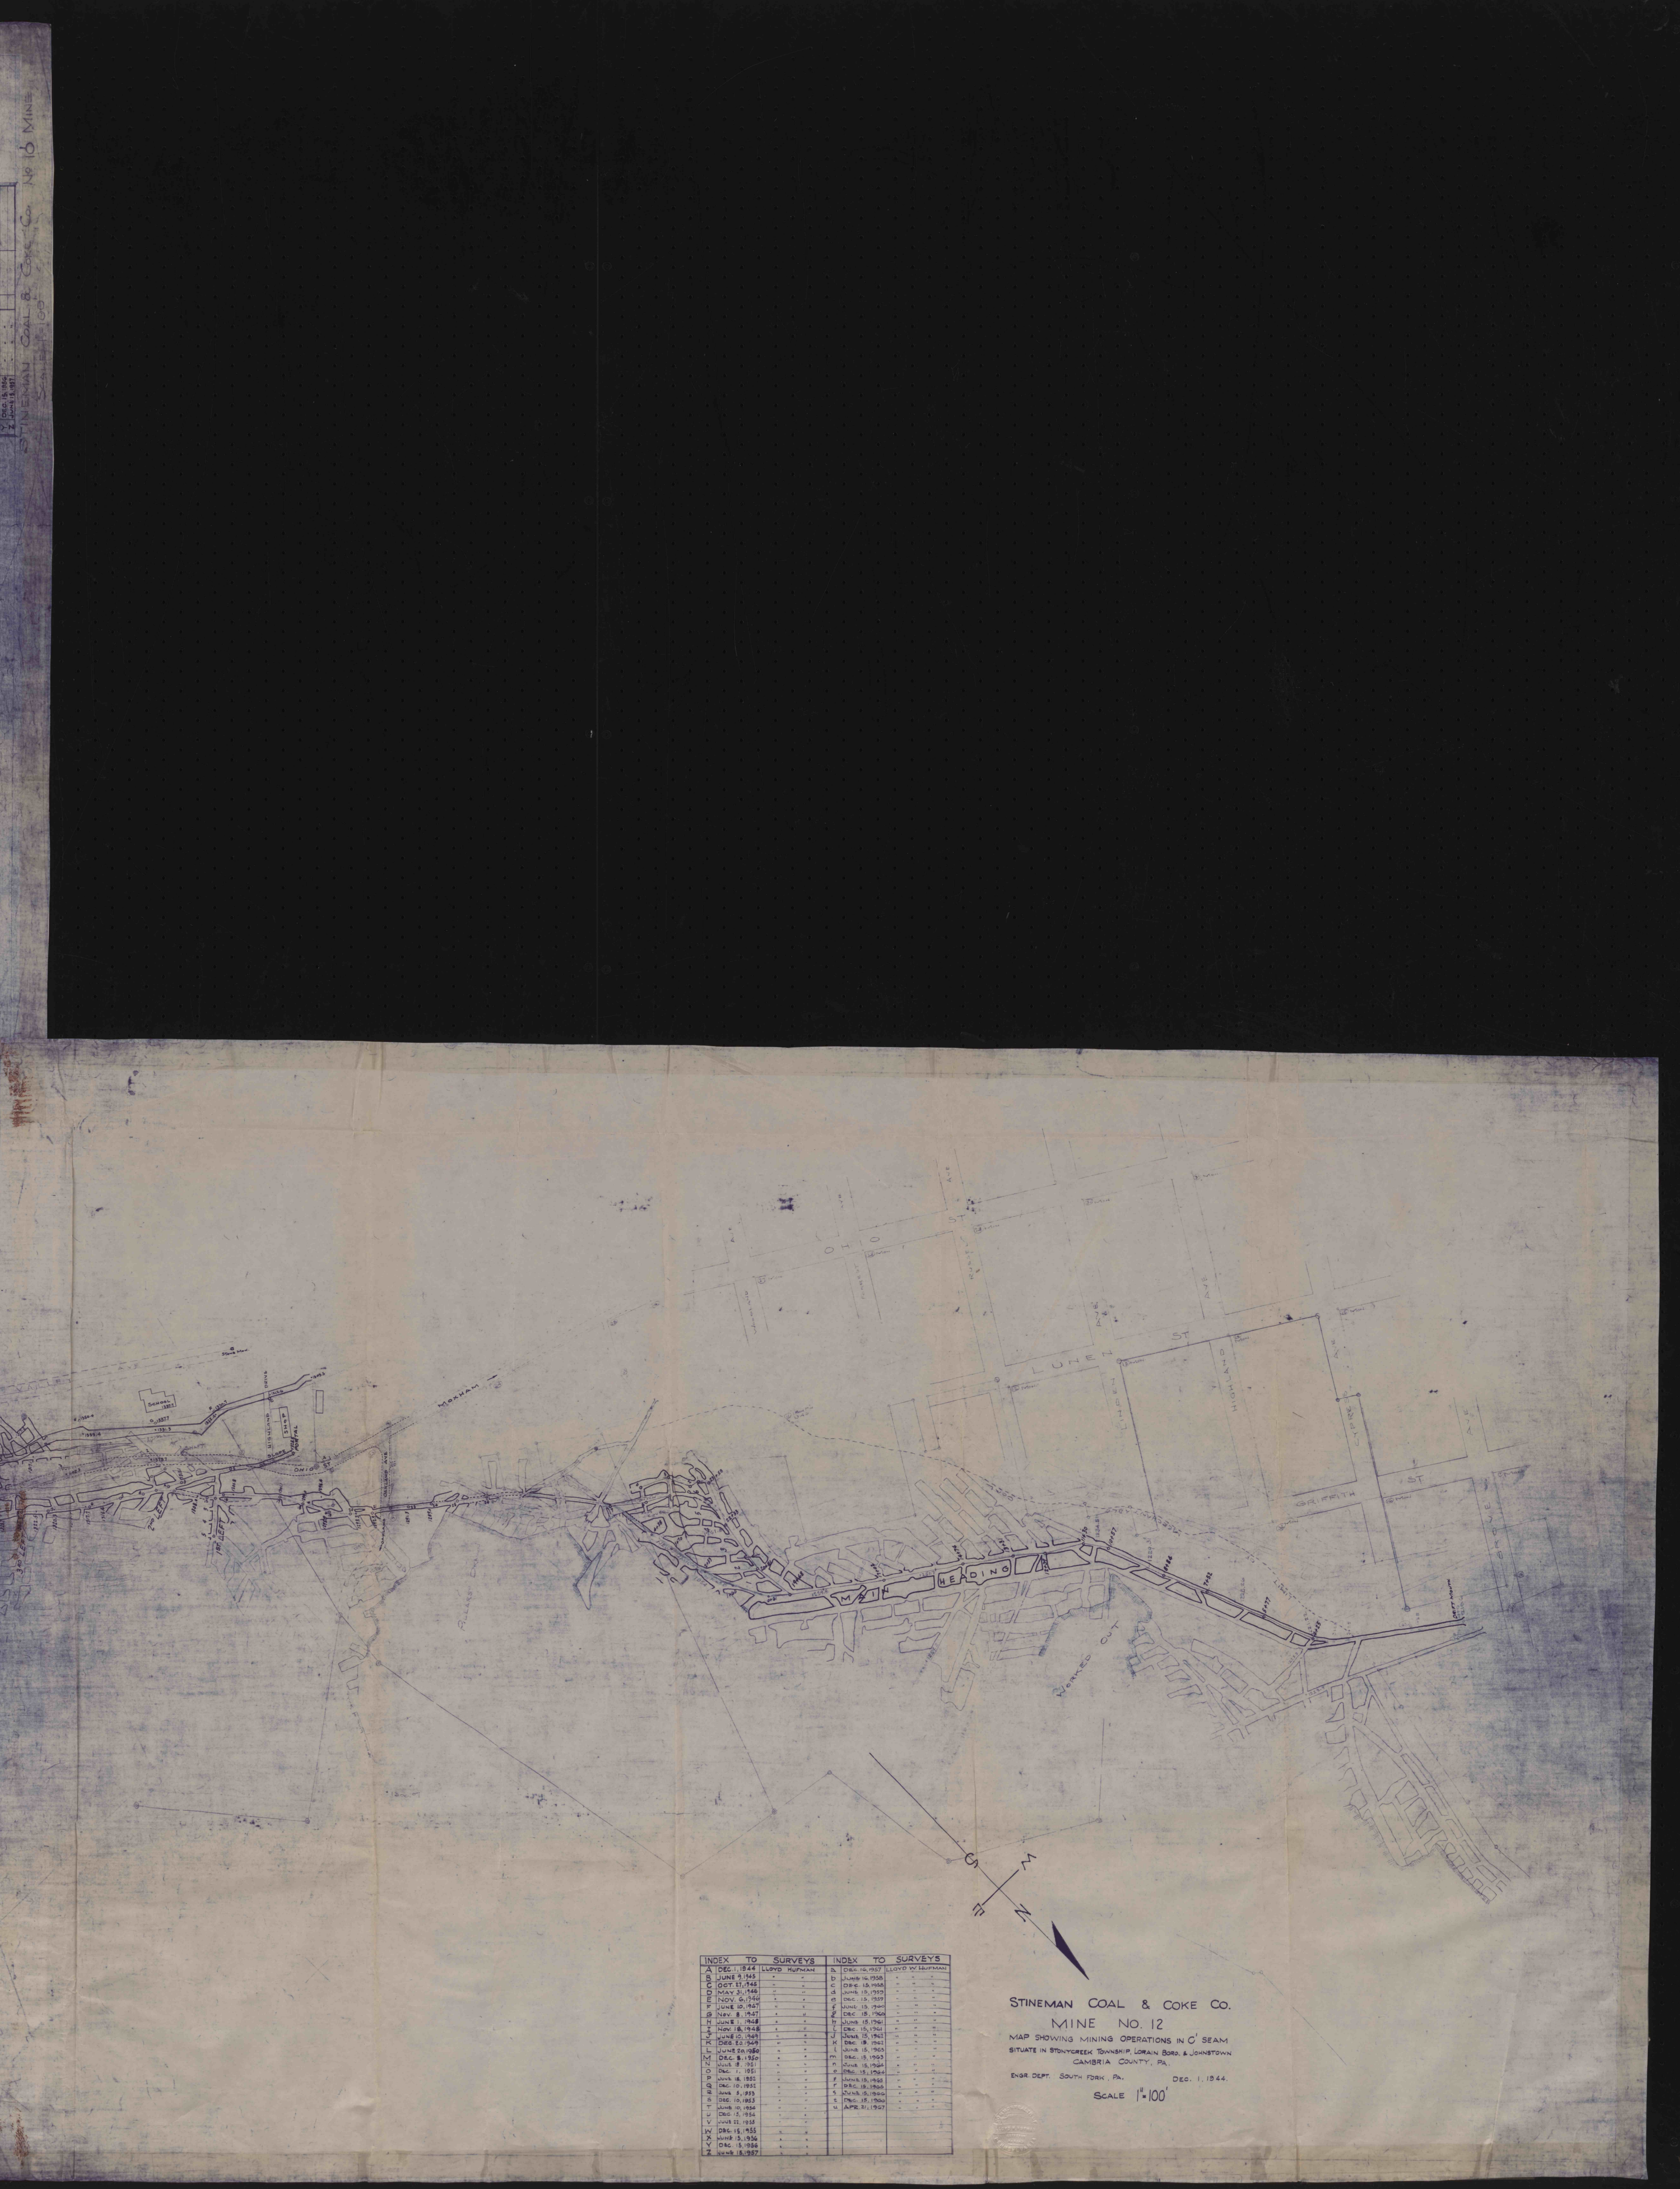


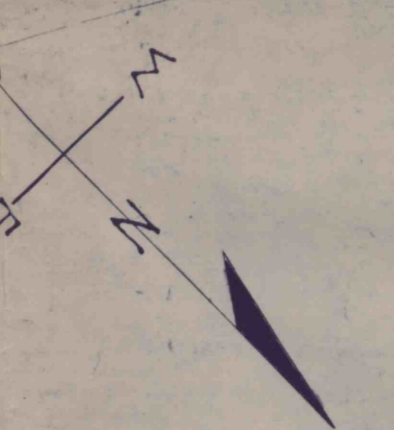

STINEMAN COAL & COKE CO.
 MINE NO. 12
 MAP SHOWING MINING OPERATIONS IN C' BEAM
 SITUATE IN BRIDGECREEK DIVISION OF LORAIN CO. & CAMBRIA
 CAMBRIA COUNTY, PA.
 ENGR. DEPT. SOUTH FORK, PA. DEC. 1, 1924.
 SCALE 1"=100'