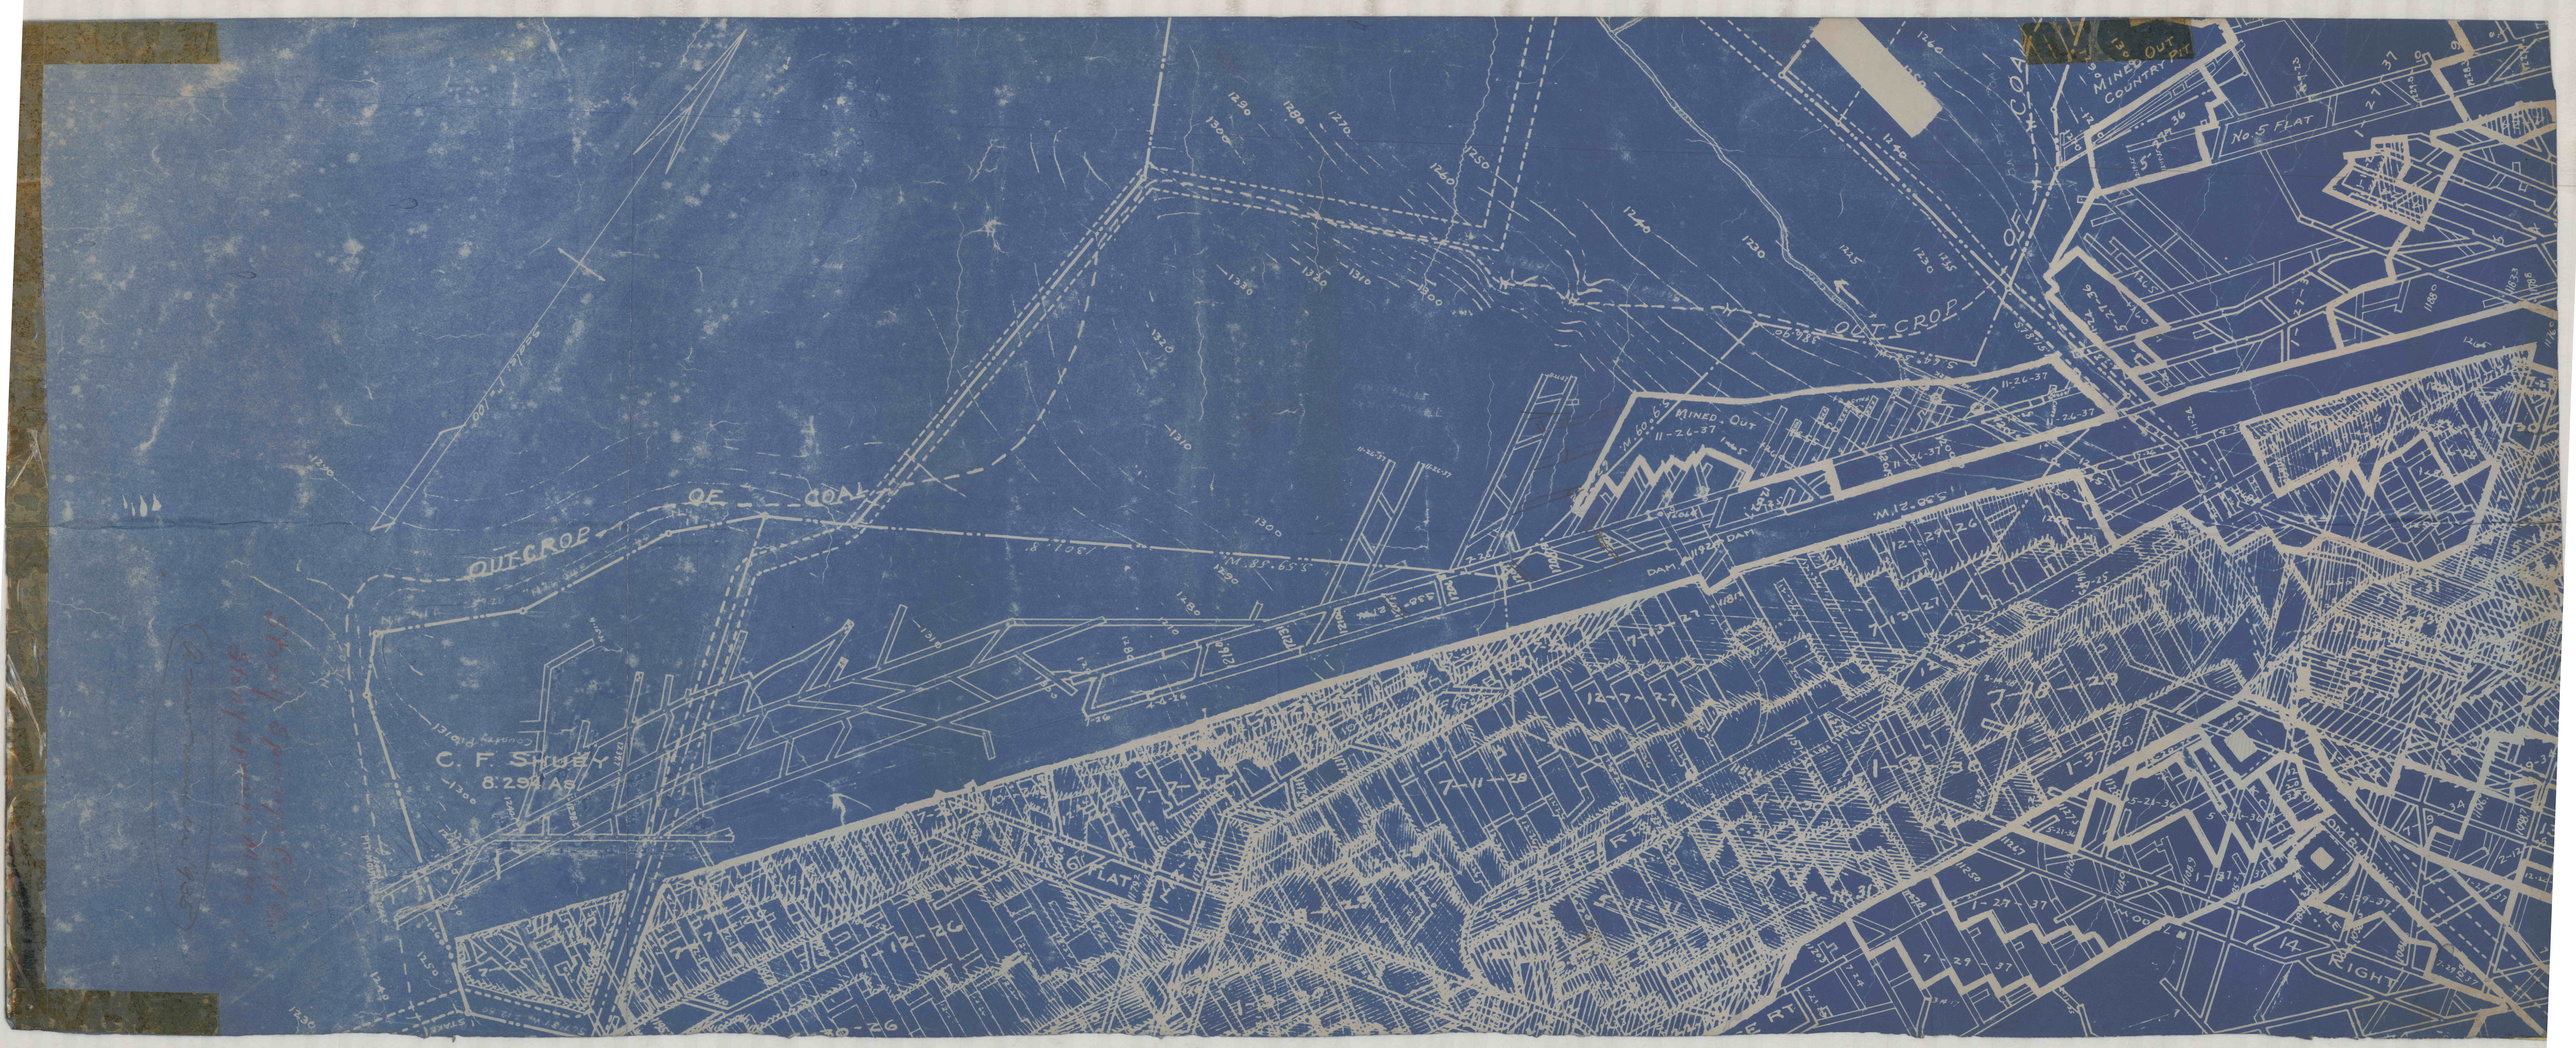
OUT CROP OF COAL
OUT CROP OF COAL
MINED OUT
11-24-37
MINED OUT
COUNTRY PIT
No. 5 FLAT
C. F. STUEY
8.29 Ac
DAM
DAM
M.85.65'
M.12.85'
M.60.6'
No. 6 FLAT
No. 7 FLAT
No. 14 RIGHT
12-7-27
7-11-28
11-24-37
11-26-37
12-29-26
1-3-30
1-27-37
5-21-36
4-4-36
2-2-36
7-13-27
7-1-28
