


N 5000

N 9000

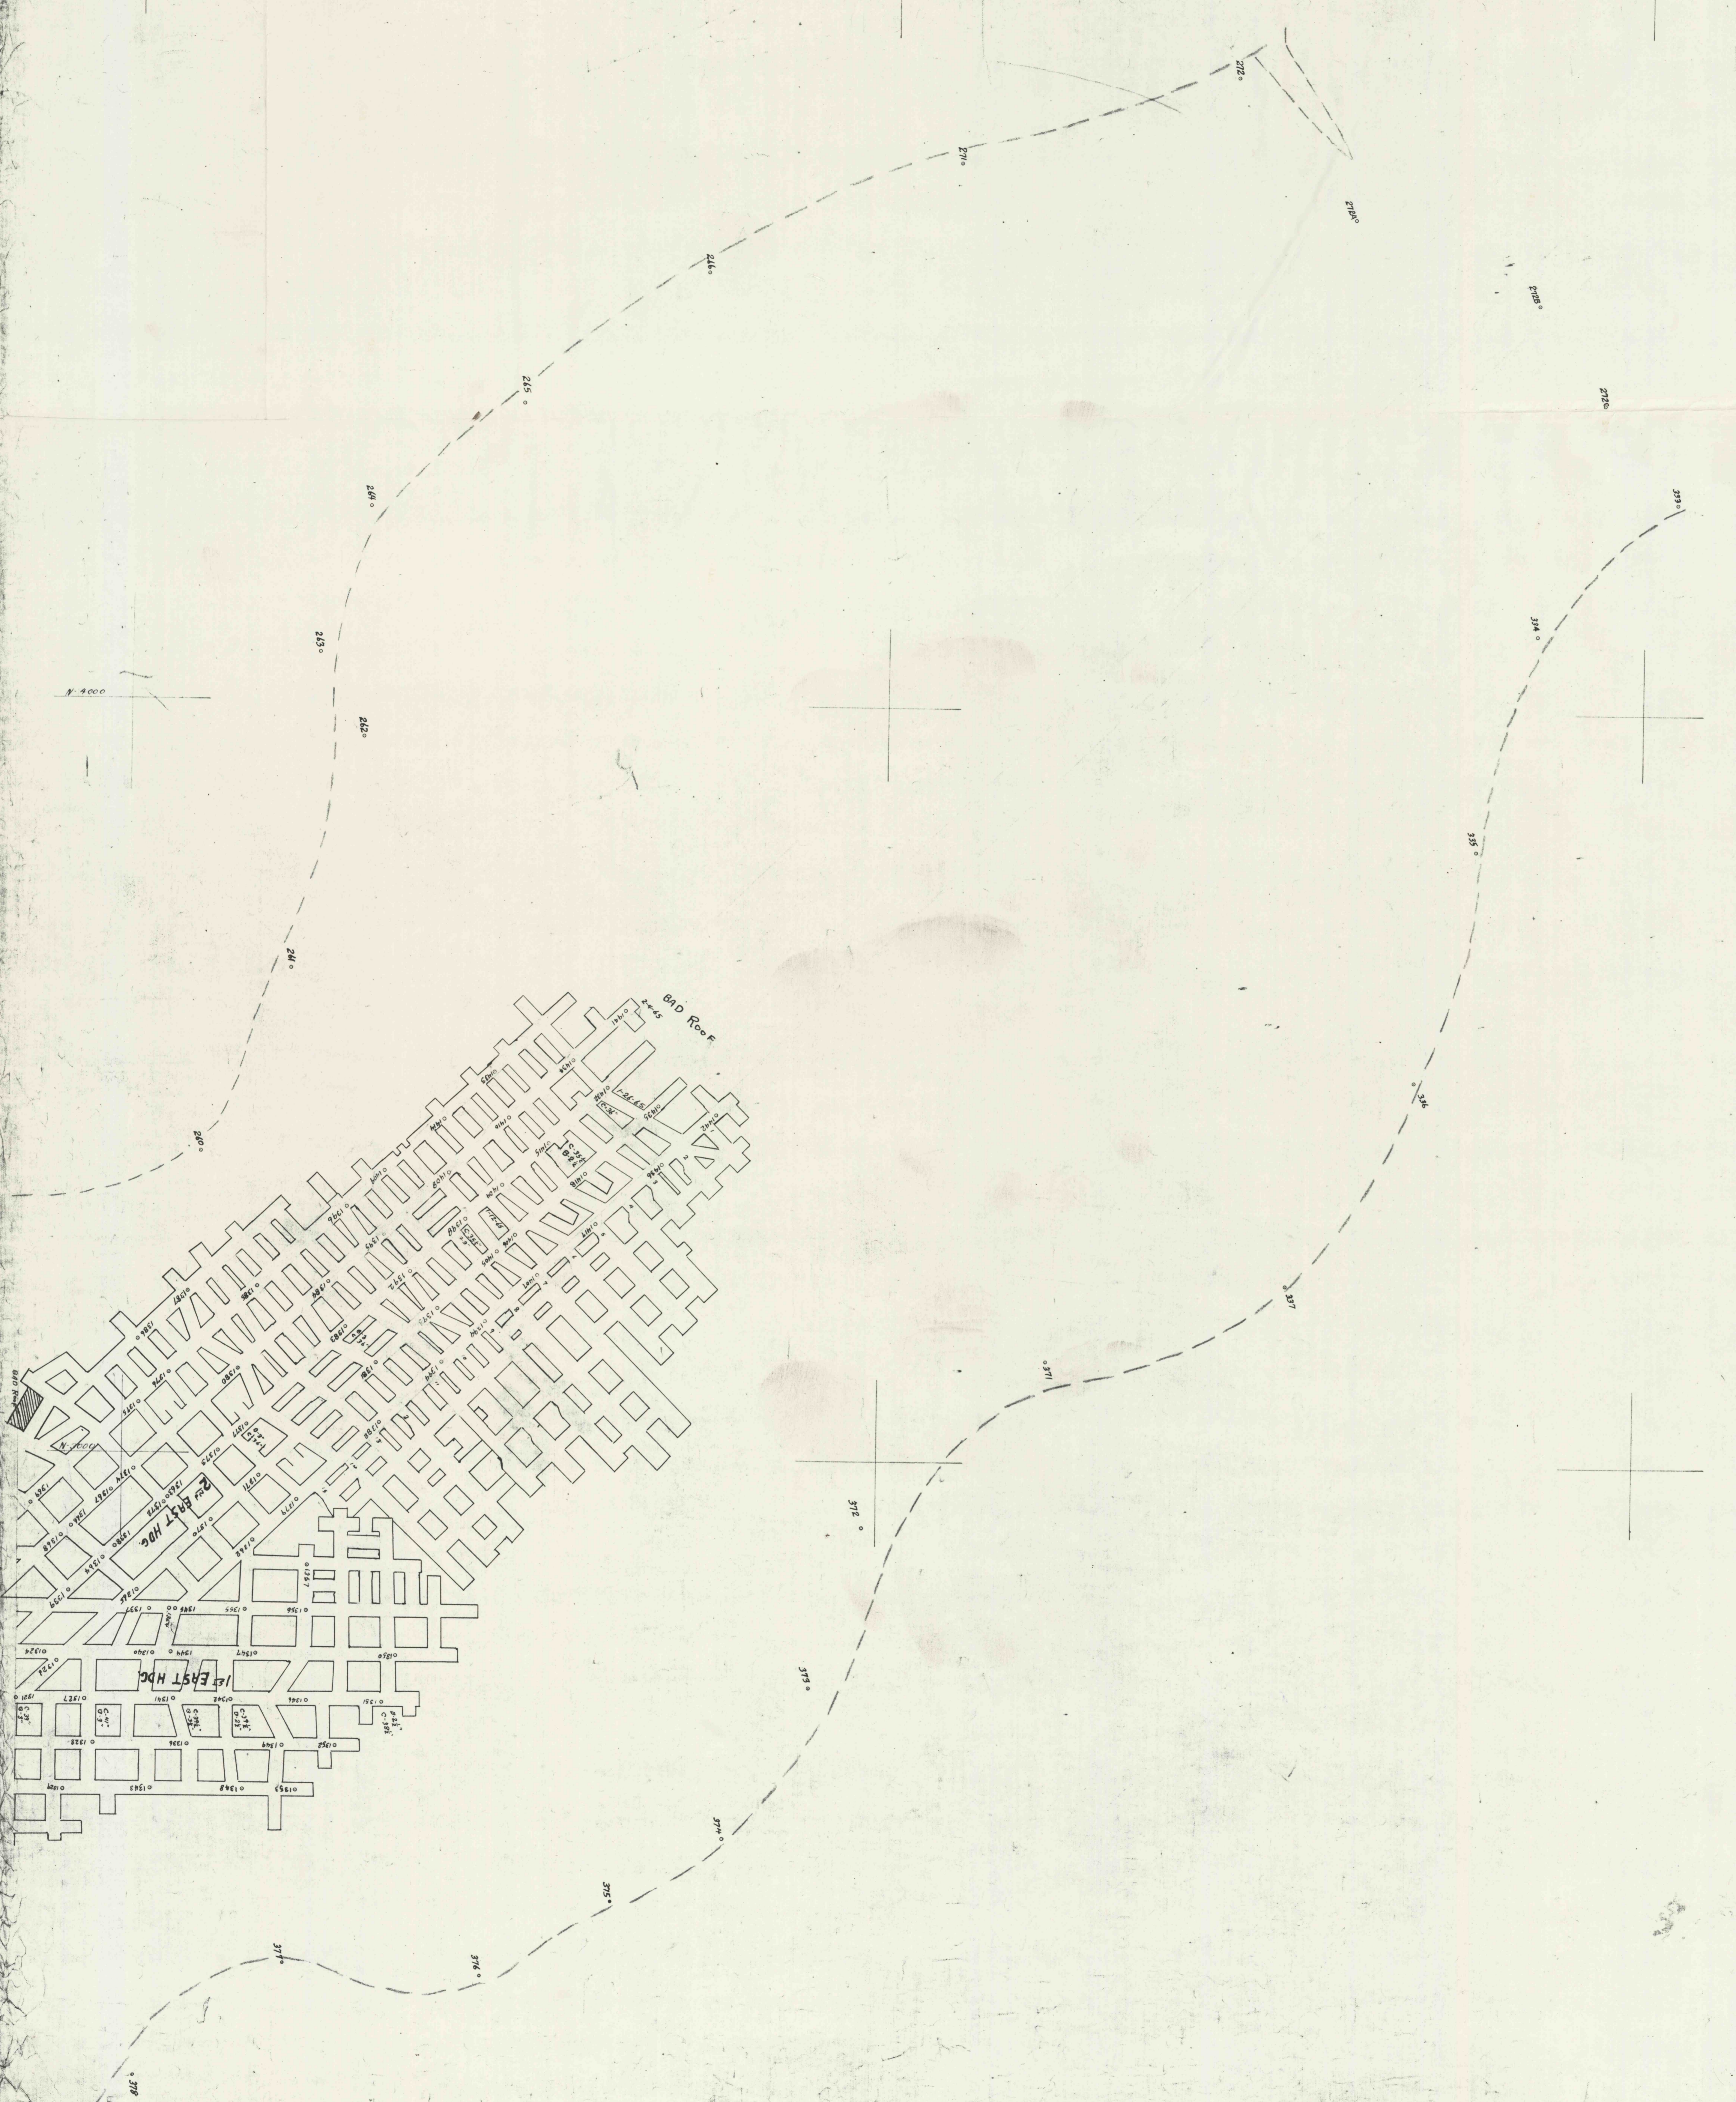

MAP 4

