


LADY JANE COLLIERIES, INC.
STOTT NO. 1 MINE B SEAM
PENFIELD, CLFD. CO. PA.
SCALE 1" = 100'

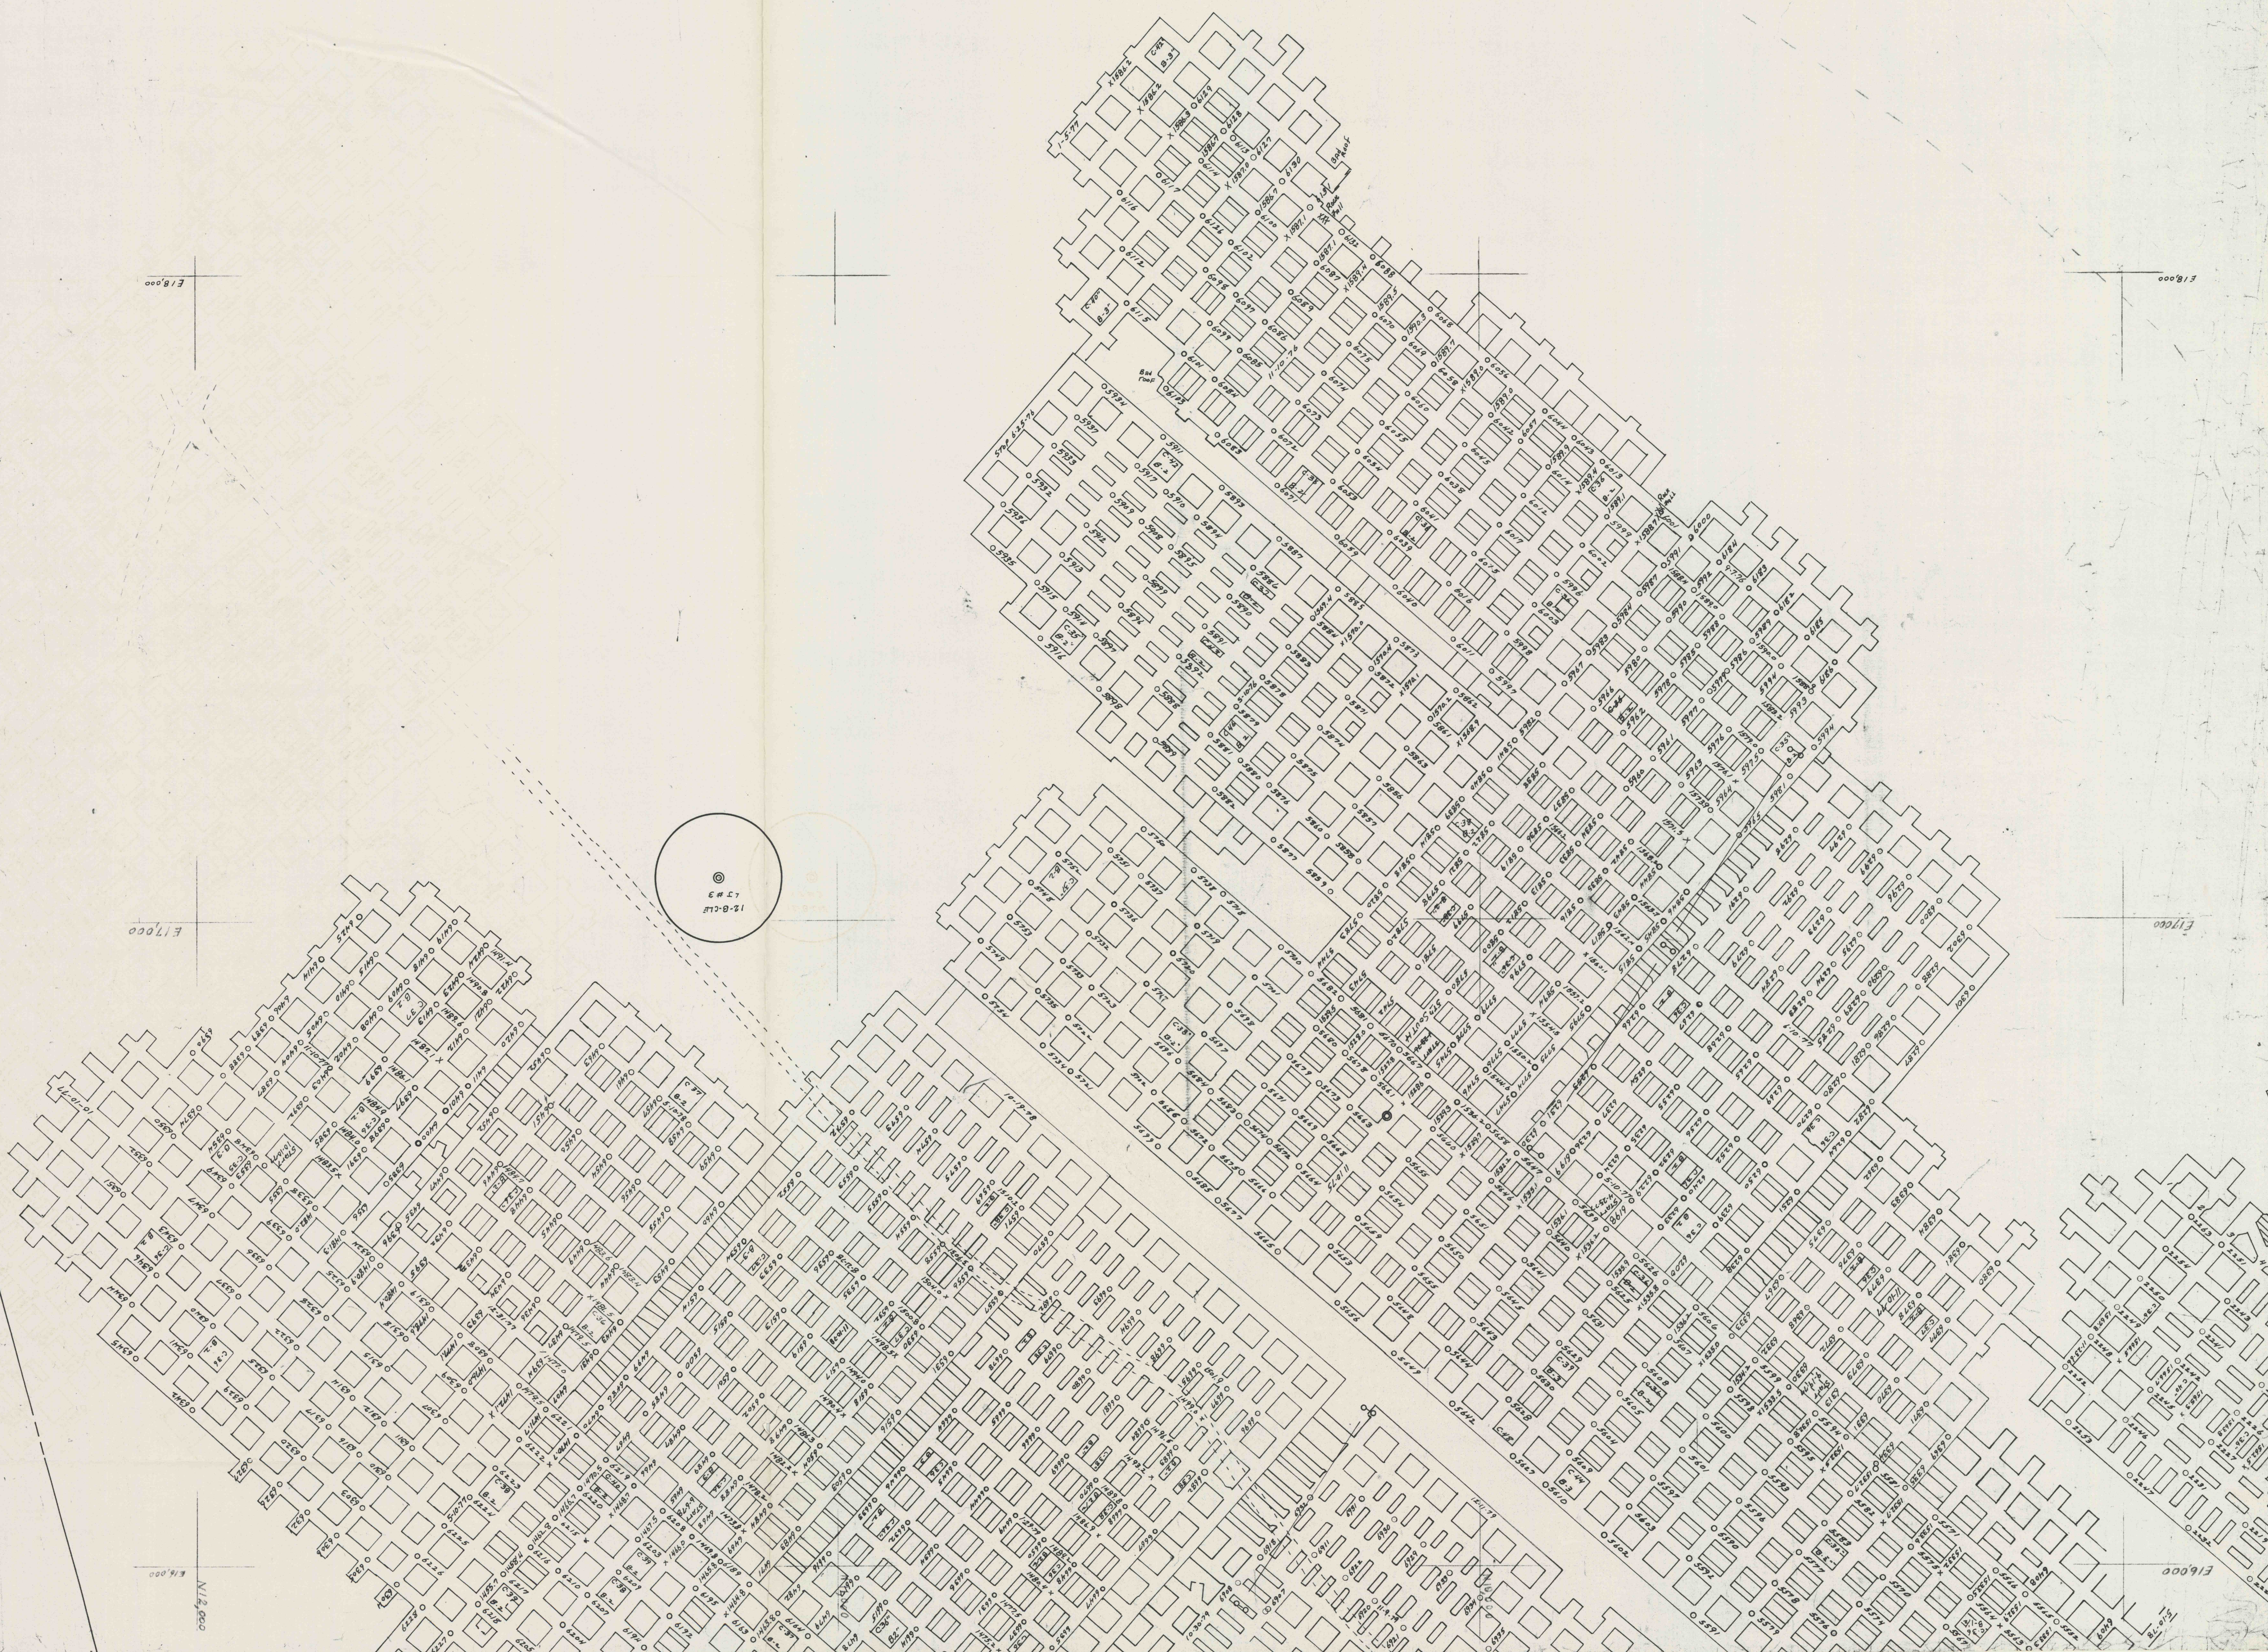

15-B-2-14
L 3 # 3

N 12,000
E 17,000

N 13,000
E 18,000

N 14,000
E 19,000

N 13,000
E 18,000

E 18,000

E 19,000

E 17,000

E 17,000

N 12,000
E 16,000

E 16,000