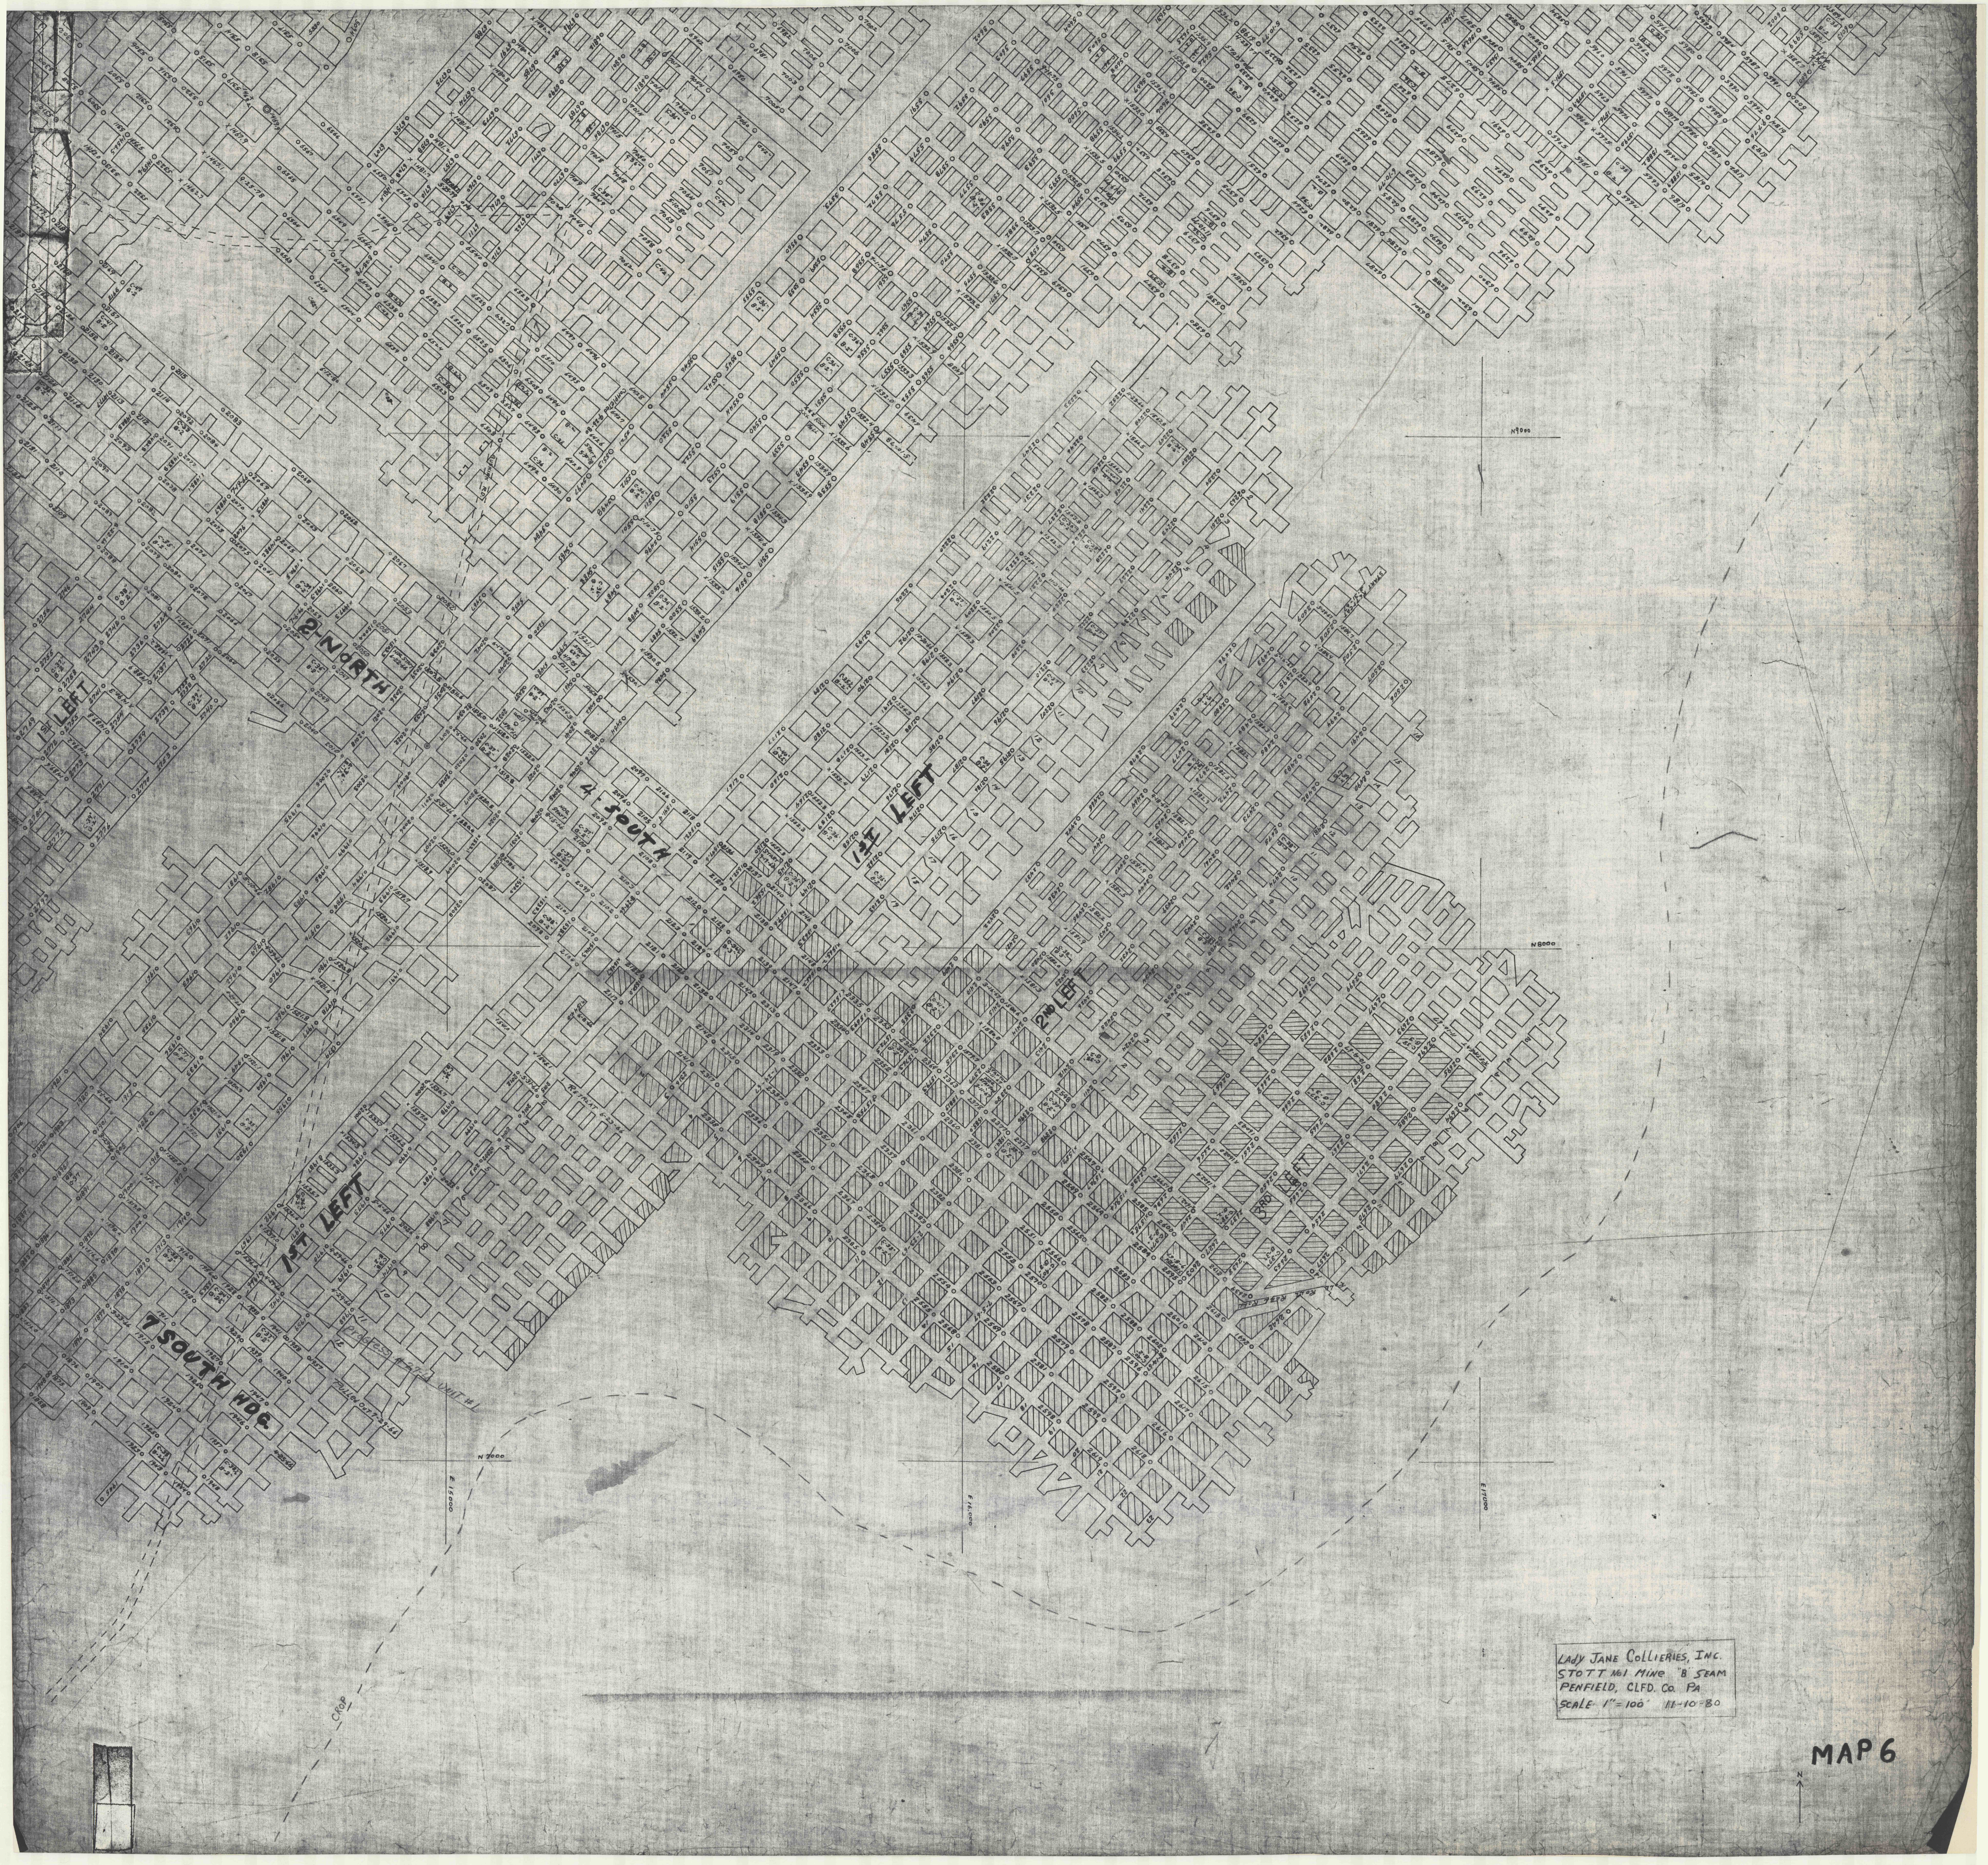
1ST LEFT
2-NORTH
4 SOUTH
1ST LEFT
2ND LEFT
3RD LEFT
1ST LEFT
7 SOUTH HDG.
Progress #2 to UNIT #1
Pulled Out 7-29-66
RETREAT 6-23-66
N9000
N8000
N7000
E15000
E16,000
E17000
CROP
N

LADY JANE COLLIERIES, INC.
STOTT No.1 MINE "B" SEAM
PENFIELD, CLFD. Co. PA
SCALE 1" = 100' 11-10-80

MAP 6