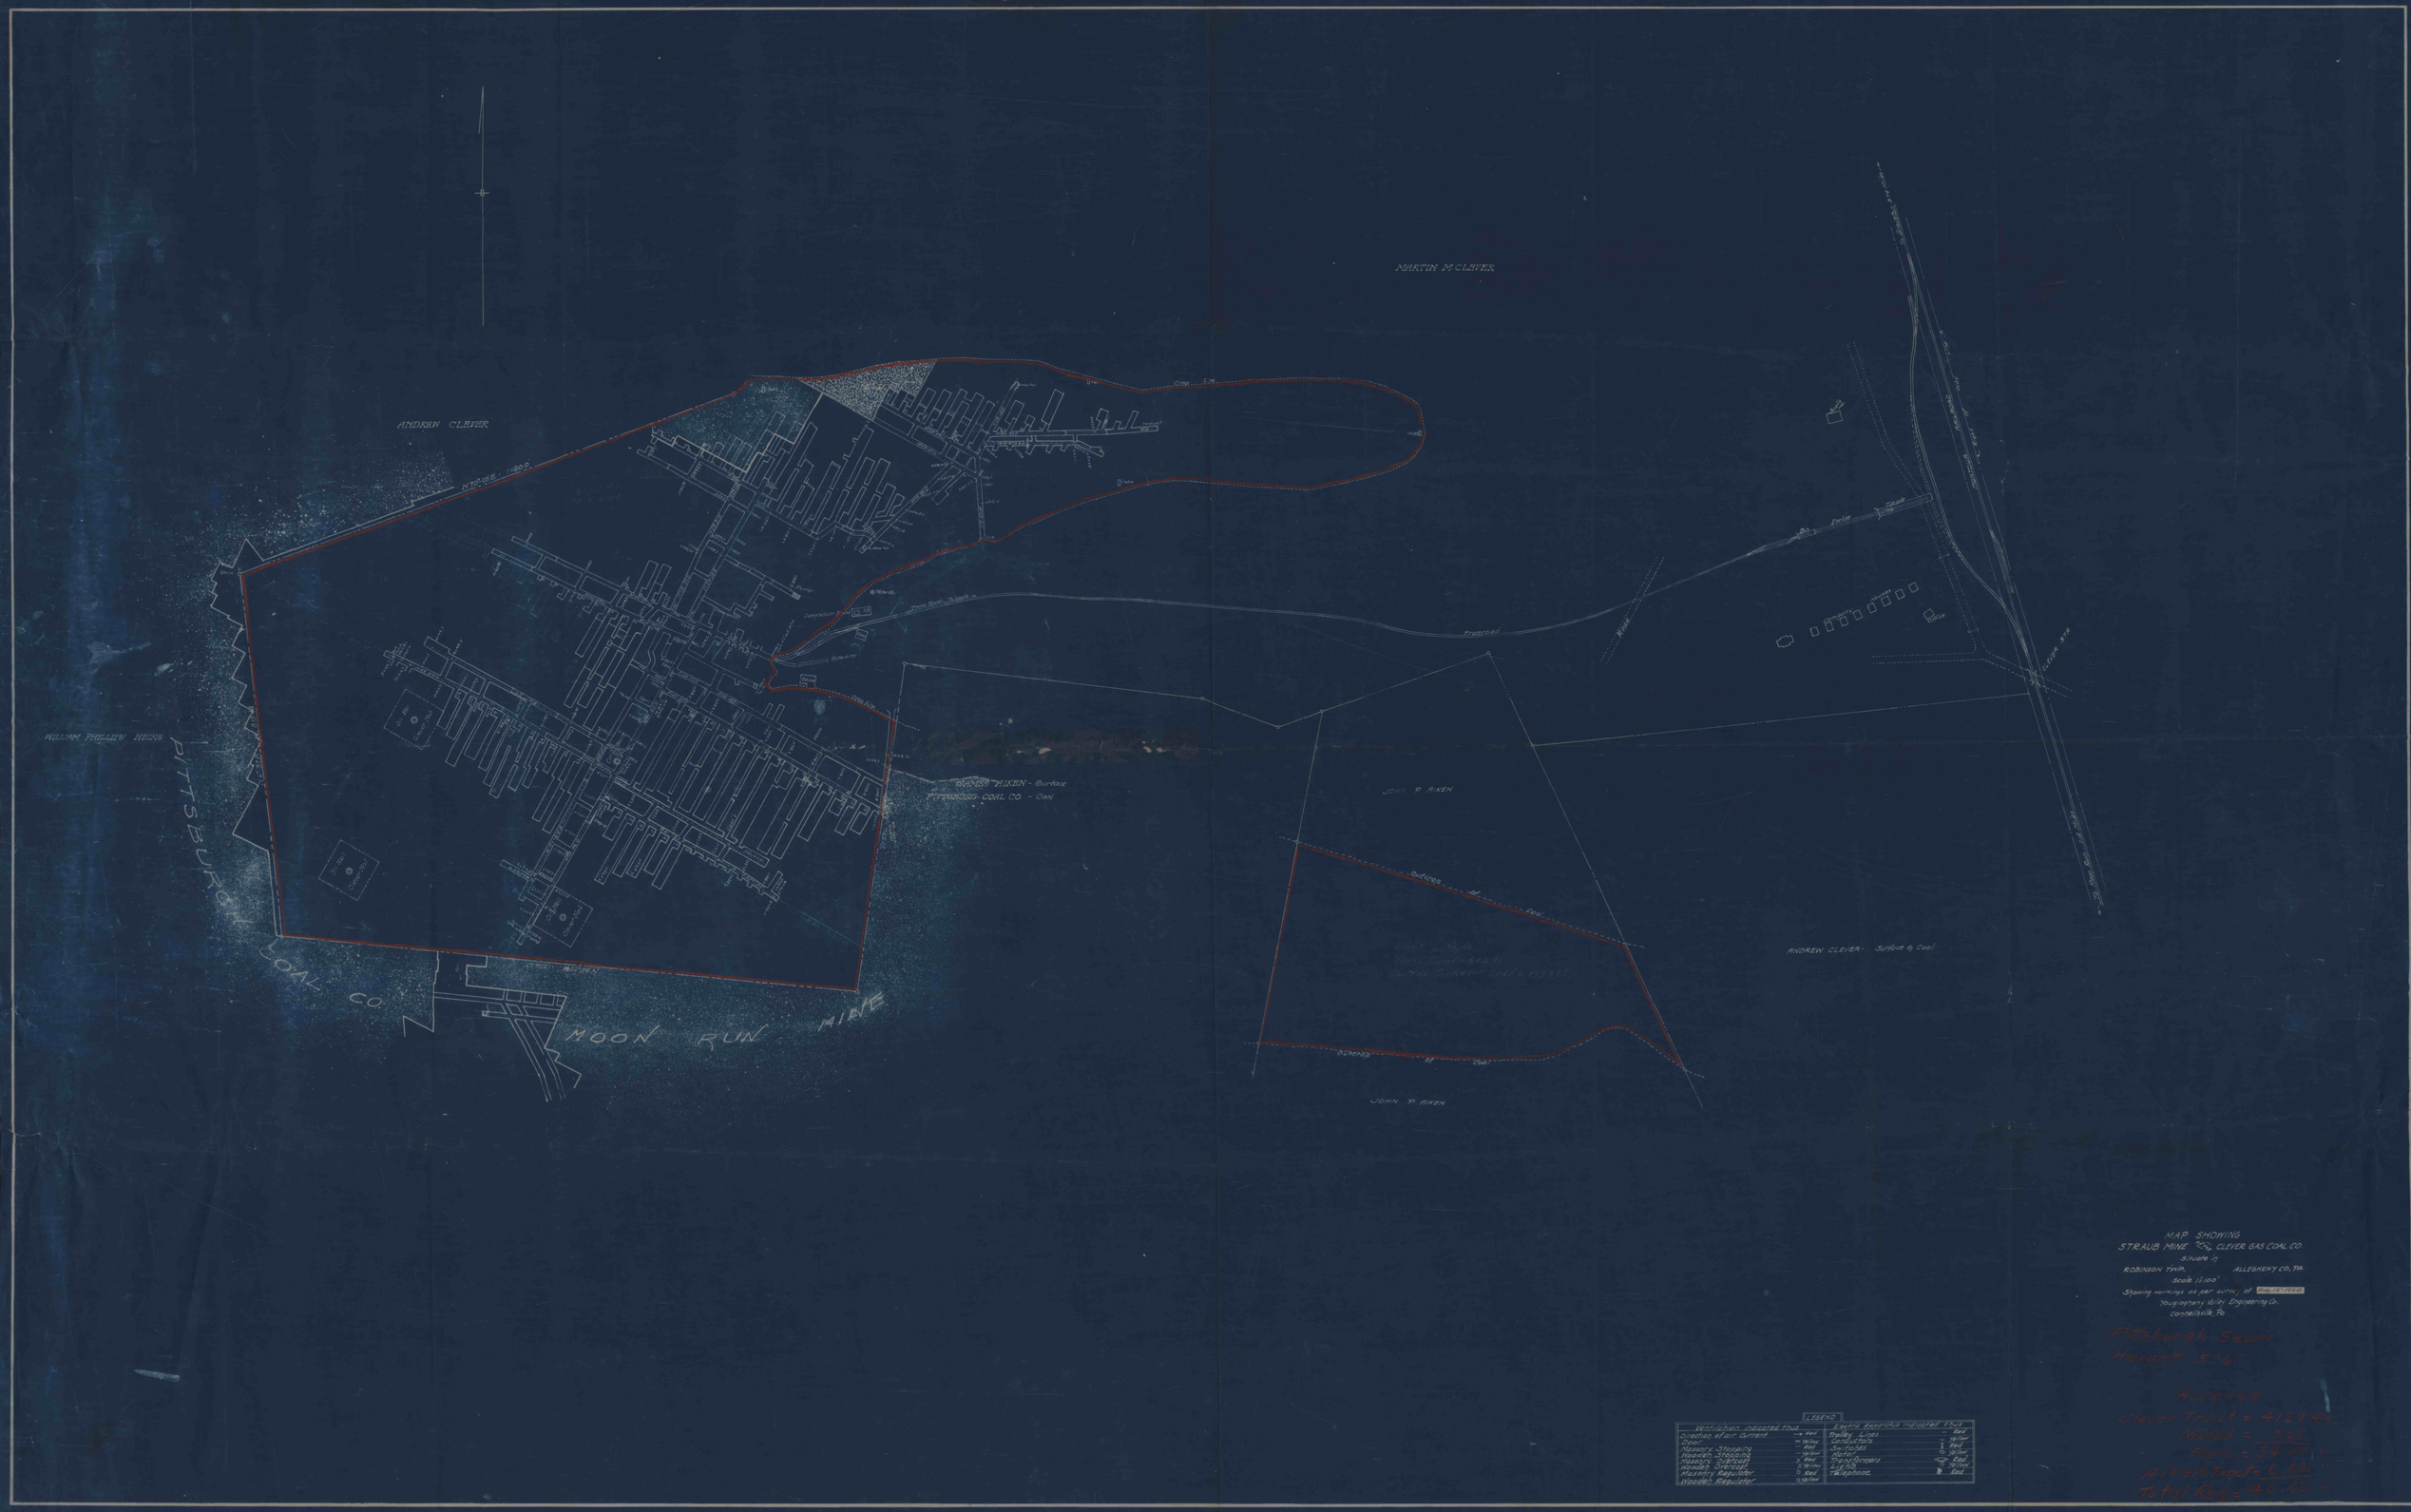
MARTIN M. CLEVER
ANDREW CLEVER
N 70° 0' E - 11800
WILLIAM PHILLIPS' HEIRS
PITTSBURGH COAL CO.
MOON RUN MINE
GAMES AIKEN - Surface
PITTSBURGH COAL CO. - Coal
Tramroad
JOHN P. AIKEN
Outcrop of Coal
ANDREW CLEVER - Surface & Coal
Outcrop of Coal
JOHN P. AIKEN
MAP SHOWING
STRAUB MINE of CLEVER GAS COAL CO.
Situate in
ROBINSON TWP. ALLEGHENY CO., PA.
Scale 1"=100'
Showing workings as per survey of
Youghiogheny Valley Engineering Co.
Connellsville, Pa
Pittsburgh Seam
Height 5'6"
LEGEND
Ventilation indicated thus
Direction of air Current → Red
Door ⊸ Yellow
Masonry Stopping Red
Wooden Stopping Yellow
Masonry Overcast X Red
Wooden Overcast X Yellow
Masonry Regulator ○ Red
Wooden Regulator ○ Yellow
Electric Apparatus indicated thus
Trolley Lines — Red
Conductors — Yellow
Switches Yellow
Motor Yellow
Transformers Red
Lights Yellow
Telephone Red