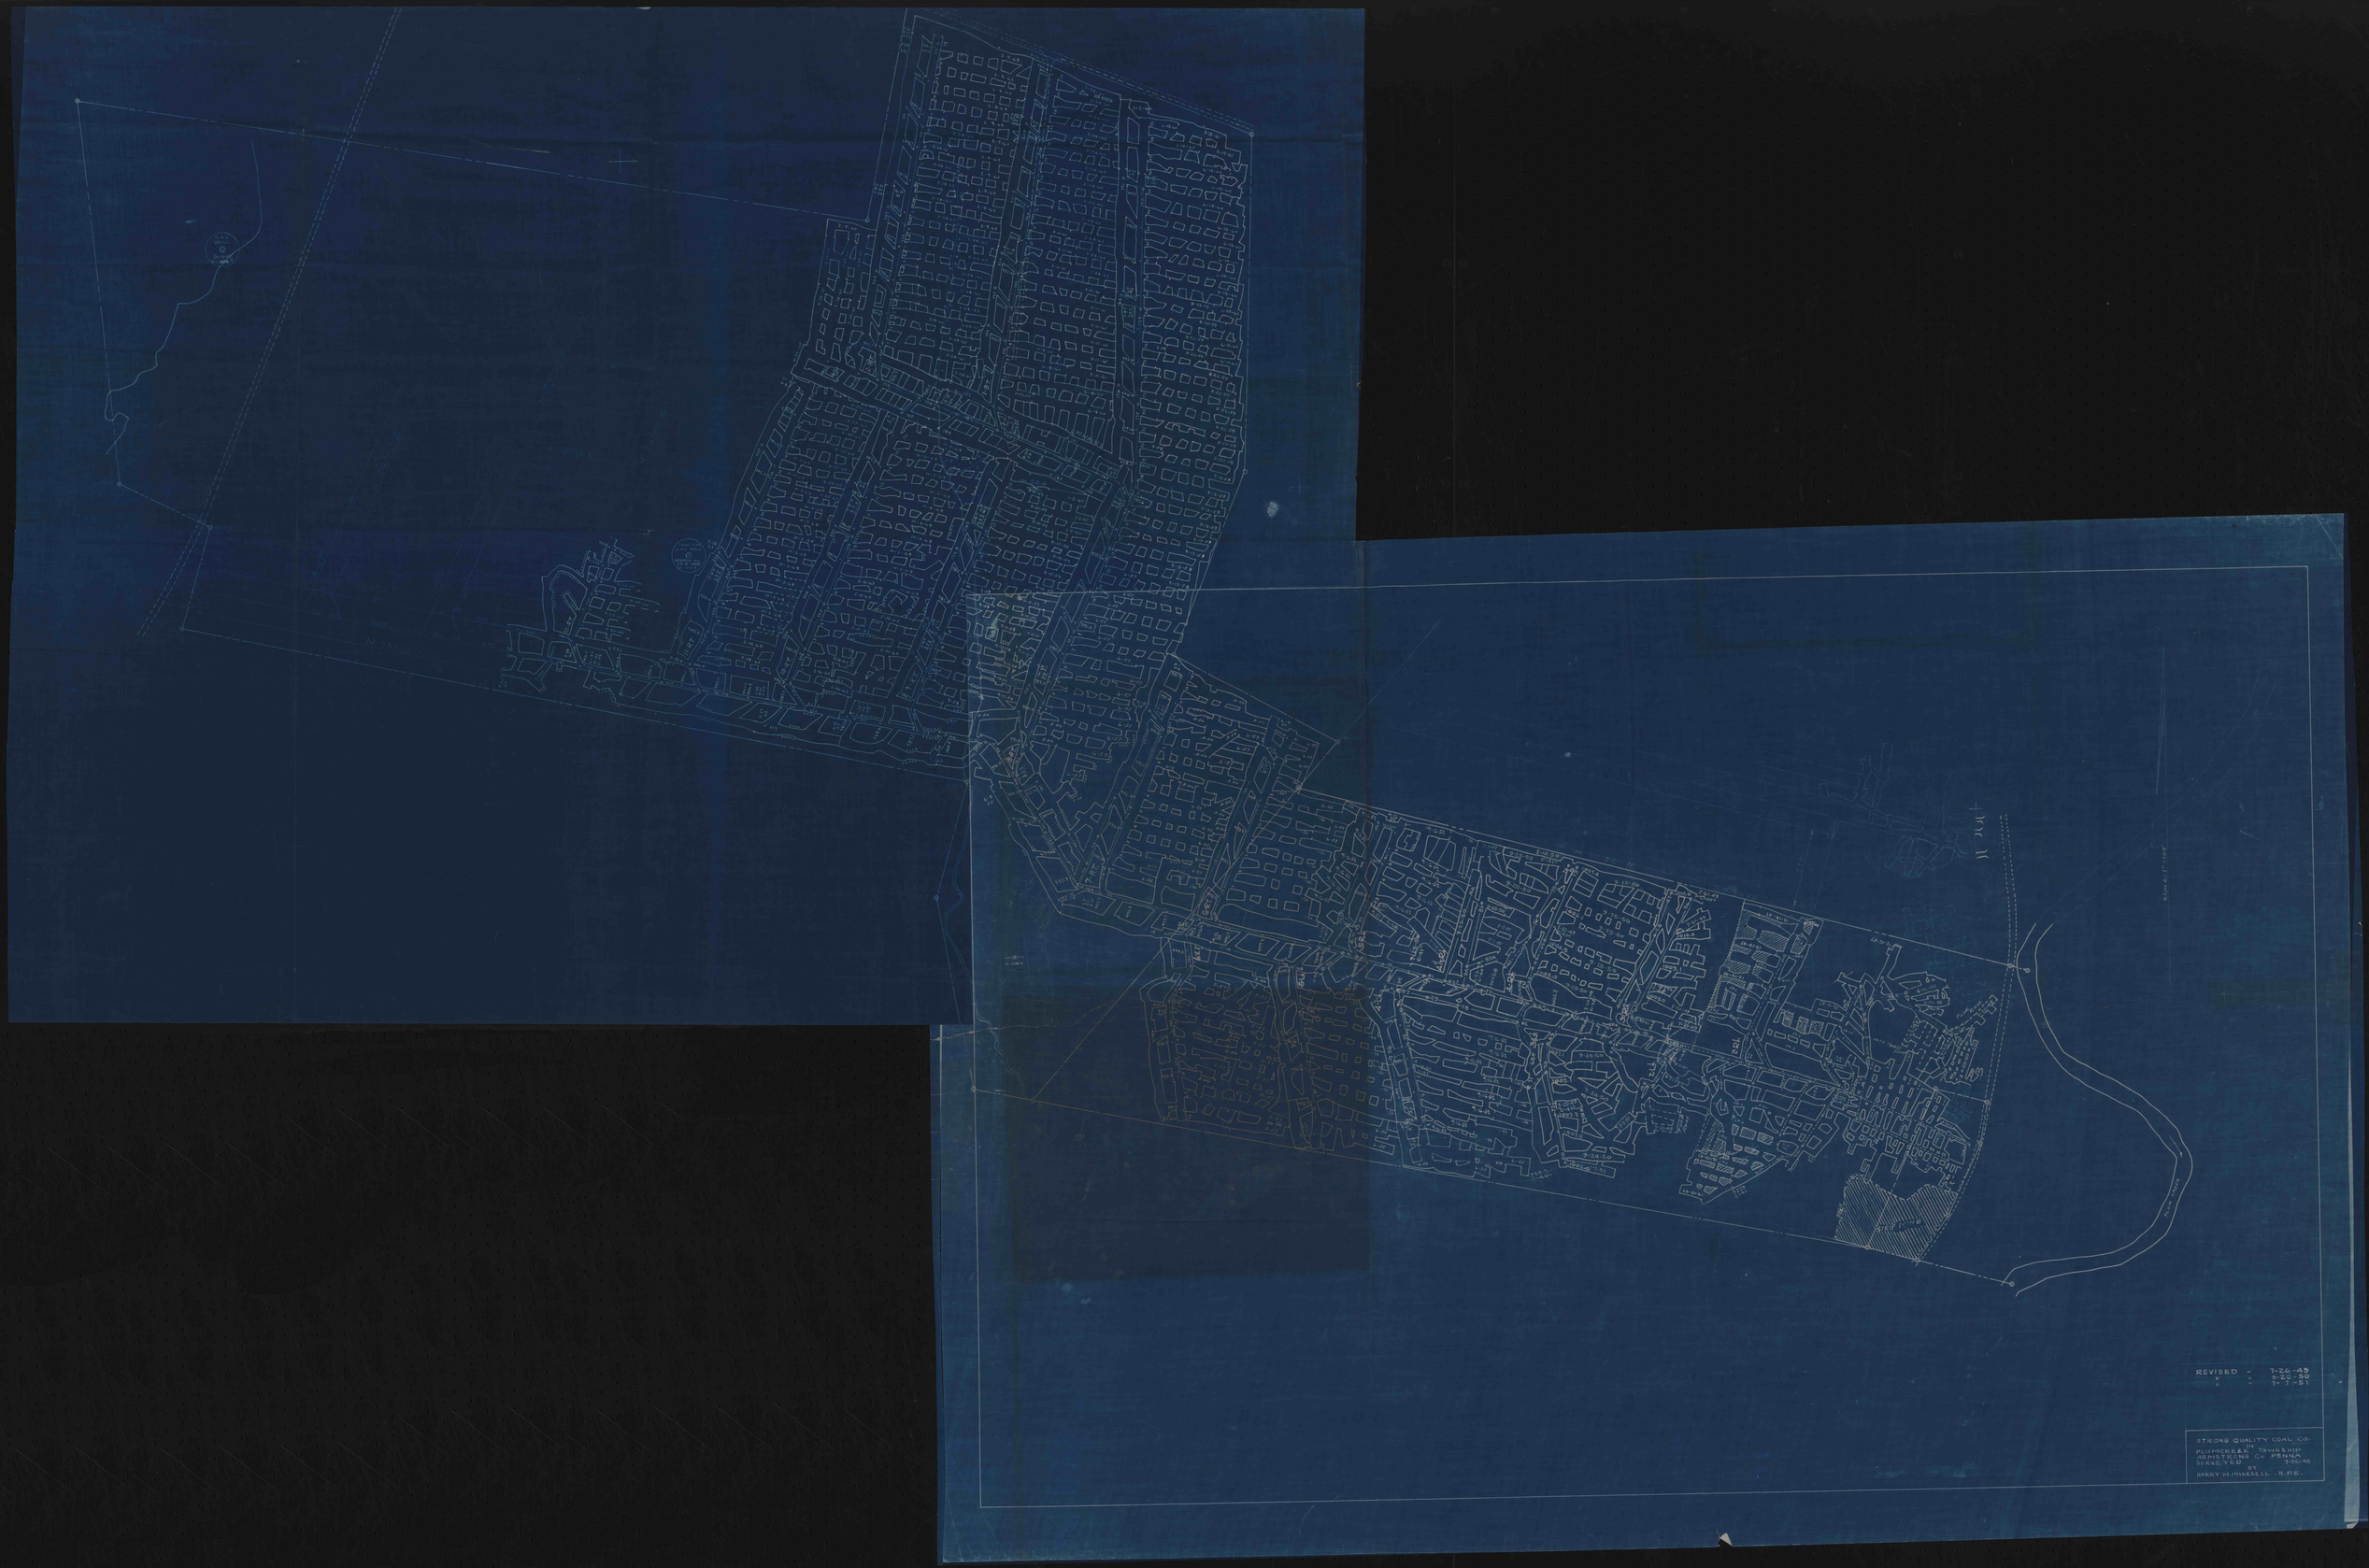
REVISED - 7-26-49
" - 7-25-50
" - 7-7-51
STRONG QUALITY COAL CO.
PLUMMER & N TOWNSHIP
ARMSTRONG Co PENNA
SURVEYED 7-26-45
BY
HARRY W. MISSELL - R.P.E.