MAP OF COAL MINE

OF THE

BUTLER COAL MINING Co.

SITUATE IN

Summit Twp. Butler Co. Pa.

Scale-1-Inch = 100 Ft.

S. J. Taylor Engr. Slippery Rock Pa.

J. Grossman
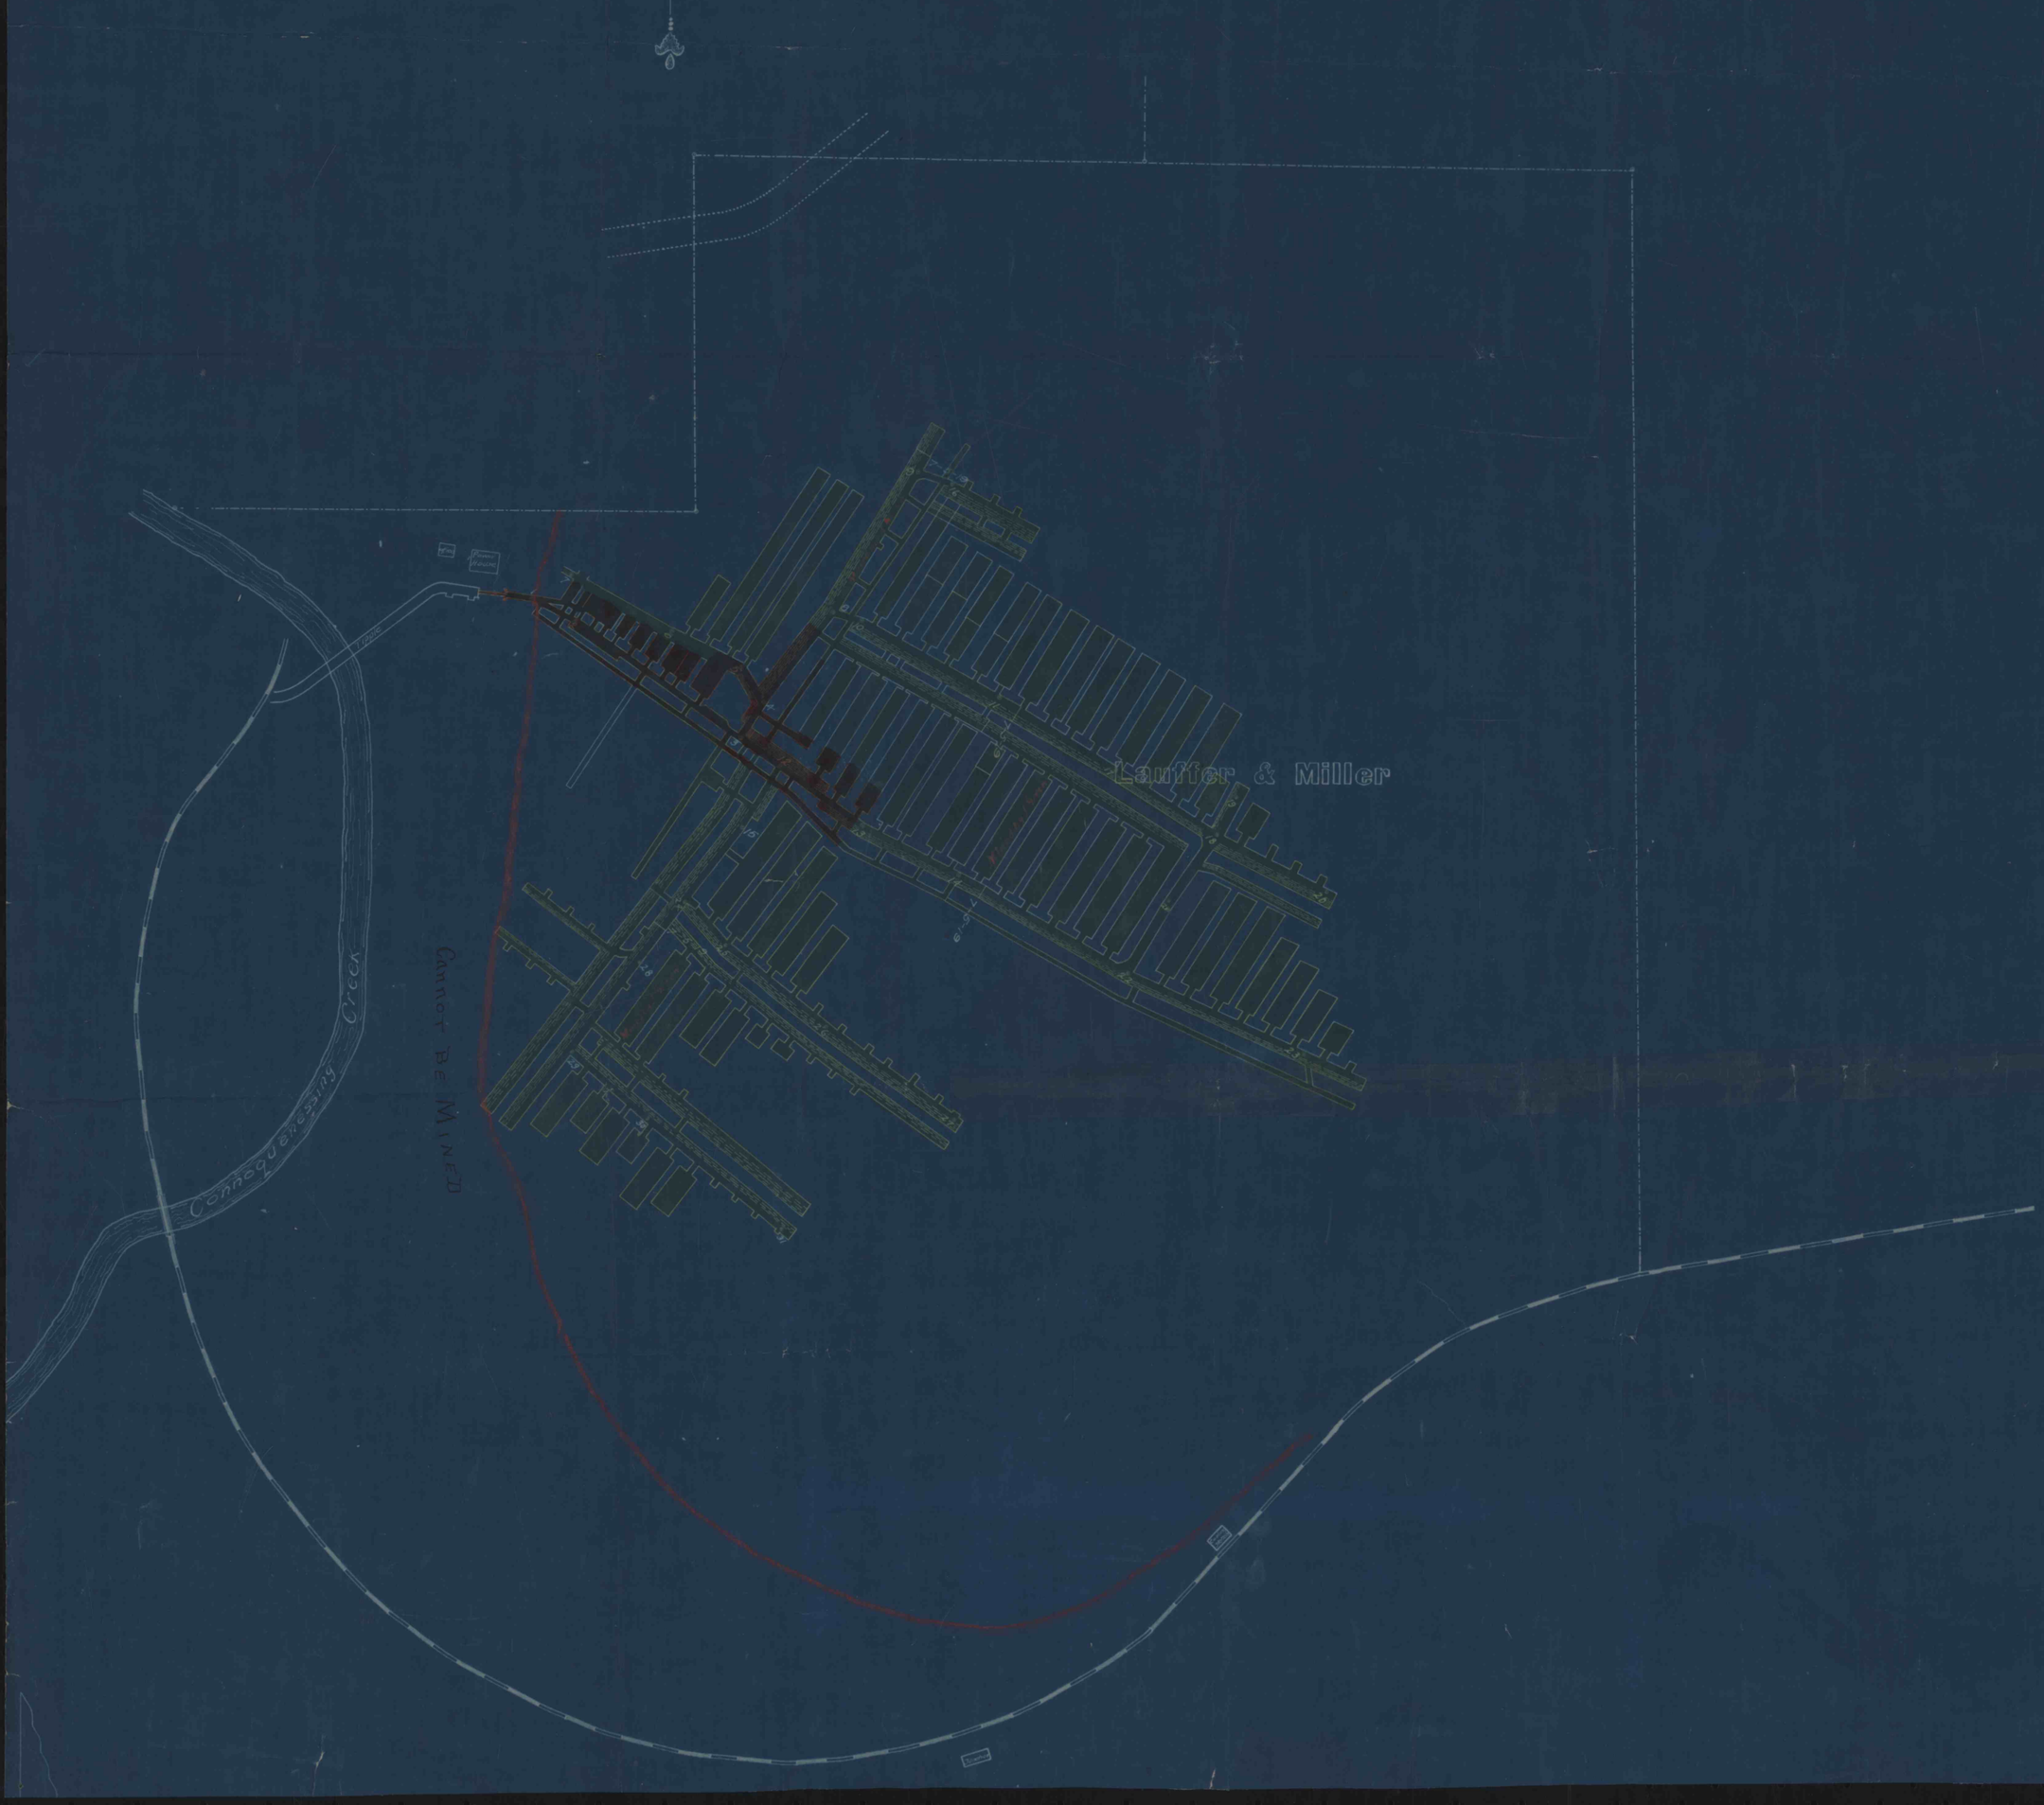
Lauffer & Miller