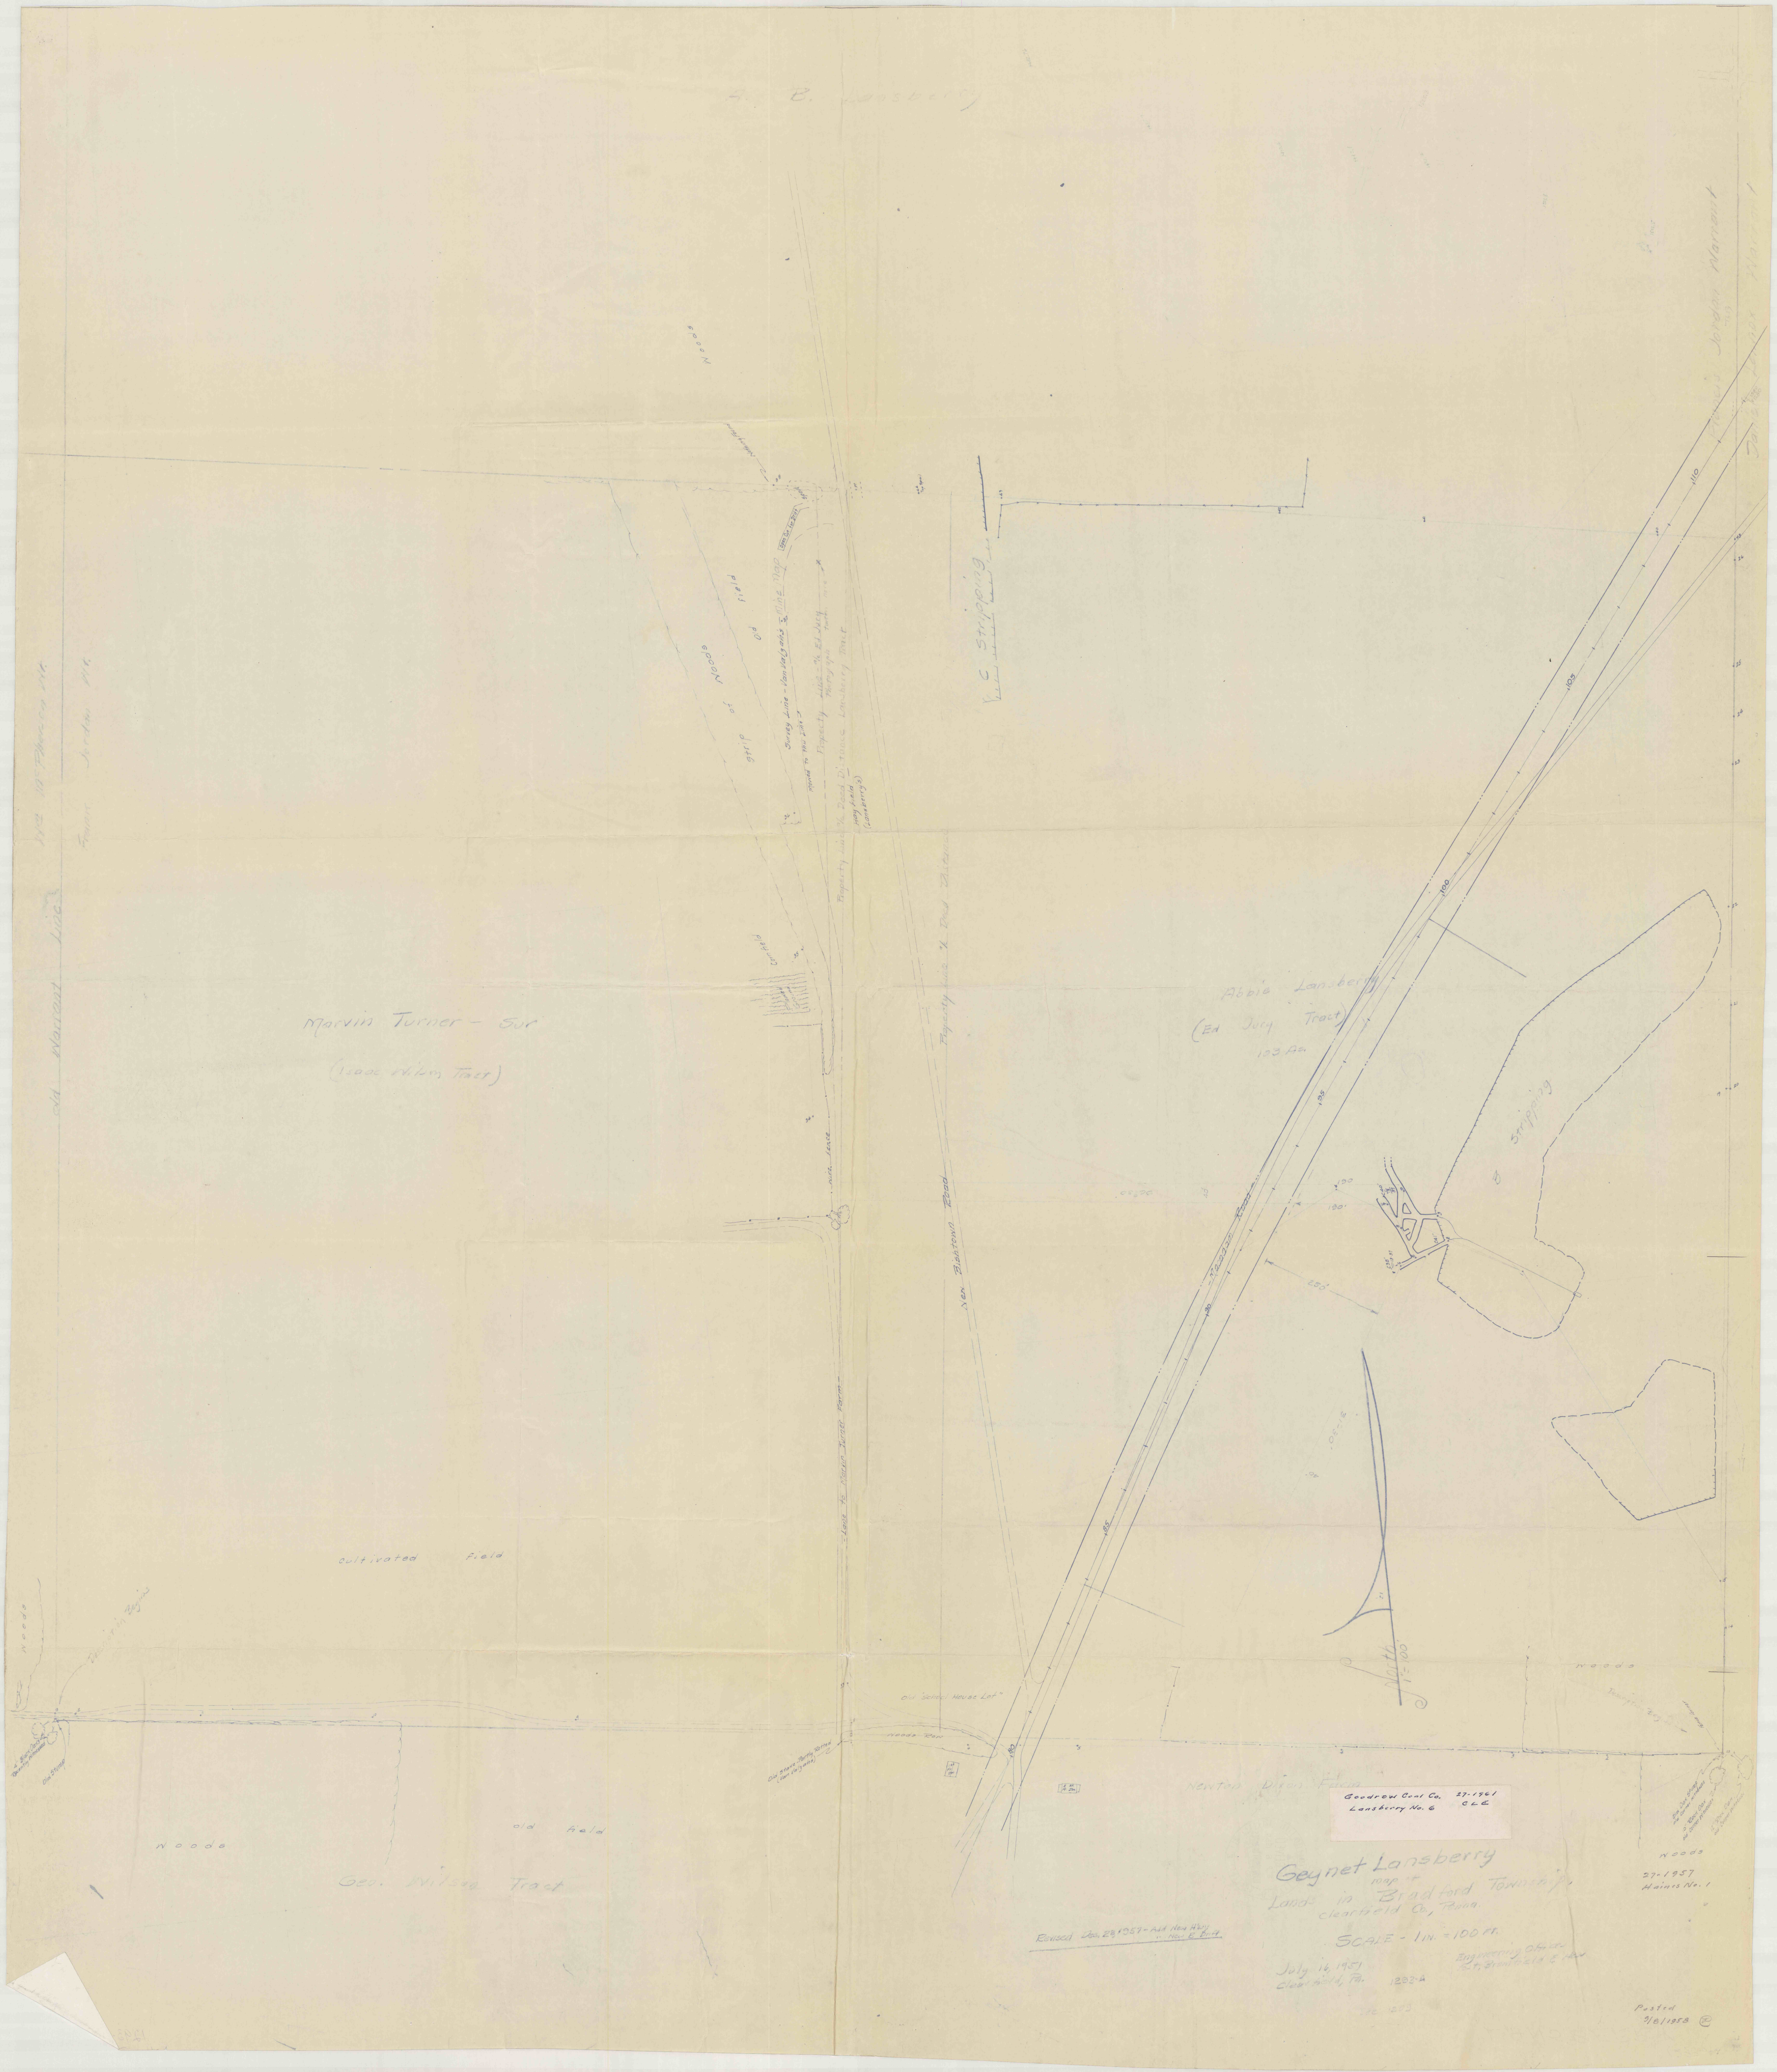
A. B. Lansberry
Old Warrant Lines
10½ Pherson Wt.
Fran. Jordan Wt.
Francis Jordan Warrant
Daniel Lennox Warrant
Woods
Nothing Found
Open Cut for Drift
Spoil
Survey Line - Van Valzahs ½ Mine Map
Moved to this Line
Property Line - ½ Ed Jury Photograph taken here
Property Line ½ Deed Distance Lansberry Tract
Hay field (Lansberry's)
Property Line ½ Deed Distance
strip of Woods
old field
Corn field
Plowed Ground
Wire Fence
Lane to Marvin Turner Farm
New Bishtown Road
Narrows Road
E C Stripping
Stripping
Marvin Turner - Sur
(Isaac Wilson Tract)
Abbie Lansberry
(Ed Jury Tract)
103 As.
cultivated field
Description Begins
4" Black Oaks Recently Witnessed
Old Stump
Old Stake Partly Rotted (Van Valzahs)
Old "School House Lot"
Woods Row
Woods
old field
Geo. Wilson Tract
Newton Dixon Farm
North 1" = 100'
250'
Old Oak Stump old corner witnesses
6" Rock Oak old corner witnesses
12" Rock Oak old corner witnesses
Goodrow Coal Co. 27-1961
Lansberry No. 6 CLE
Geynet Lansberry
map of
Lands in Bradford Township
Clearfield Co., Penna.
SCALE - 1 IN. = 100 FT.
July 16, 1951
Clearfield, Pa.
1282-A
Engineering Offices
R. T. Bromfield & Hess
Revised Dec. 28, 1957 - Add New H'wy .. New B Drift
27-1957
Haines No. 1
Posted
9/8/1958