


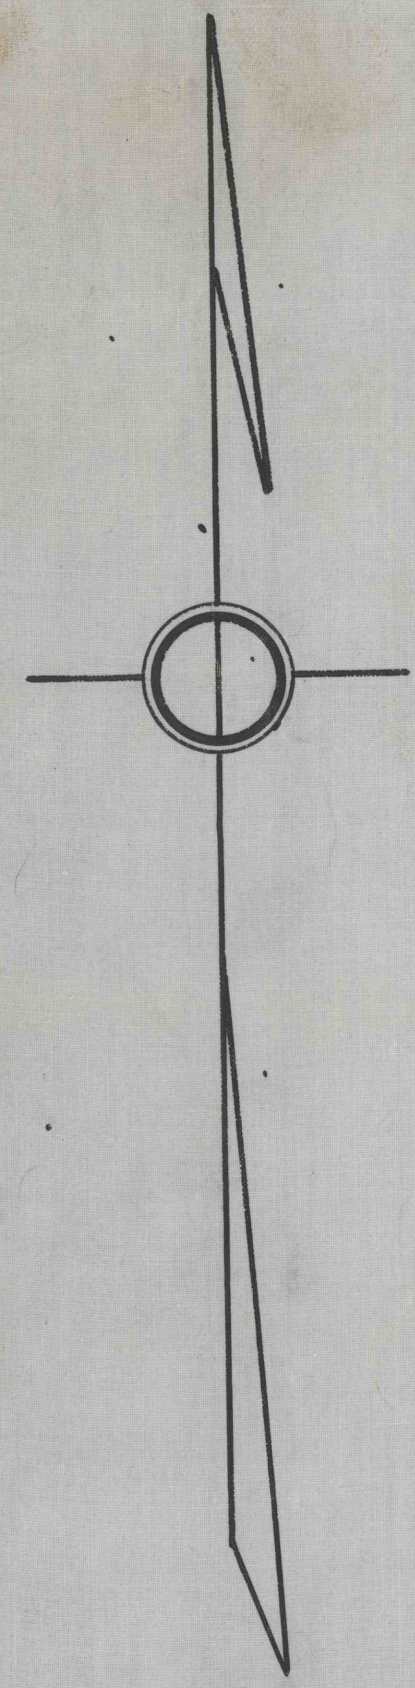

Markle-Bullers

Jacob Dinger

Wm Shaffer

Wm Shaffer

J. Dinger

Caylor

Dora Coal Company

E. Dinger

Ralph Shaffer

Caylor

Markle-Bullers

Old workings

Lower Williams Fork

P & S RR

to Brookville

Markle-Bullers Coal Company
Sunnyside Mine Number One
Kinggold Township Jefferson Co Pa
Scale 1"=100' February 1931
Abandoned January 1931

I, John R. Shaffer, hereby certify that this tracing
is a true and correct copy of the original map
of Sunnyside Mine, Markle-Bullers Coal Co.
Markle-Bullers Coal Co. Kinggold Township
Jefferson County Penn.
John R. Shaffer C.E.

Approved by John R. Shaffer, Chief Engineer
Markle-Bullers Coal Co. Inc.
4-1-1931

87051E#